PARENT PARCEL: 16-00-083-000-001 & 16-00-084-000-001

CHILD PARCEL: 16-00-083-000-002 THRU -009 & 16-00-084-000-022 THRU -025

STARTING POINT: INTERSECTION OF C/LS OF NEFF RD & MENNELL RD

21-04374

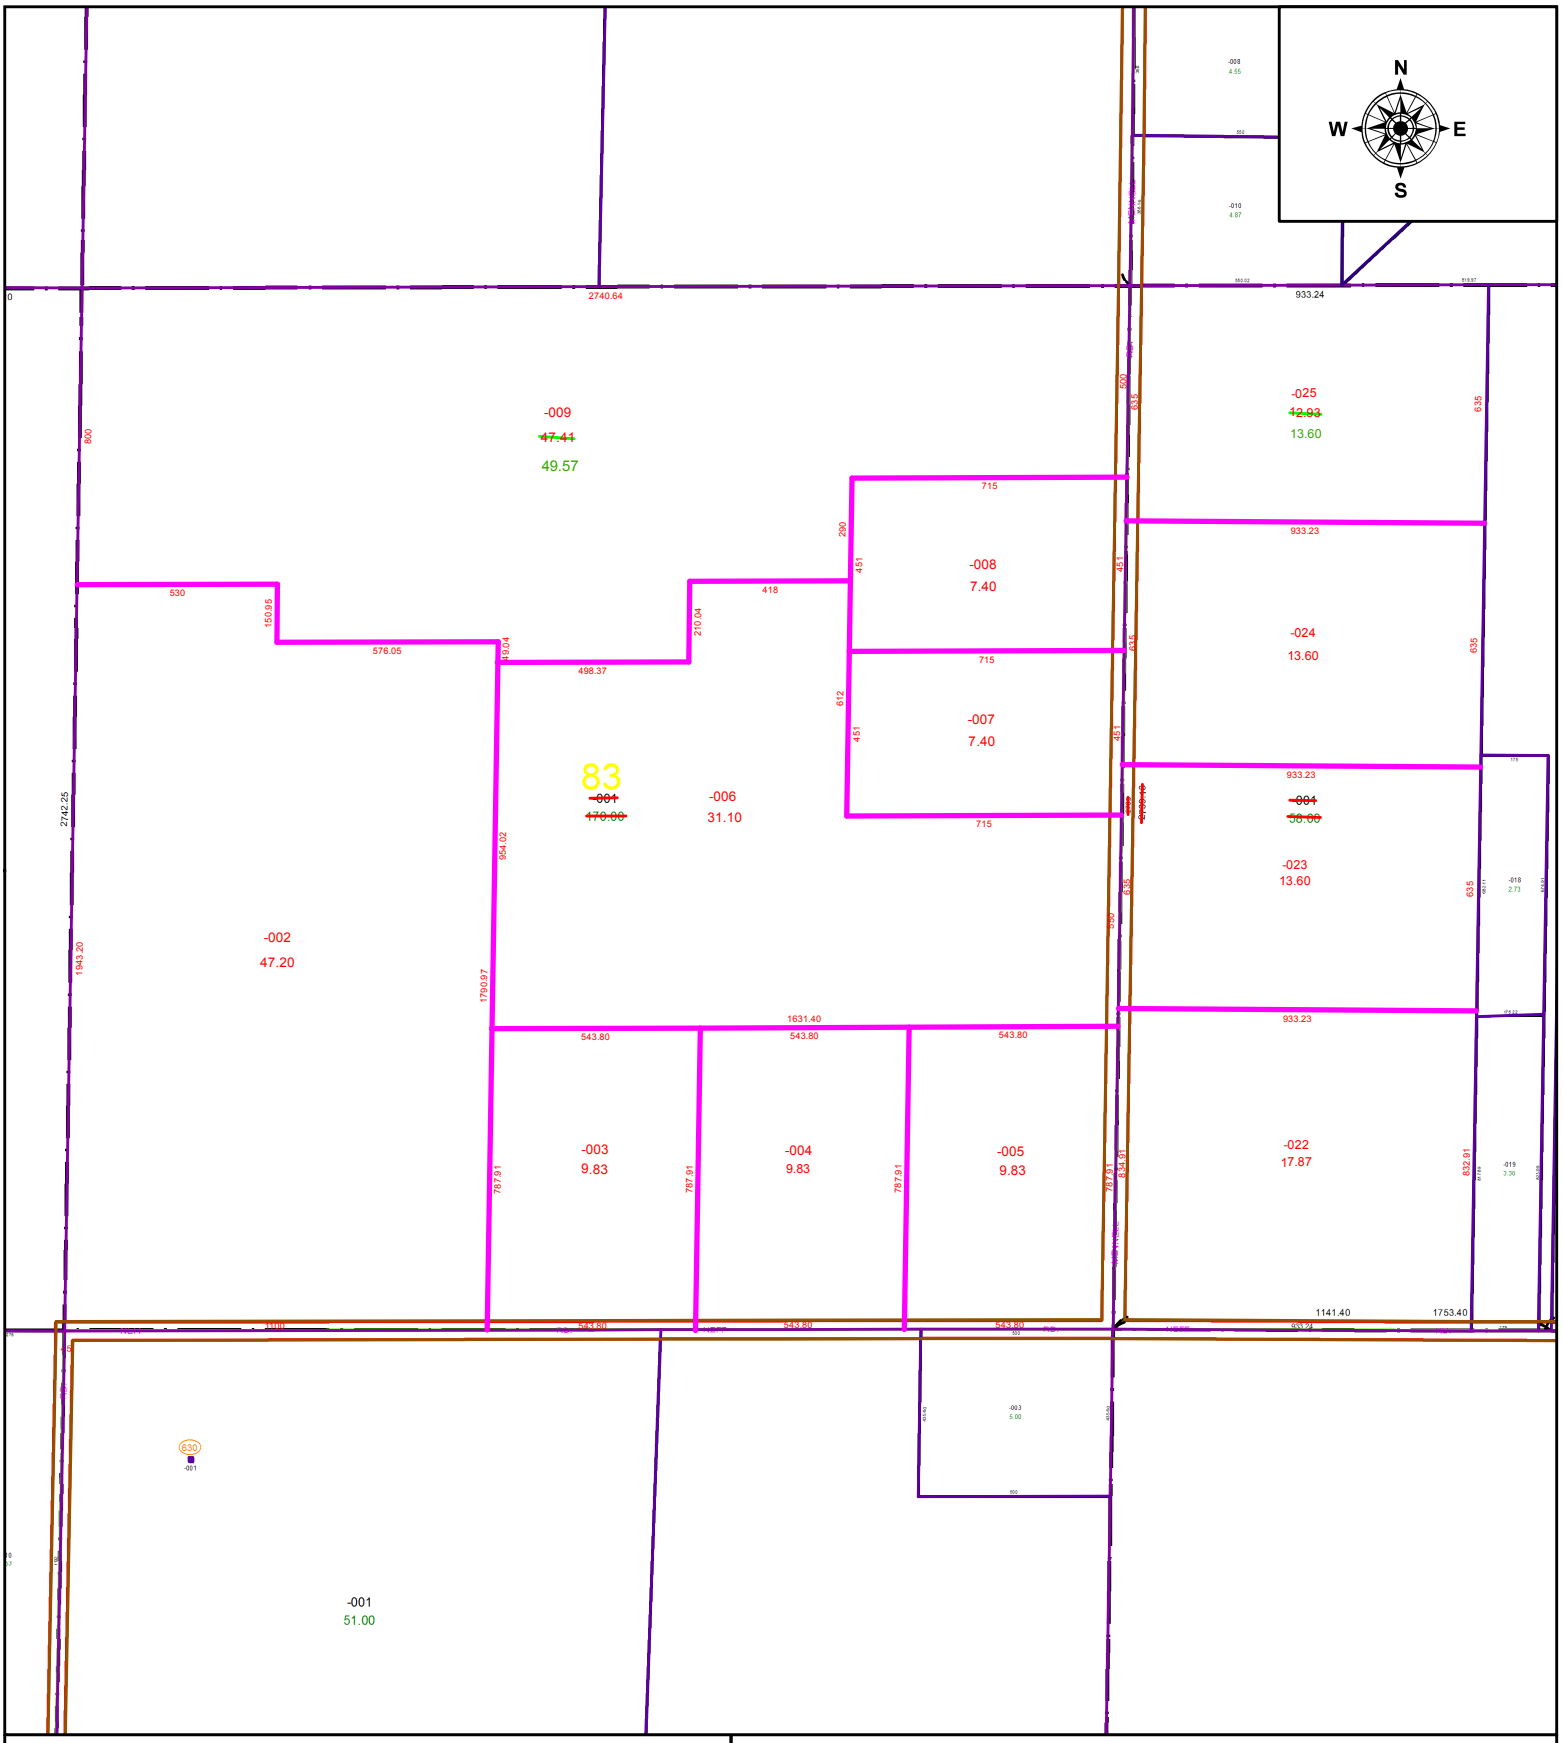

SPLITS/DEEDS PROCESSED

LORAIN COUNTY TAX MAP DEPARTMENT
226 MIDDLE AVE. ELYRIA, OH

SURVEYED BY: LOUIS GIFFELS
CLOSURE: 1: 356762
MAP PAGE(S): 16-00-083
APPOVED BY: WRZ **DATE:** 9/16/2021
SCALE: 1" = 500 **PRIOR INSTRUMENT:** V. 1151 PG. 802