PARENT PARCEL: 12-00-020-101-006, 12-00-021-105-033

CHILD PARCEL: 12-00-020-101-007, -008, 12-00-021-105-034 THRU -036

STARTING POINT: C/L OF SPRAGUE AND EAST RIVER RD

21-04380

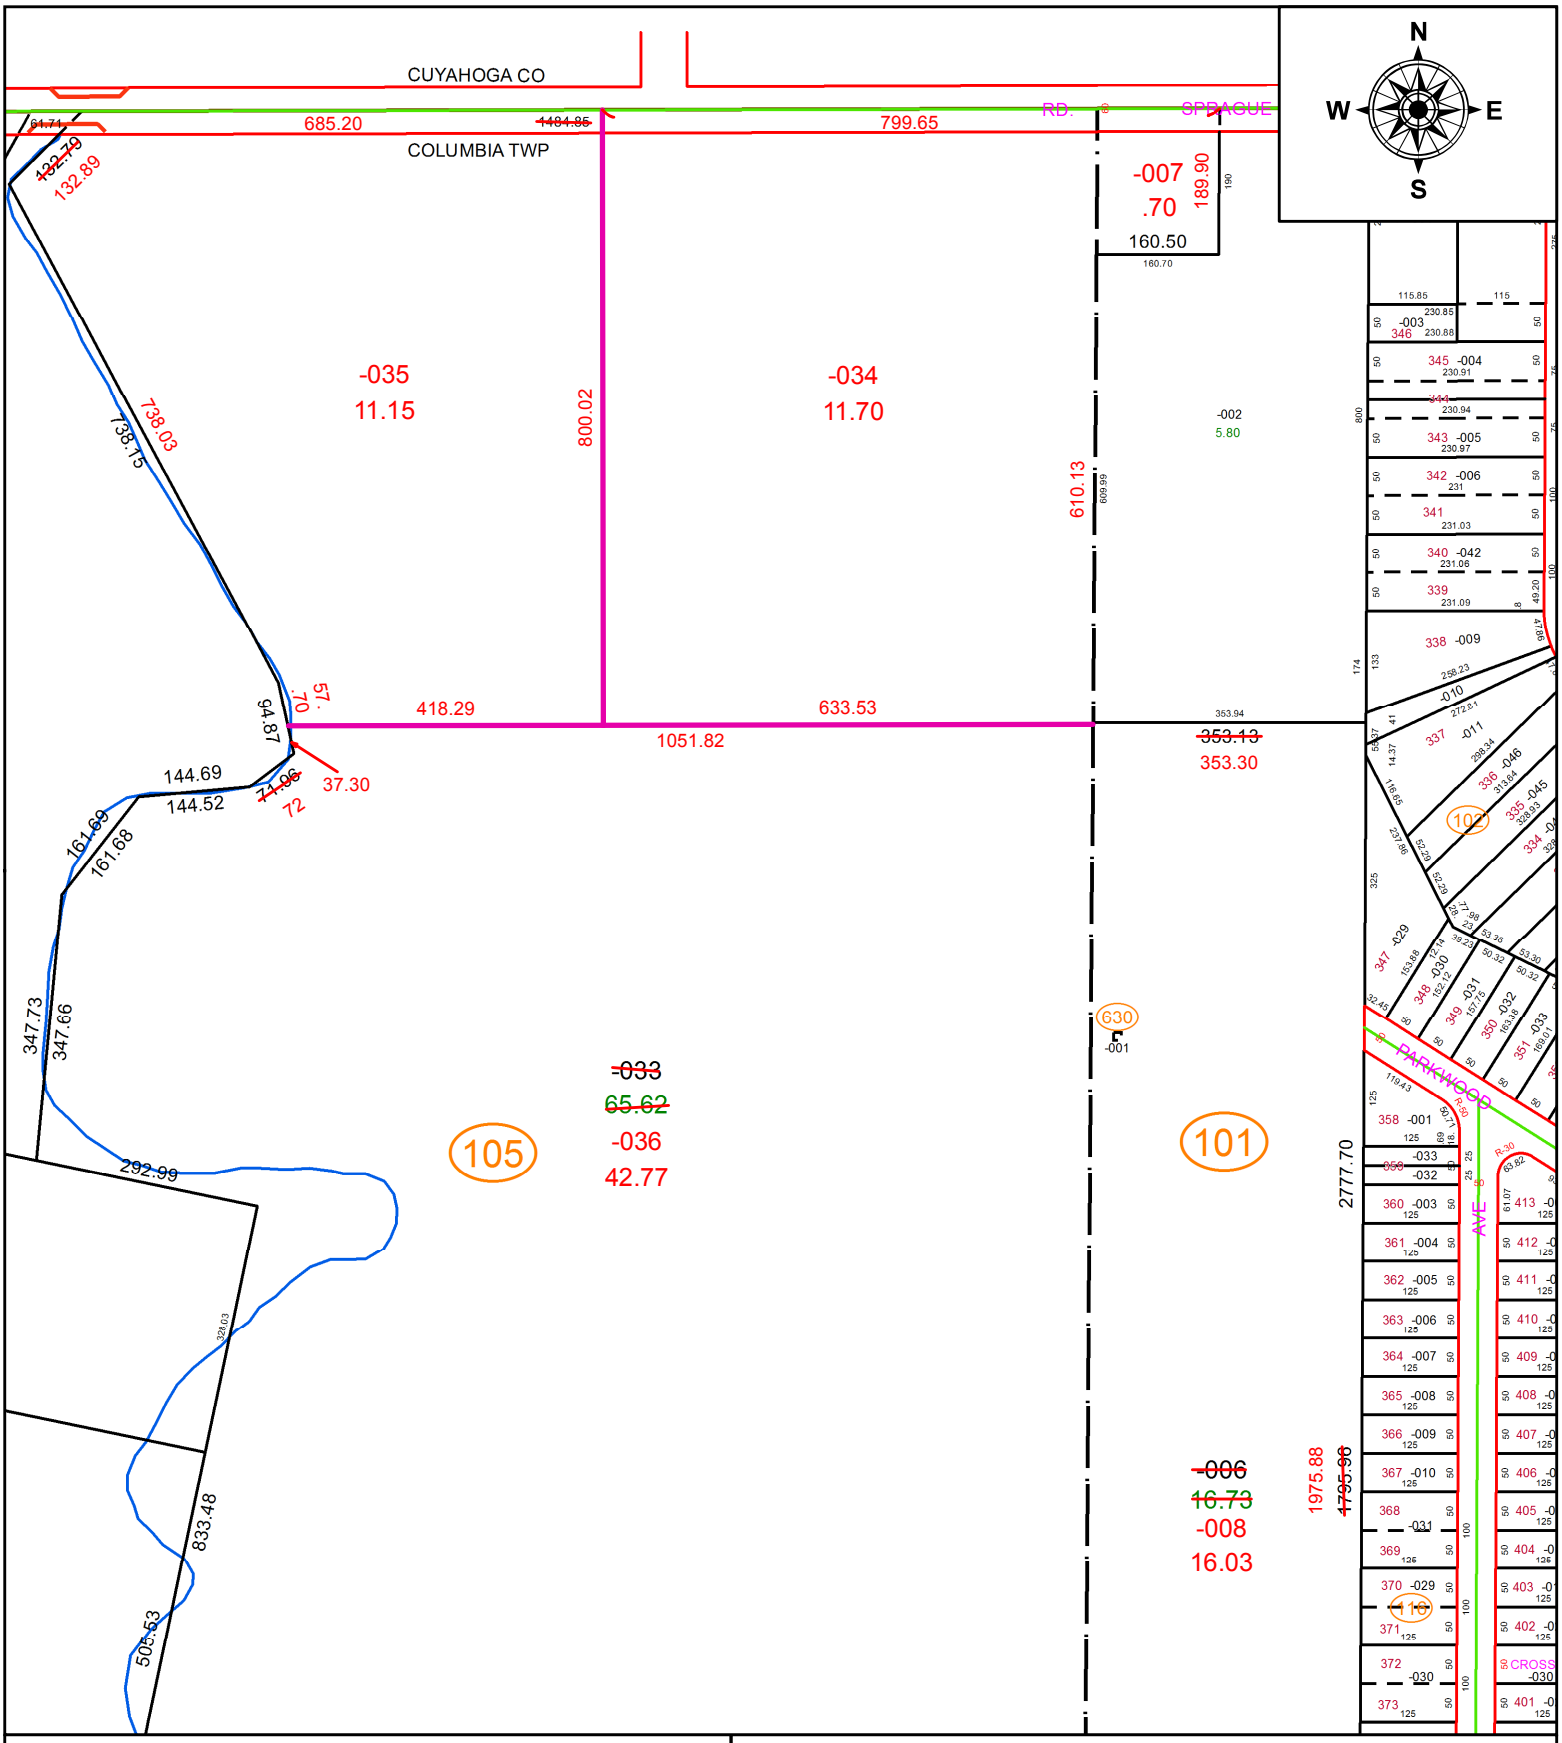

SPLITS/DEEDS PROCESSED

LORAIN COUNTY TAX MAP DEPARTMENT
226 MIDDLE AVE. ELYRIA, OH

SURVEYED BY: THOMAS J. NEFF JR.
CLOSURE: 1: 730151
MAP PAGE(S): 12-00-020 & 021
APPOVED BY: AC **DATE:** 9/28/2021
SCALE: 1" = 250 **PRIOR INSTRUMENT:** 2017- 0630527