PARENT PARCEL: 05-00-006-000-213

CHILD PARCEL:

STARTING POINT: INTERSECTION OF C/L OF OAK POINT RD. AND C/L OF MIDDLE RIDGE RD.

20-04381-D

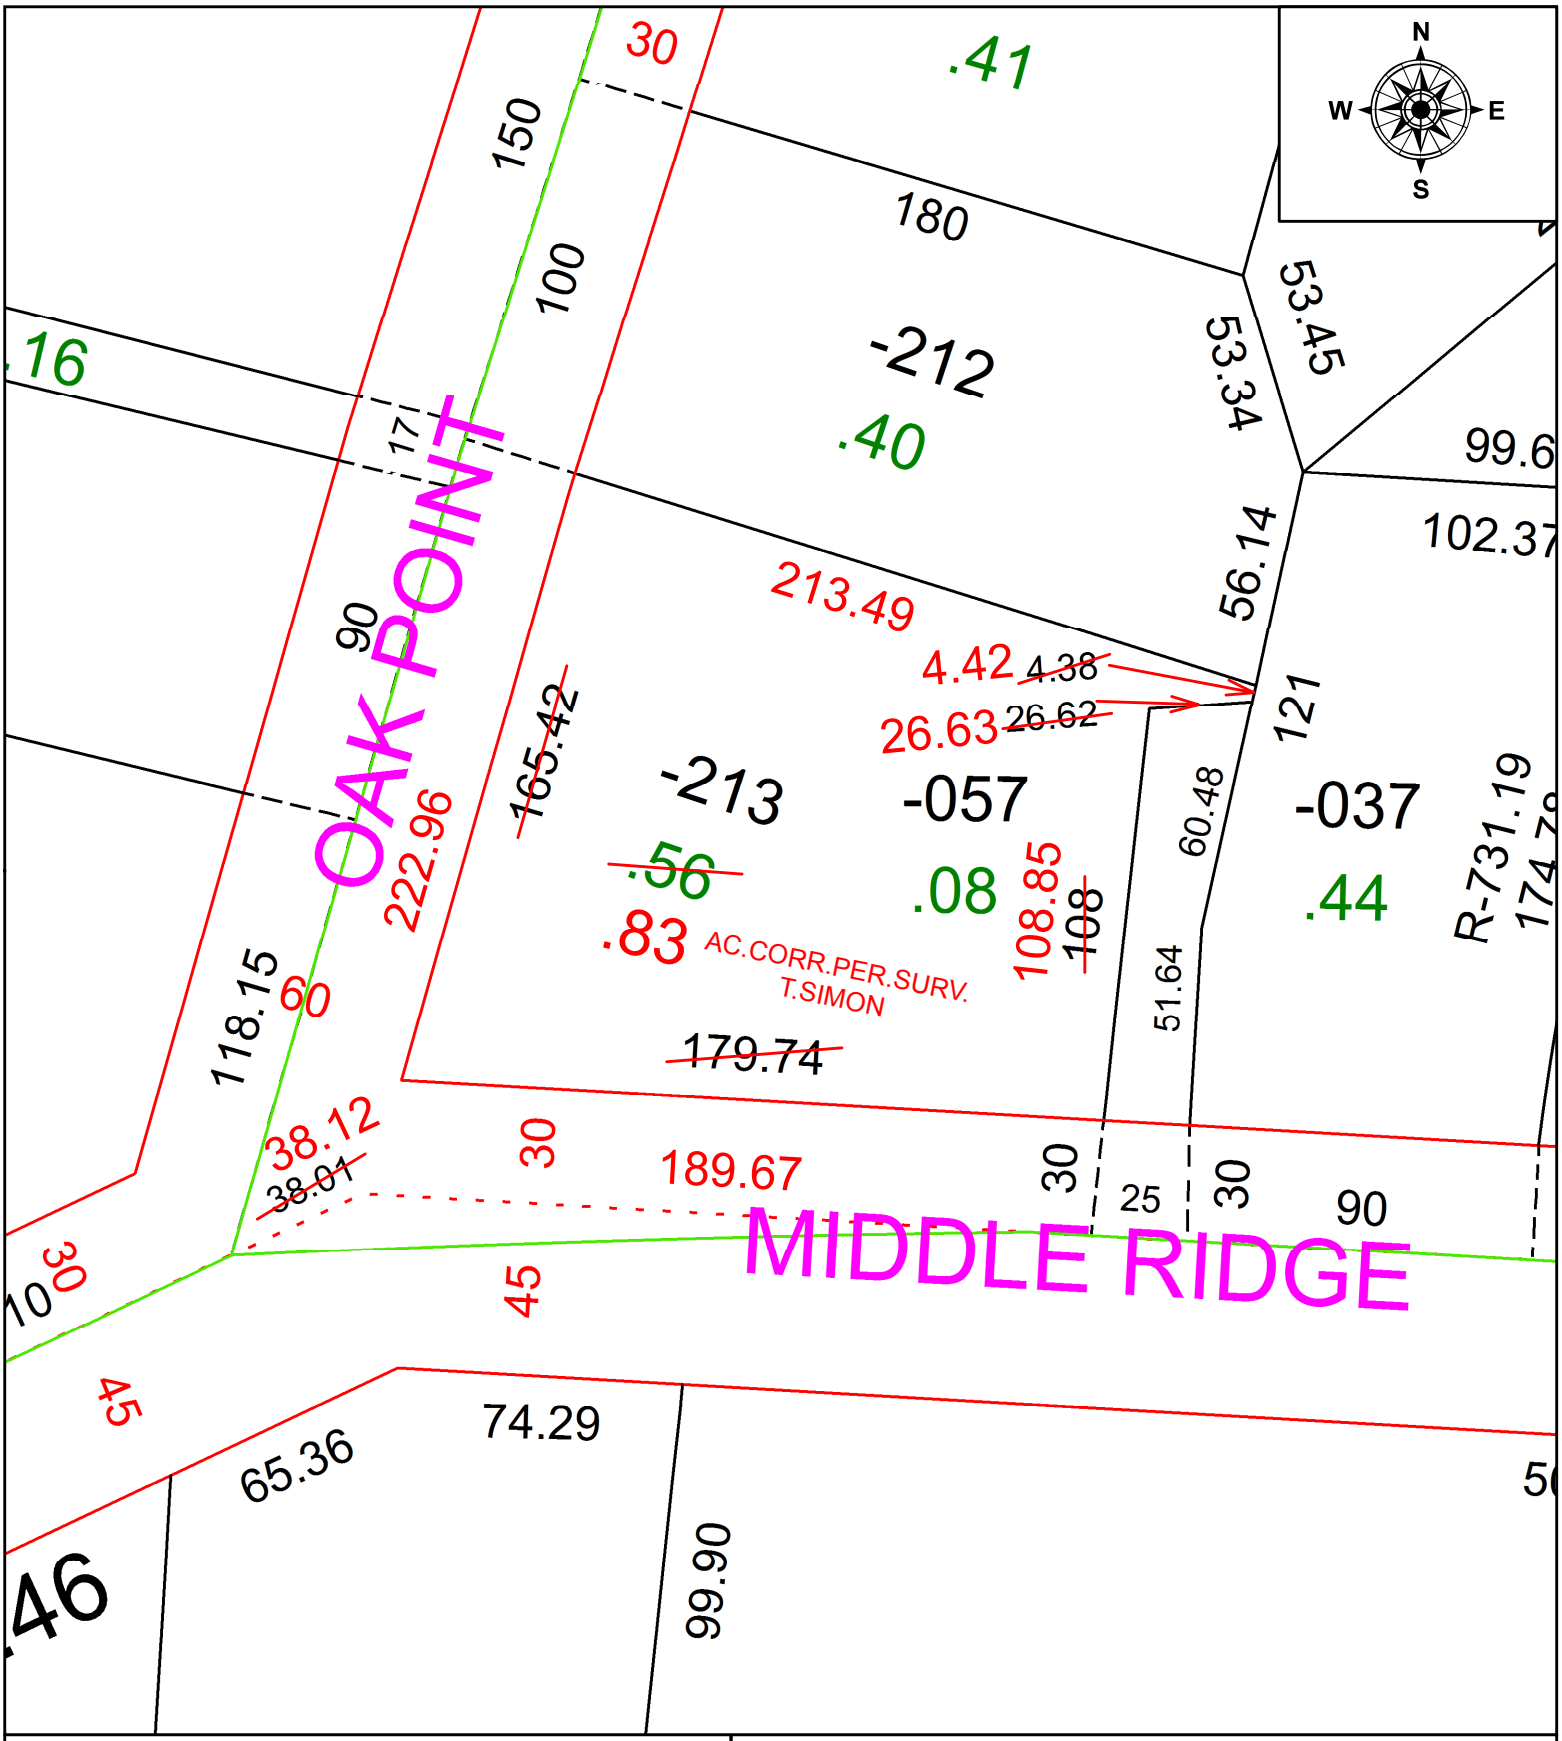

SPLITS/DEEDS PROCESSED

LORAIN COUNTY TAX MAP DEPARTMENT
226 MIDDLE AVE. ELYRIA, OH

SURVEYED BY: THOMAS A. SIMON
CLOSURE: 1:119,467
MAP PAGE(S): 5-00-006
APPOVED BY: RRM **DATE:** 8-13-20
SCALE: 1" = 50 **PRIOR INSTRUMENT:** 20160599714