PARENT PARCEL: 04-00-017-102-141

CHILD PARCEL: 04-00-017-102-286 & -287

STARTING POINT: MONUMENT BOX AT THE C/LS OF BELMONT DR & AVON-BELDEN RD

21-04381

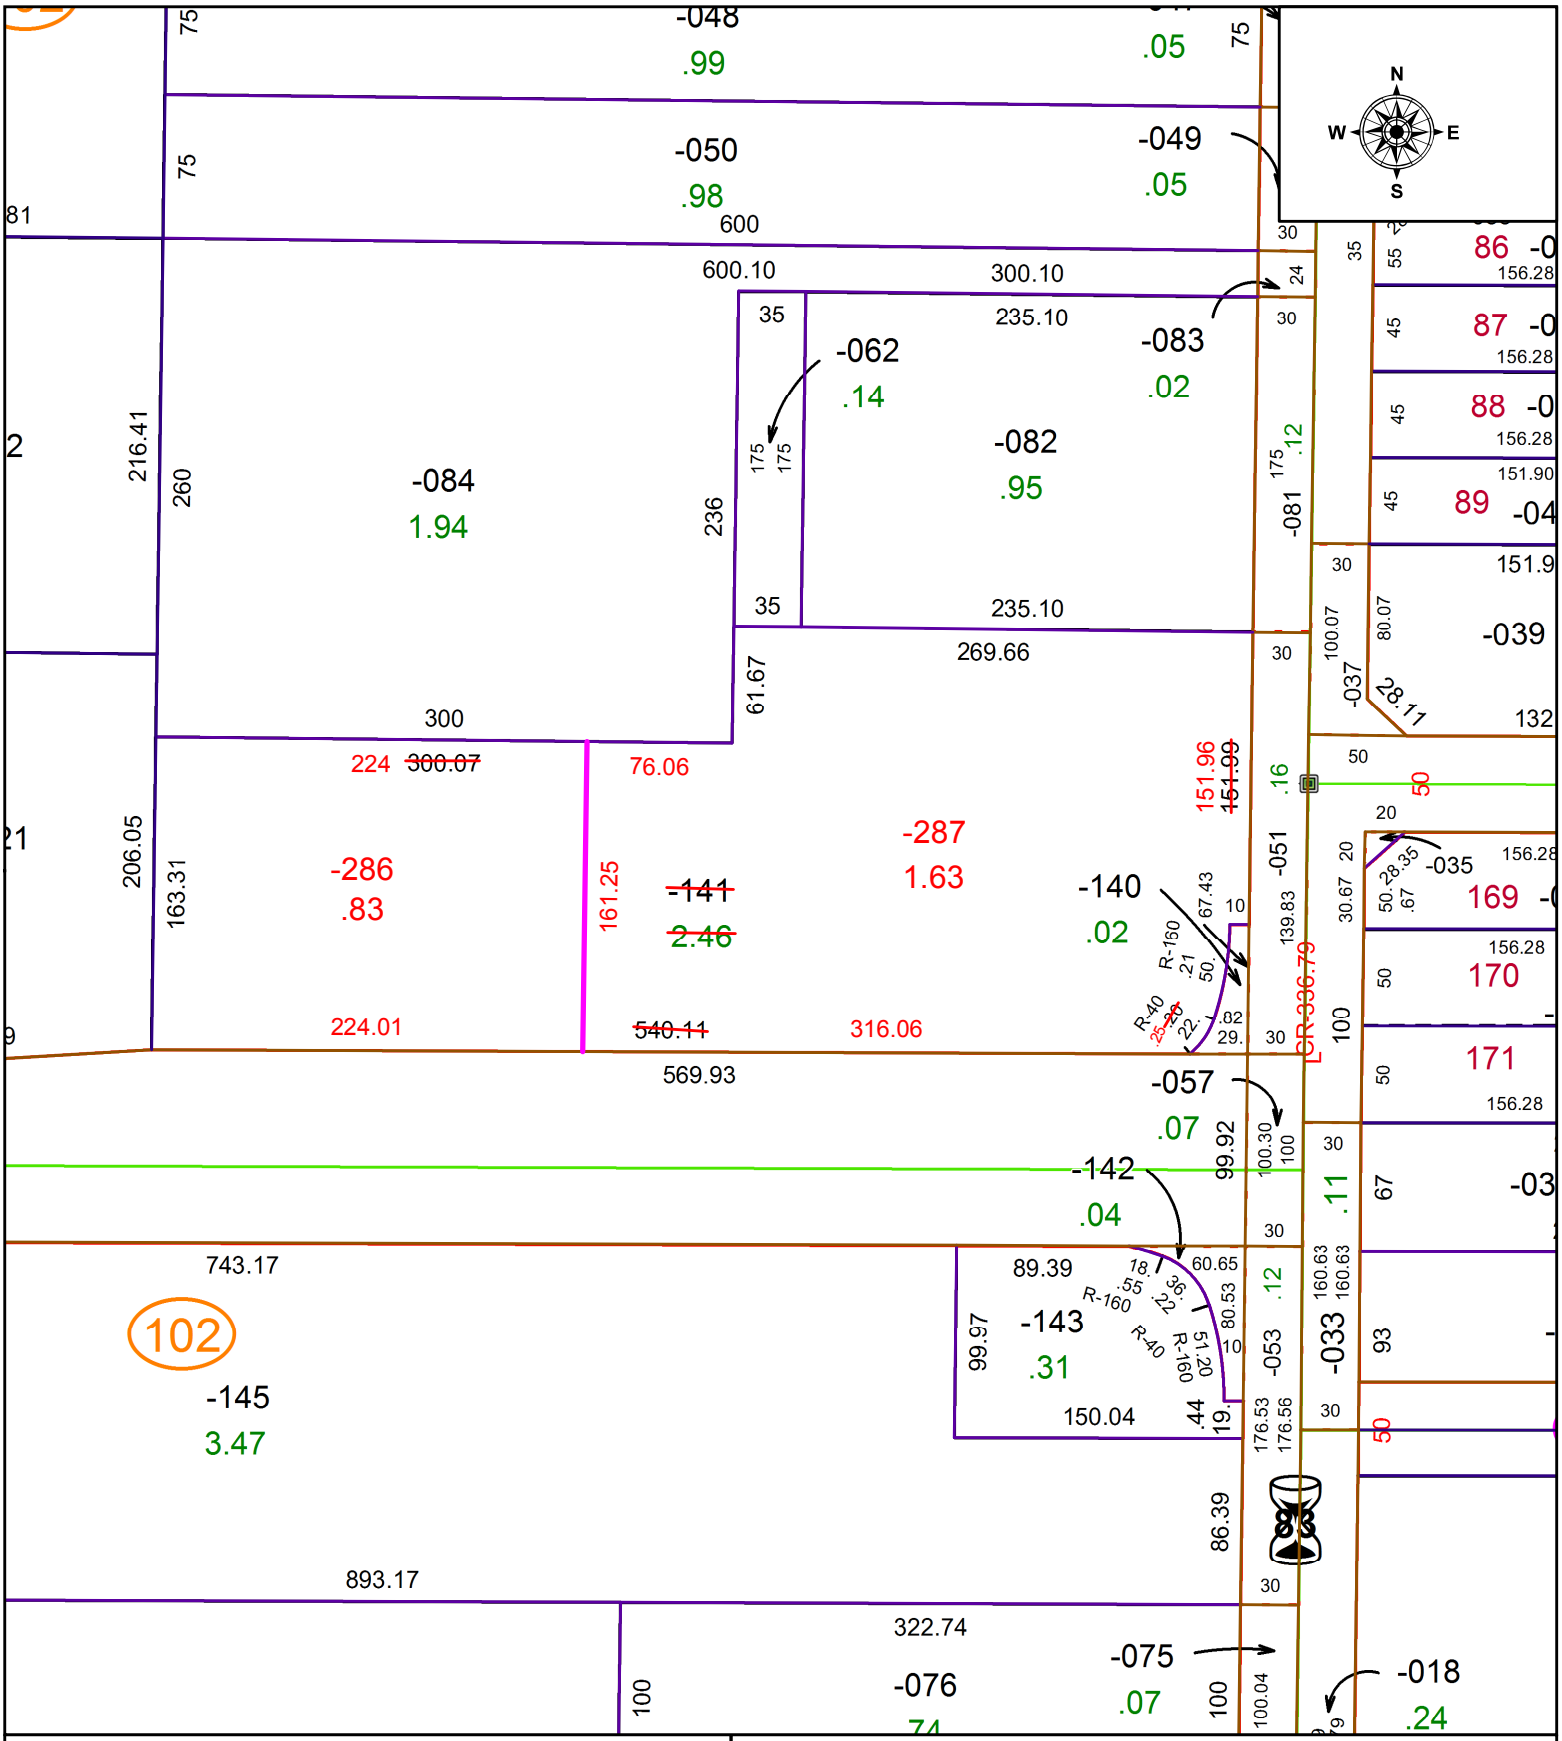

SPLITS/DEEDS PROCESSED

LORAIN COUNTY TAX MAP DEPARTMENT
226 MIDDLE AVE. ELYRIA, OH

SURVEYED BY: MICHAEL P. SPELLACY
CLOSURE: 1: 554,641
MAP PAGE(S): 04-00-017
APPOVED BY: WRZ **DATE:** 9/28/2021
SCALE: 1" = 100 **PRIOR INSTRUMENT:** 2011-0397110