PARENT PARCEL: 05-00-002-000-027, -029

CHILD PARCEL:

STARTING POINT: COOPER FOSTER PARK RD. STATION 93+31.75 (PV 24/2)

20-04382-C

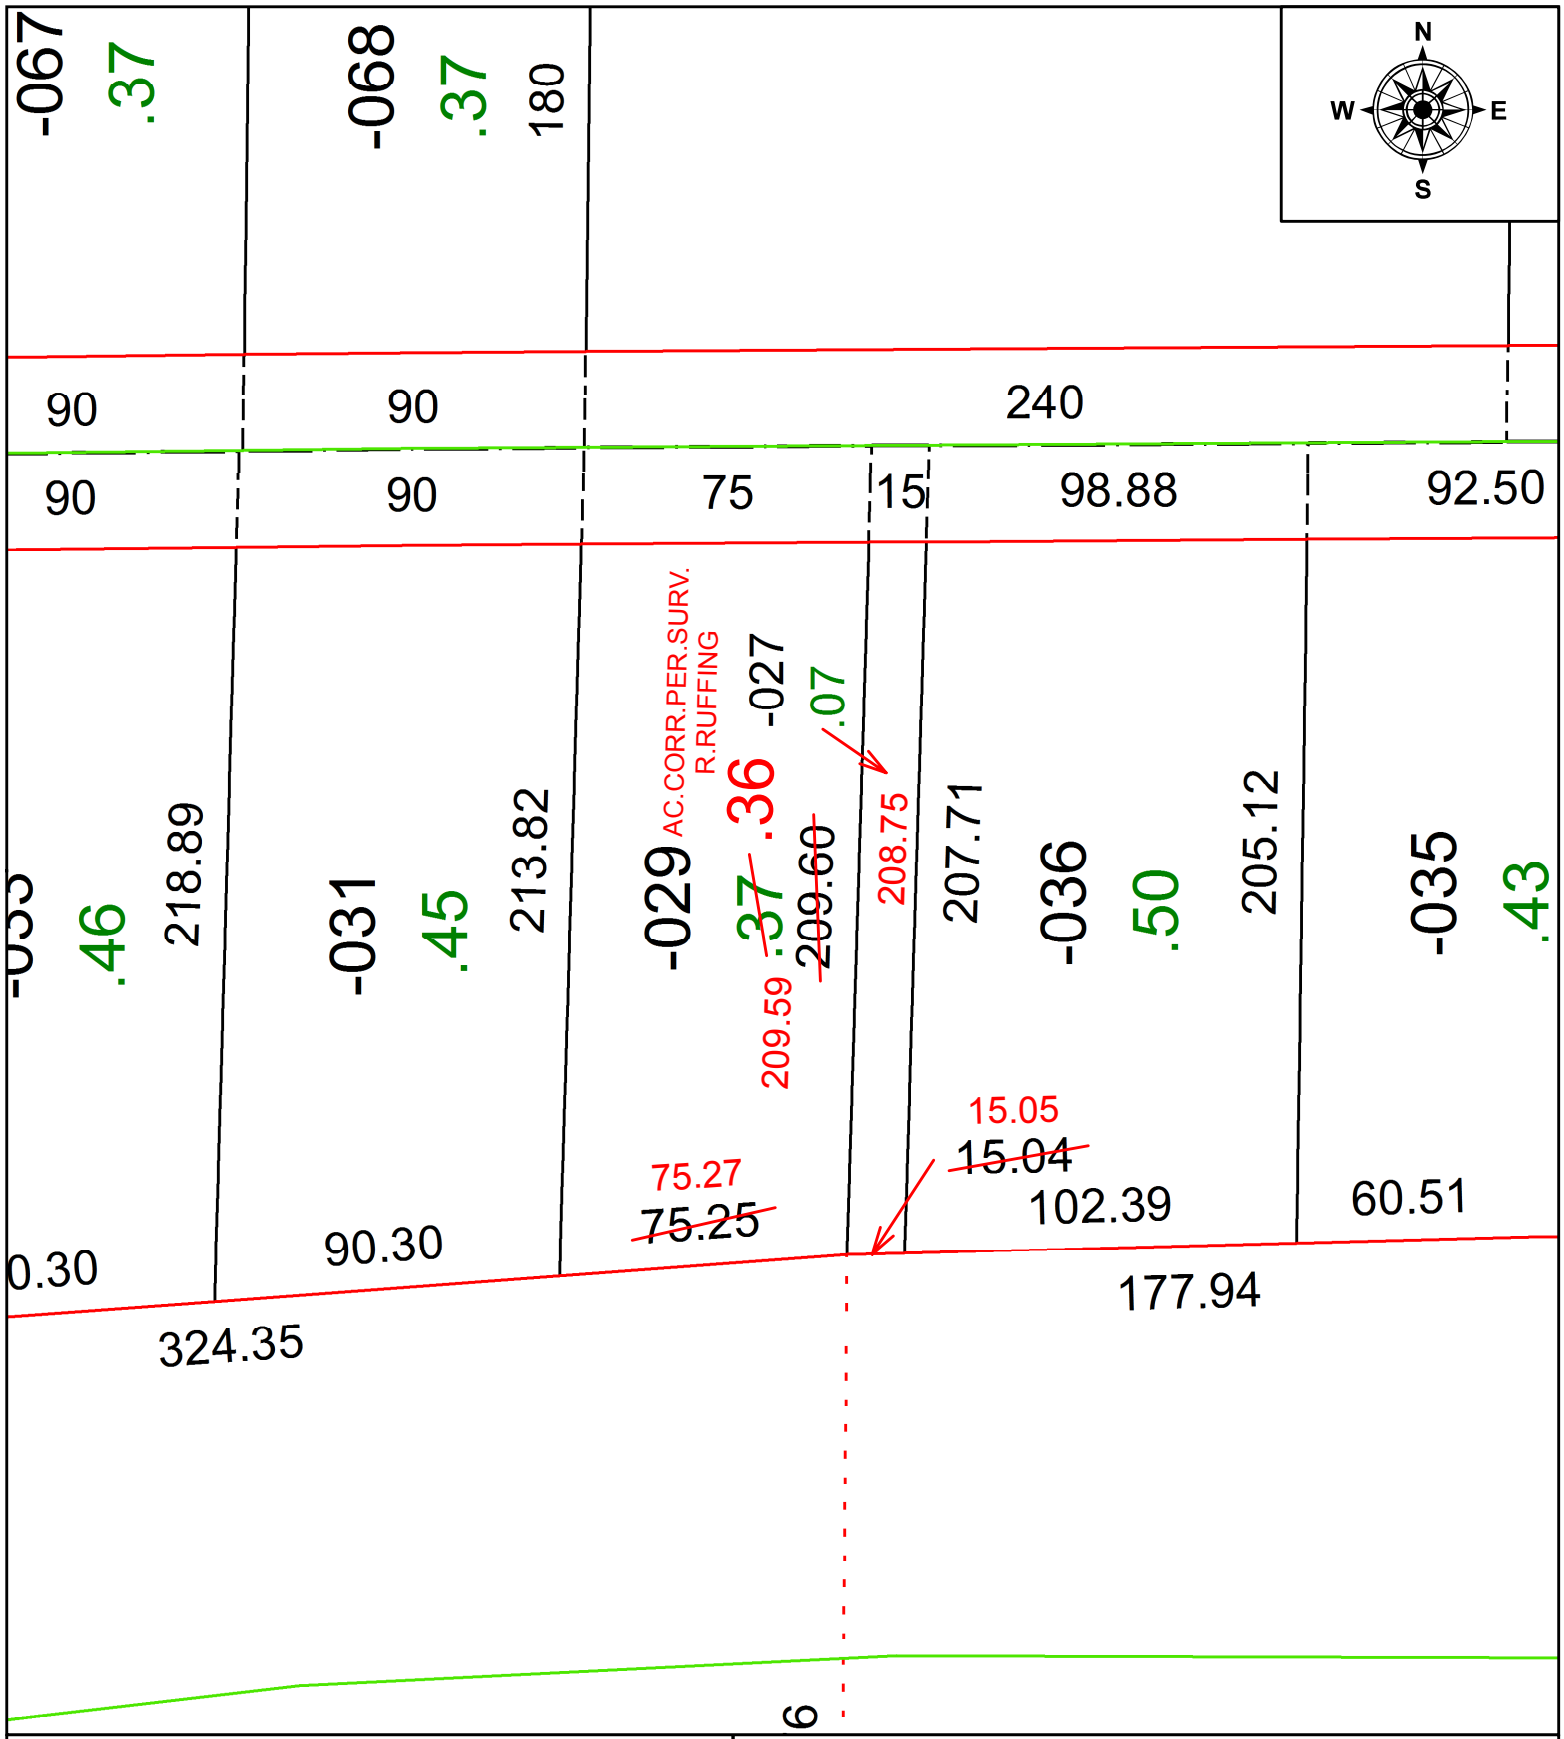

SPLITS/DEEDS PROCESSED

LORAIN COUNTY TAX MAP DEPARTMENT
226 MIDDLE AVE. ELYRIA, OH

SURVEYED BY: ROBERT M. RUFFING
CLOSURE: 1:100,654
MAP PAGE(S): 5-00-002
APPOVED BY: RRM **DATE:** 8-13-20
SCALE: 1" = 50 **PRIOR INSTRUMENT:** 20200762800