PARENT PARCEL: 04-00-022-105-042

CHILD PARCEL:

STARTING POINT: INTERSECTION OF C/L OF DETROIT RD. AND C/L OF JOSEPH ST.

20-04383-D

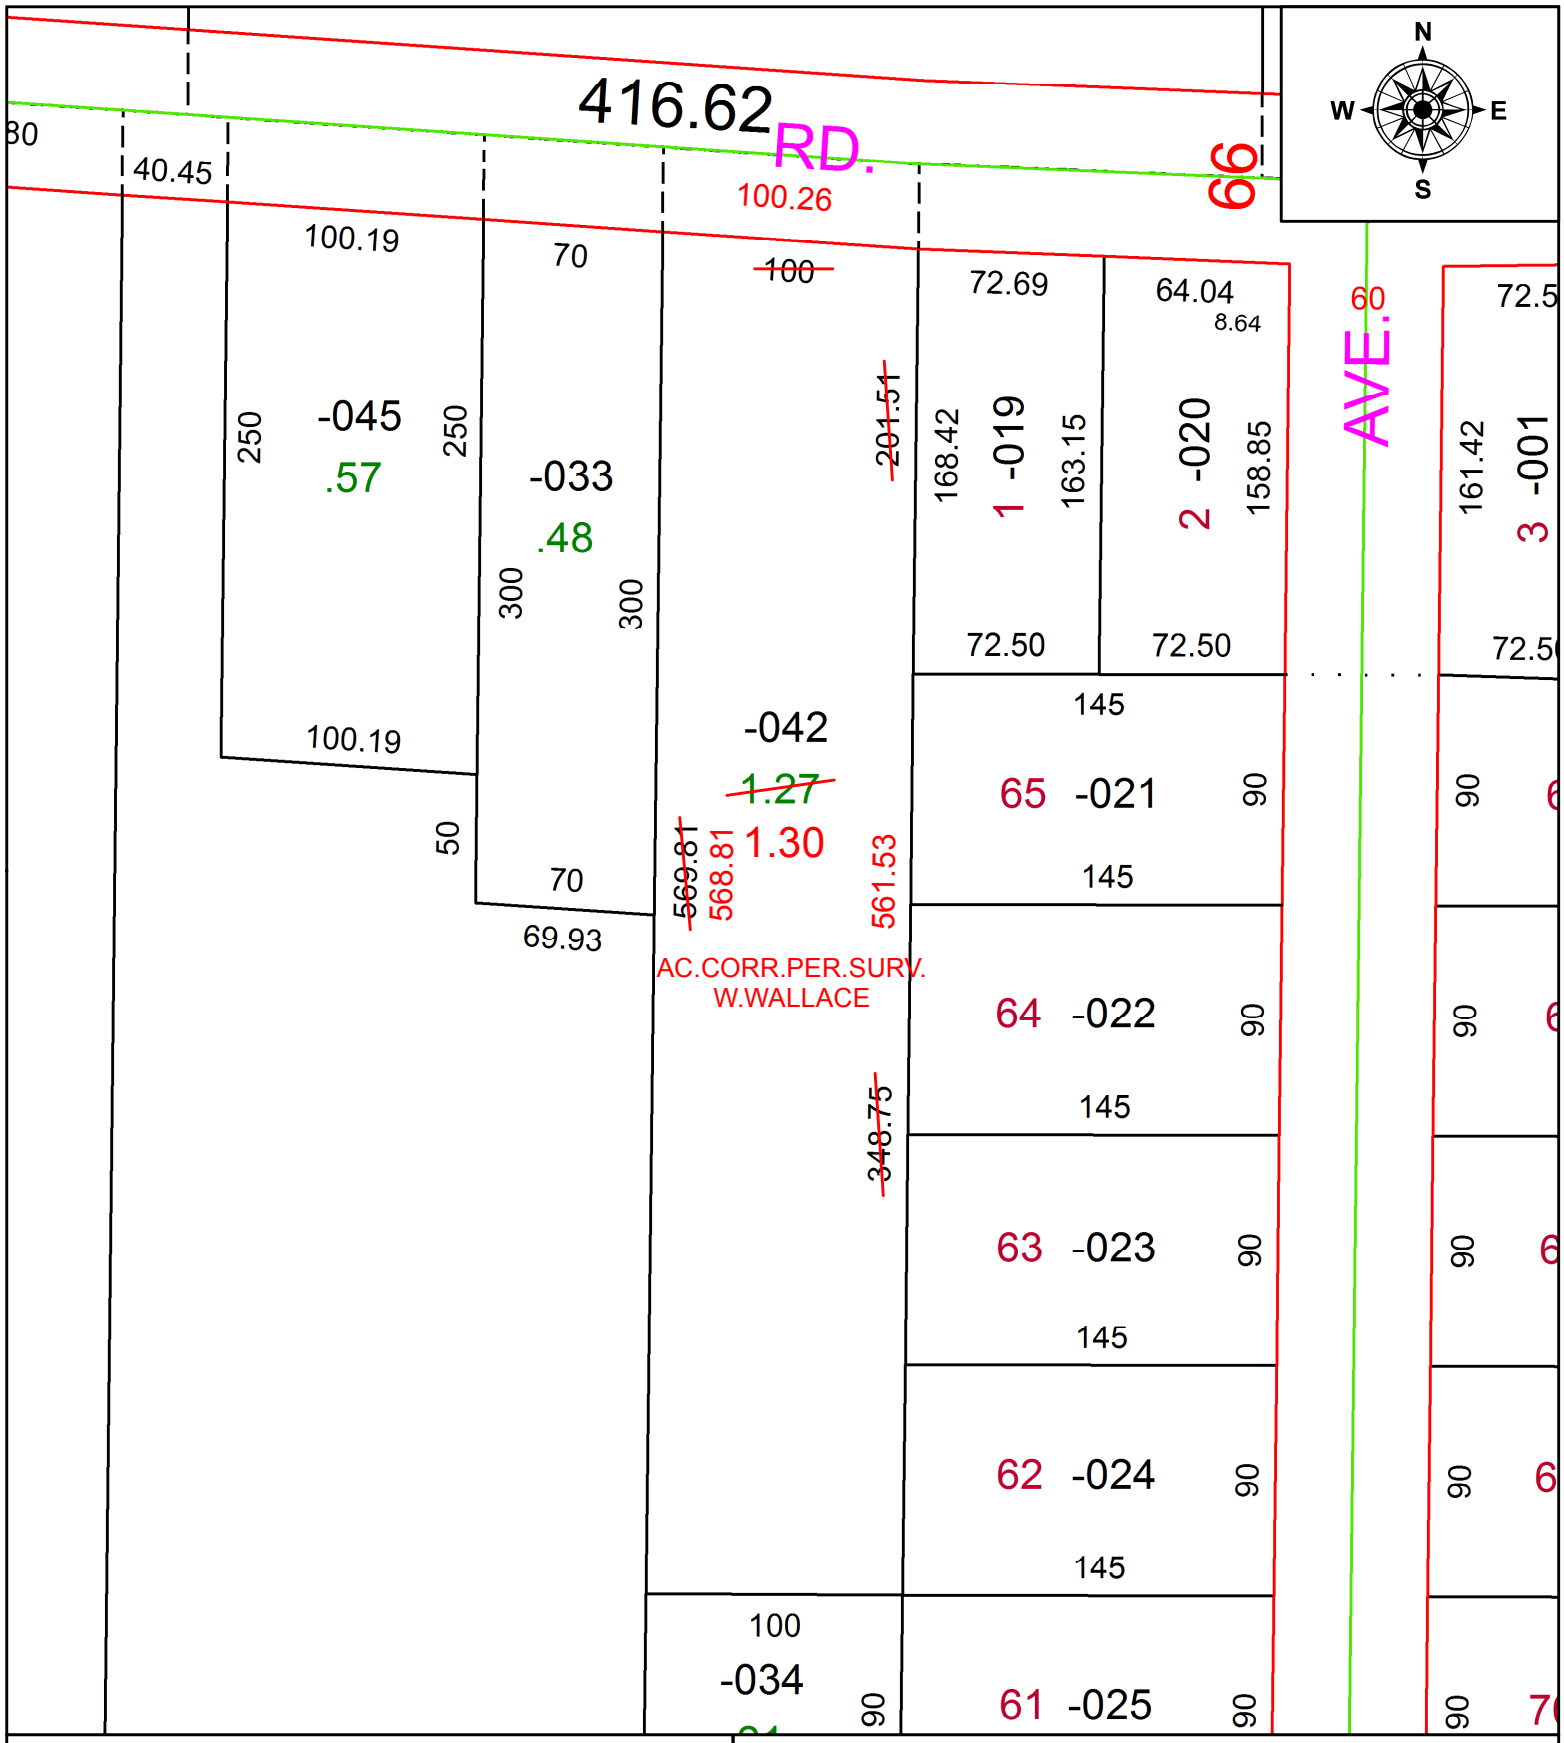

SPLITS/DEEDS PROCESSED

LORAIN COUNTY TAX MAP DEPARTMENT
226 MIDDLE AVE. ELYRIA, OH

SURVEYED BY: WILLIAM R. WALLACE
CLOSURE: 1:99,108
MAP PAGE(S): 4-00-022
APPOVED BY: RRM **DATE:** 8-13-20
SCALE: 1" = 75 **PRIOR INSTRUMENT:** 20200765402