PARENT PARCEL: 15-00-090-000-005
CHILD PARCEL: 15-00-090-000-047, -048
STARTING POINT: C/L OF VERMONT ST AND SOUTH LINE OF O/L 90

21-04383

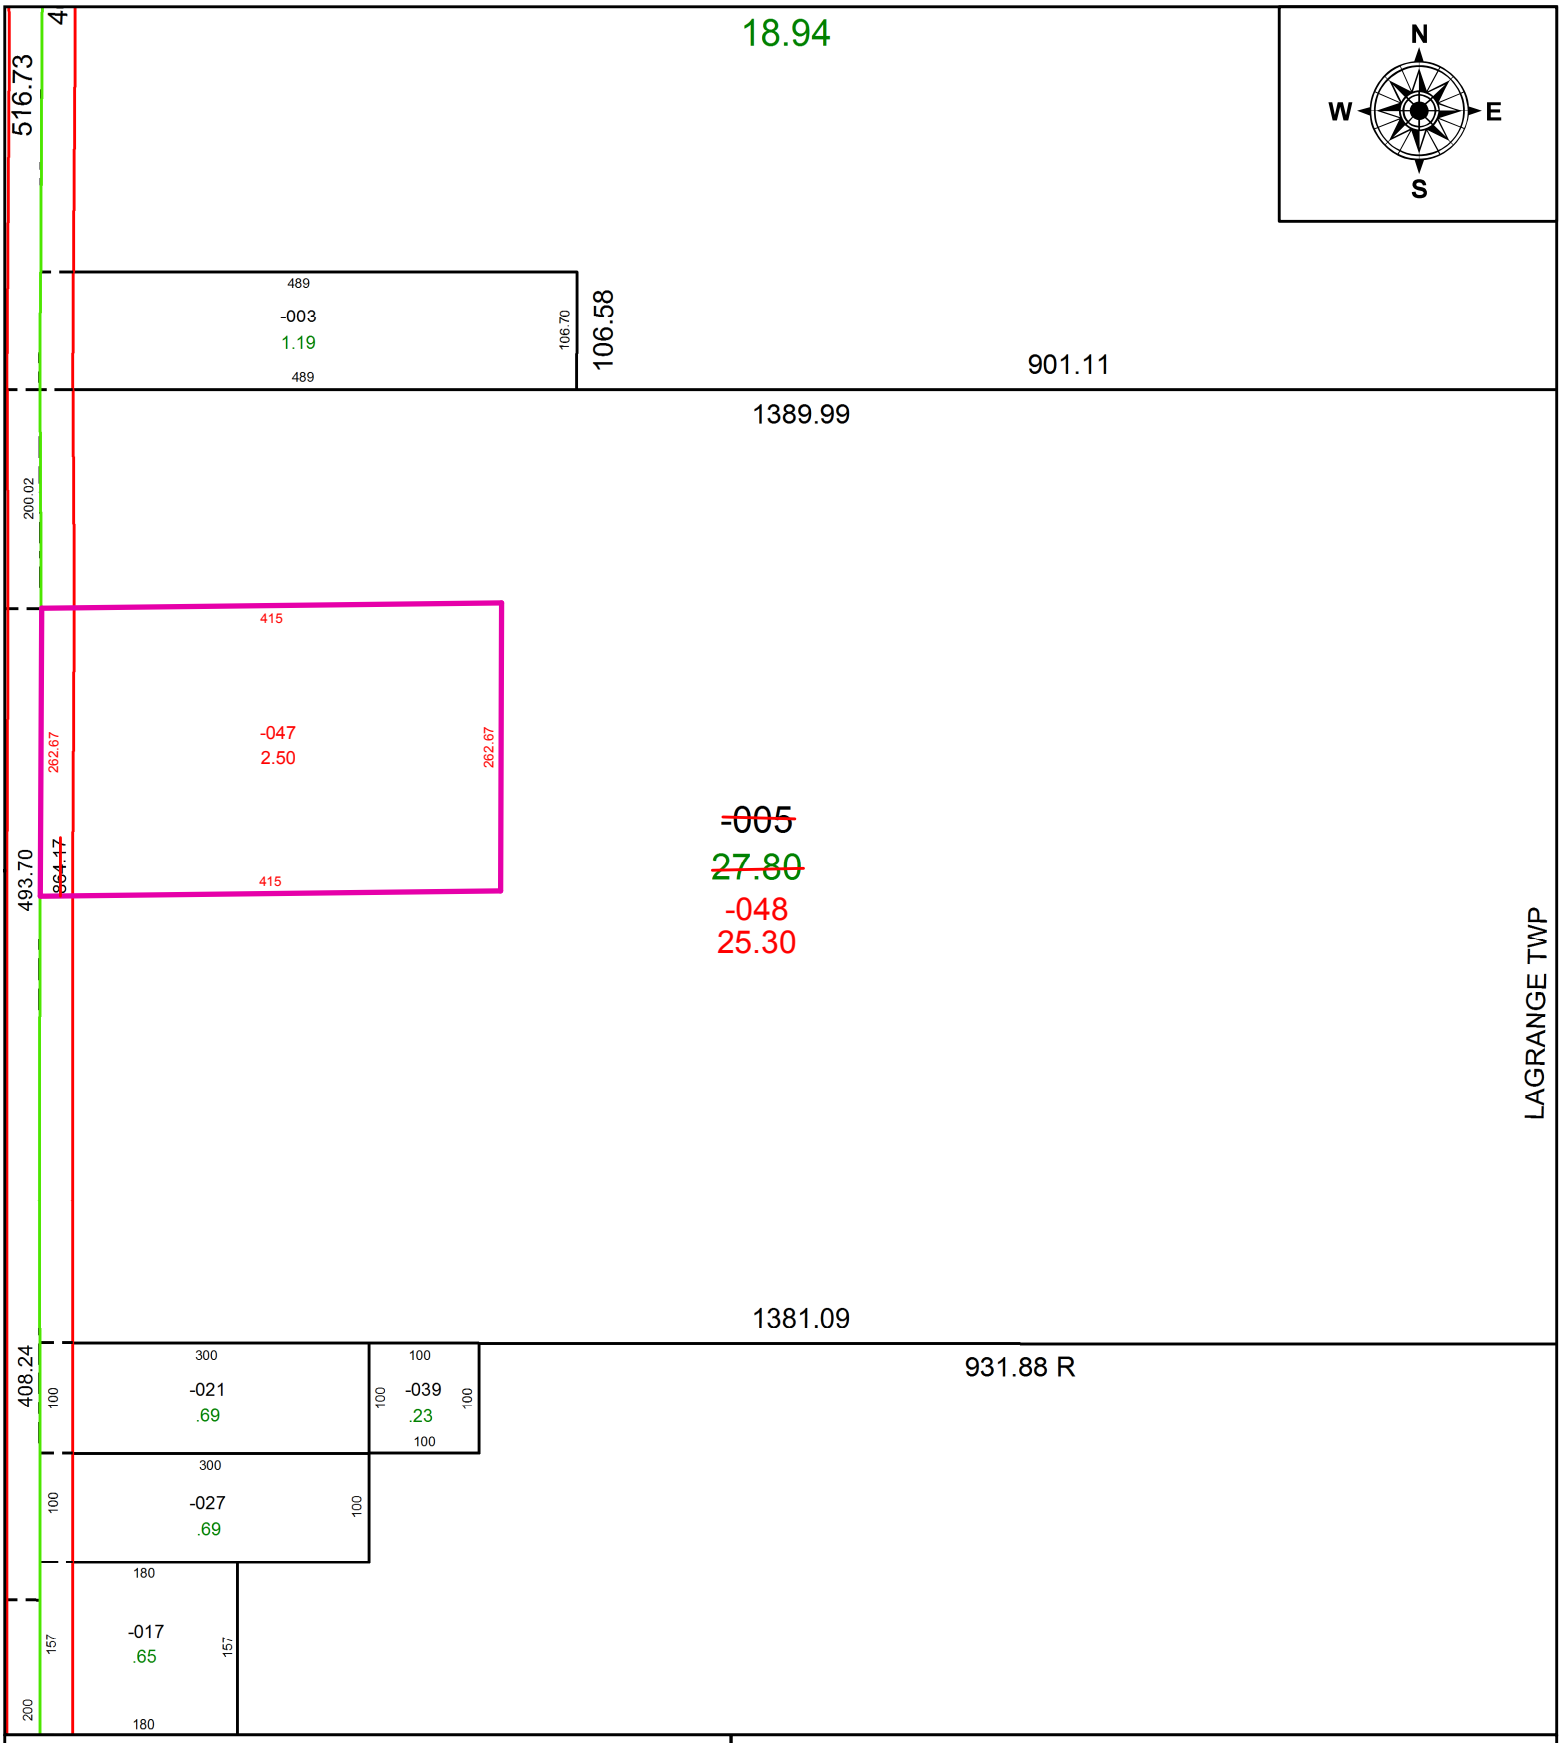

SPLITS/DEEDS PROCESSED
LORAIN COUNTY TAX MAP DEPARTMENT
226 MIDDLE AVE. ELYRIA, OH

SURVEYED BY: PATRICK A. MCGANNON
CLOSURE: 1: 2147483648
MAP PAGE(S): 15-00-090
APPOVED BY: AC **DATE:** 10/5/2021
SCALE: 1" = 175 **PRIOR INSTRUMENT:** 2013- 0466400