PARENT PARCEL: 11-00-065-000-005 & -006

CHILD PARCEL: 11-00-065-000-031, -032, -033

STARTING POINT: C/L OF TWINSBURG-ELYRIA RD AND NW OF EATON O/L 65

21-04387

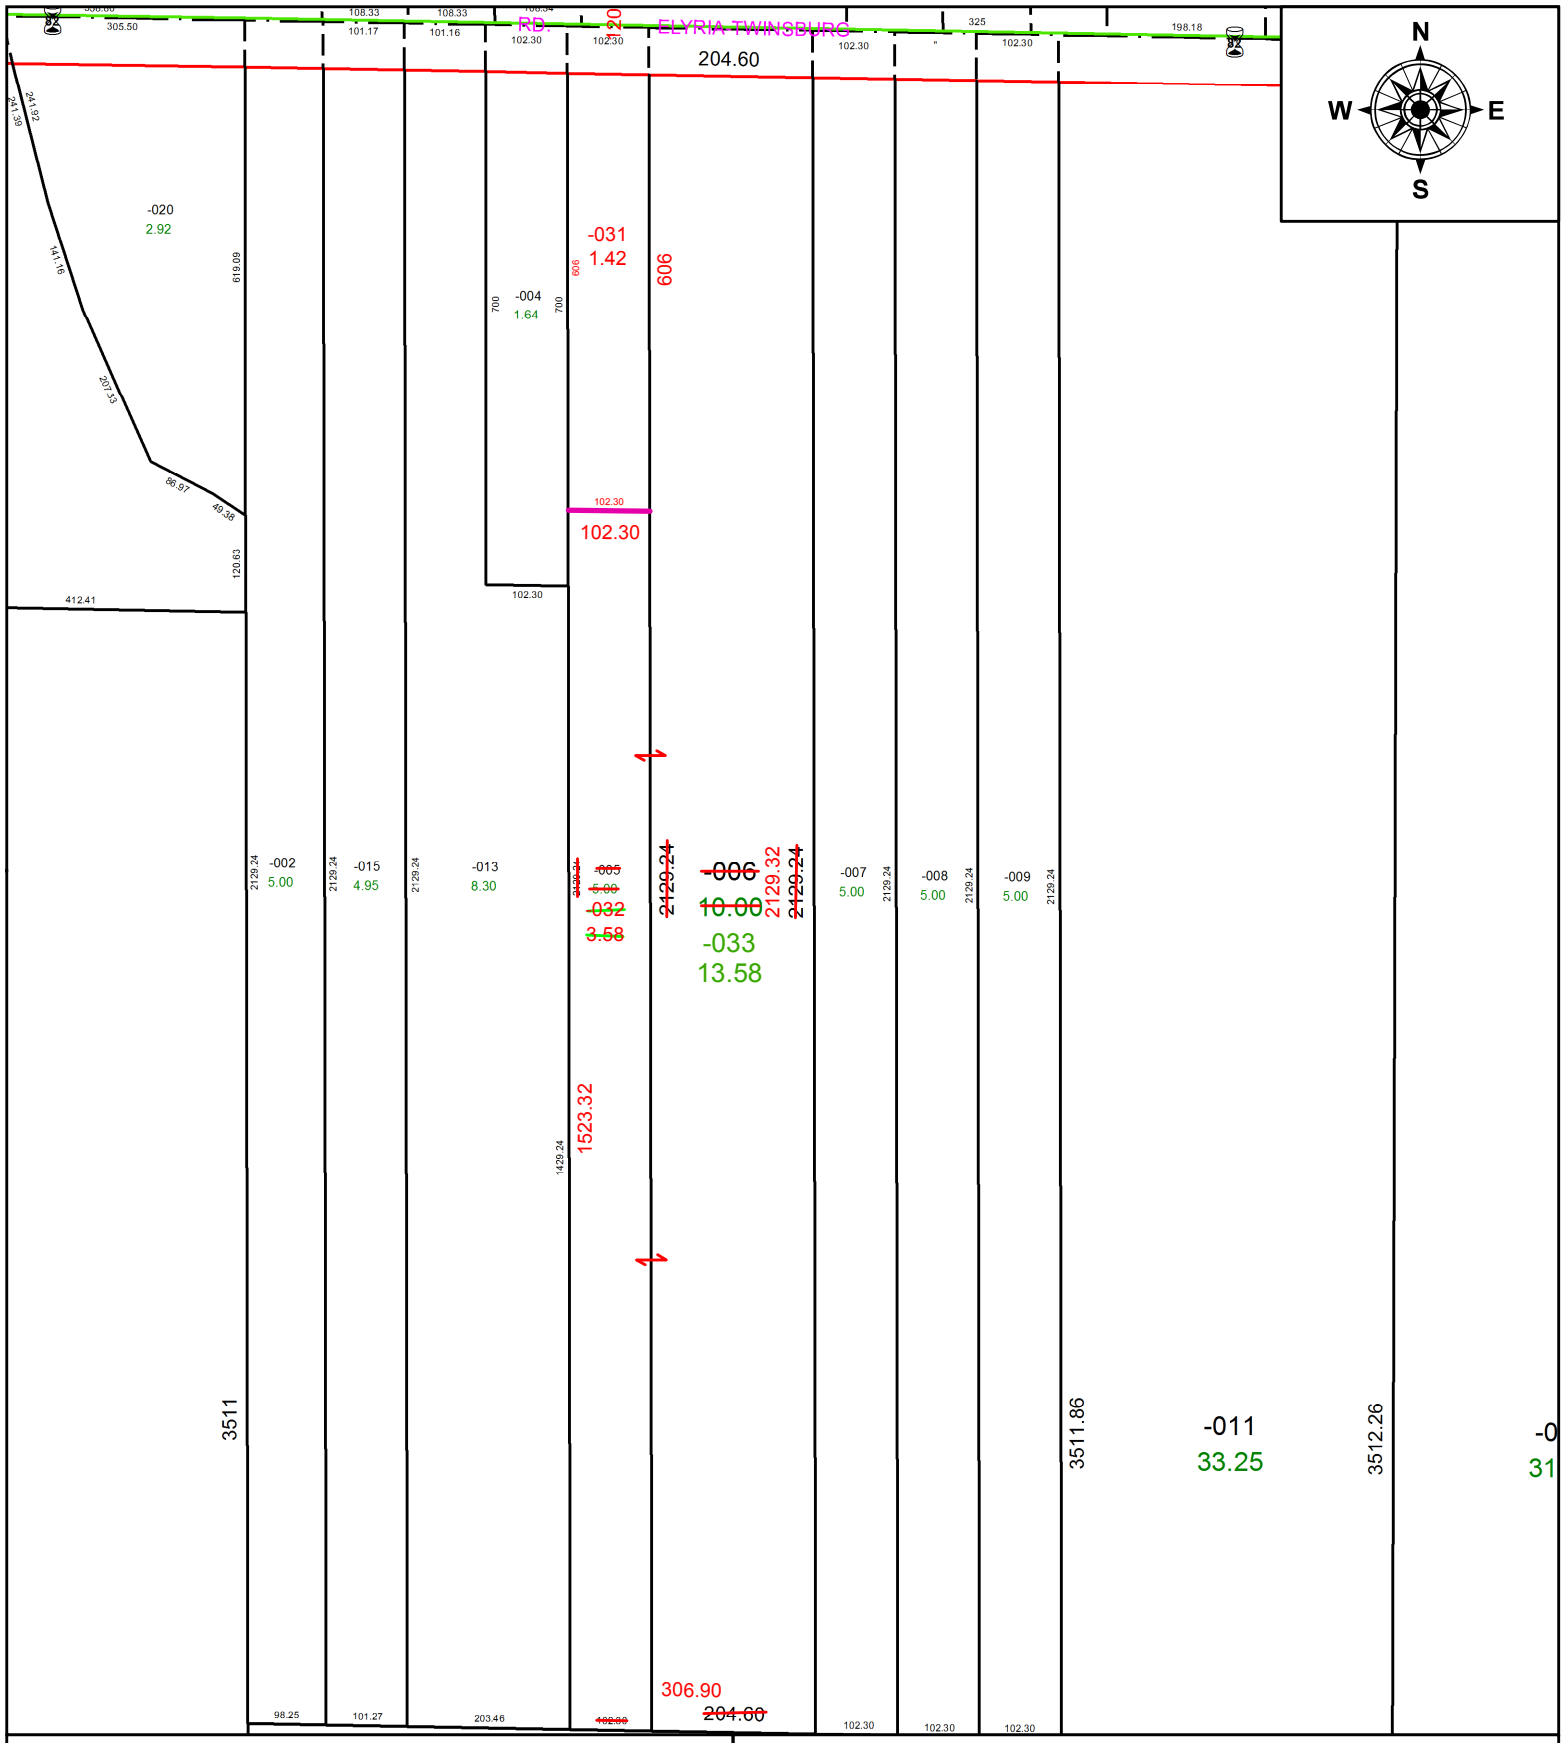

SPLITS/DEEDS PROCESSED

LORAIN COUNTY TAX MAP DEPARTMENT
226 MIDDLE AVE. ELYRIA, OH

SURVEYED BY: RICHARD METZKER
CLOSURE: 1: 2147483648
MAP PAGE(S): 11-00-065
APPOVED BY: AC **DATE:** 10/6/2021
SCALE: 1" = 240 **PRIOR INSTRUMENT:** 2017- 0620250