PARENT PARCEL: 02-01-008-101-176

CHILD PARCEL:

STARTING POINT: POINT OF TANGENCY ON C/L OF BUCKINGHAM DR. IN FRONT OF S/ 15 IN NOTTINGHAM WOODS SUB.

20-04388-C

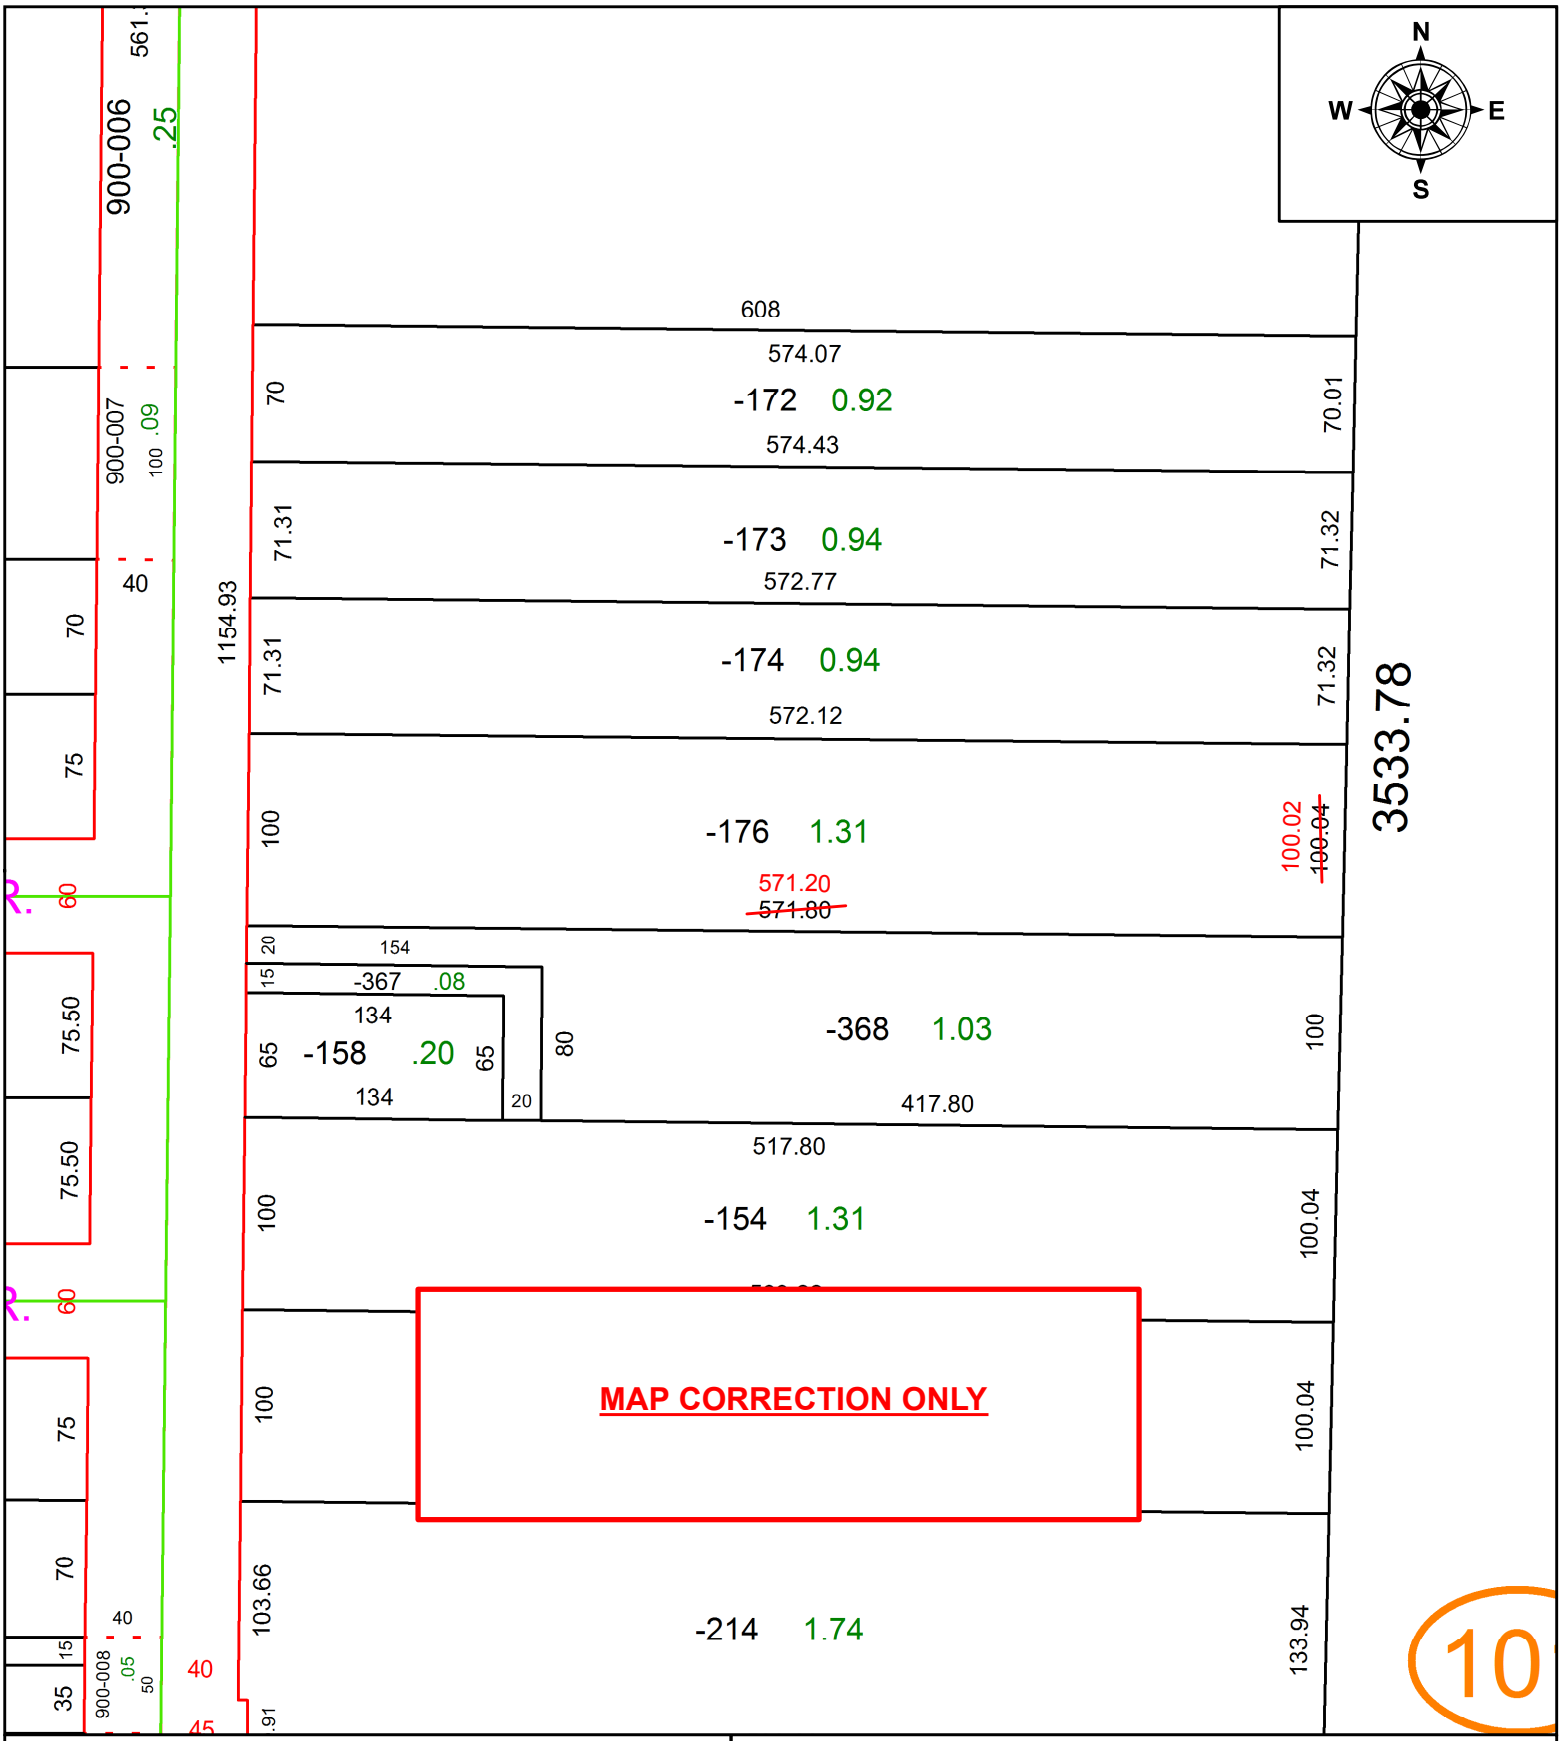

SPLITS/DEEDS PROCESSED

LORAIN COUNTY TAX MAP DEPARTMENT
226 MIDDLE AVE. ELYRIA, OH

SURVEYED BY: ROBERT M. RUFFING
CLOSURE: 1:458,574
MAP PAGE(S): 2-01-008
APPOVED BY: RRM **DATE:** 8-25-20
SCALE: 1" = 100 **PRIOR INSTRUMENT:** 20110380789