PARENT PARCEL: 10-00-015-108-004
CHILD PARCEL:
STARTING POINT: NORTHWEST OF S/L 168 IN BRENTWOOD ALLOTMENT NO.4

20-04389-D

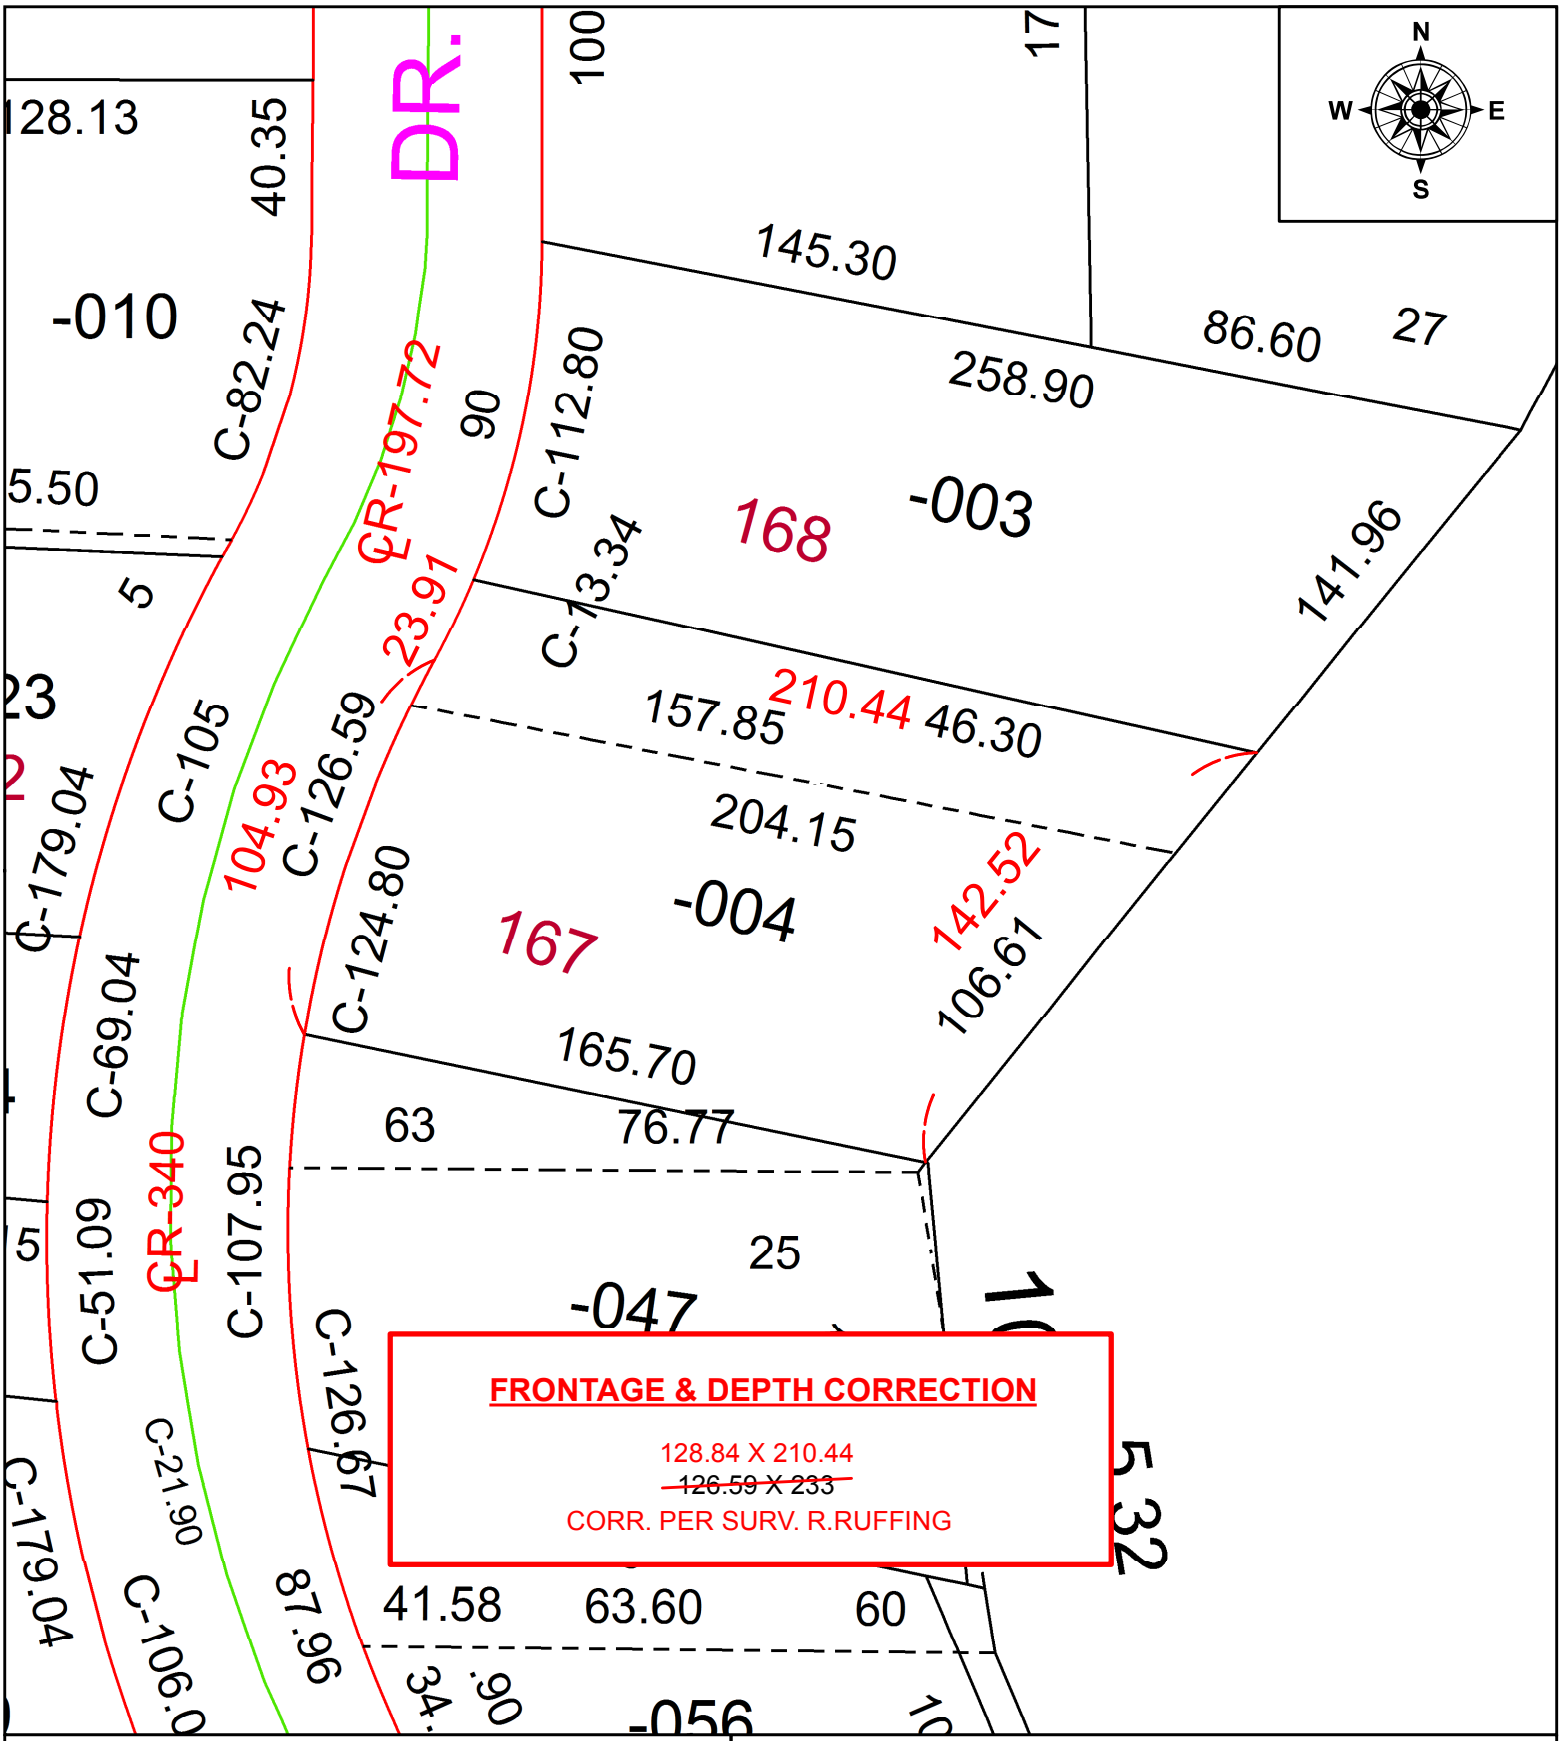

FRONTAGE & DEPTH CORRECTION

128.84 X 210.44
~~126.59 X 233~~
CORR. PER SURV. R.RUFFING

SPLITS/DEEDS PROCESSED
LORAIN COUNTY TAX MAP DEPARTMENT
226 MIDDLE AVE. ELYRIA, OH

SURVEYED BY: ROBERT M. RUFFING
CLOSURE: 1:234,568
MAP PAGE(S): 10-00-015
APPOVED BY: RRM **DATE:** 9-2-20
SCALE: 1" = 50 **PRIOR INSTRUMENT:** 20170653712