PARENT PARCEL: 15-00-065-000-014

CHILD PARCEL:

STARTING POINT: INTERSECTION OF C/L OF COMMERCE DR. AND C/L OF S. CENTER ST.

20-04390-D

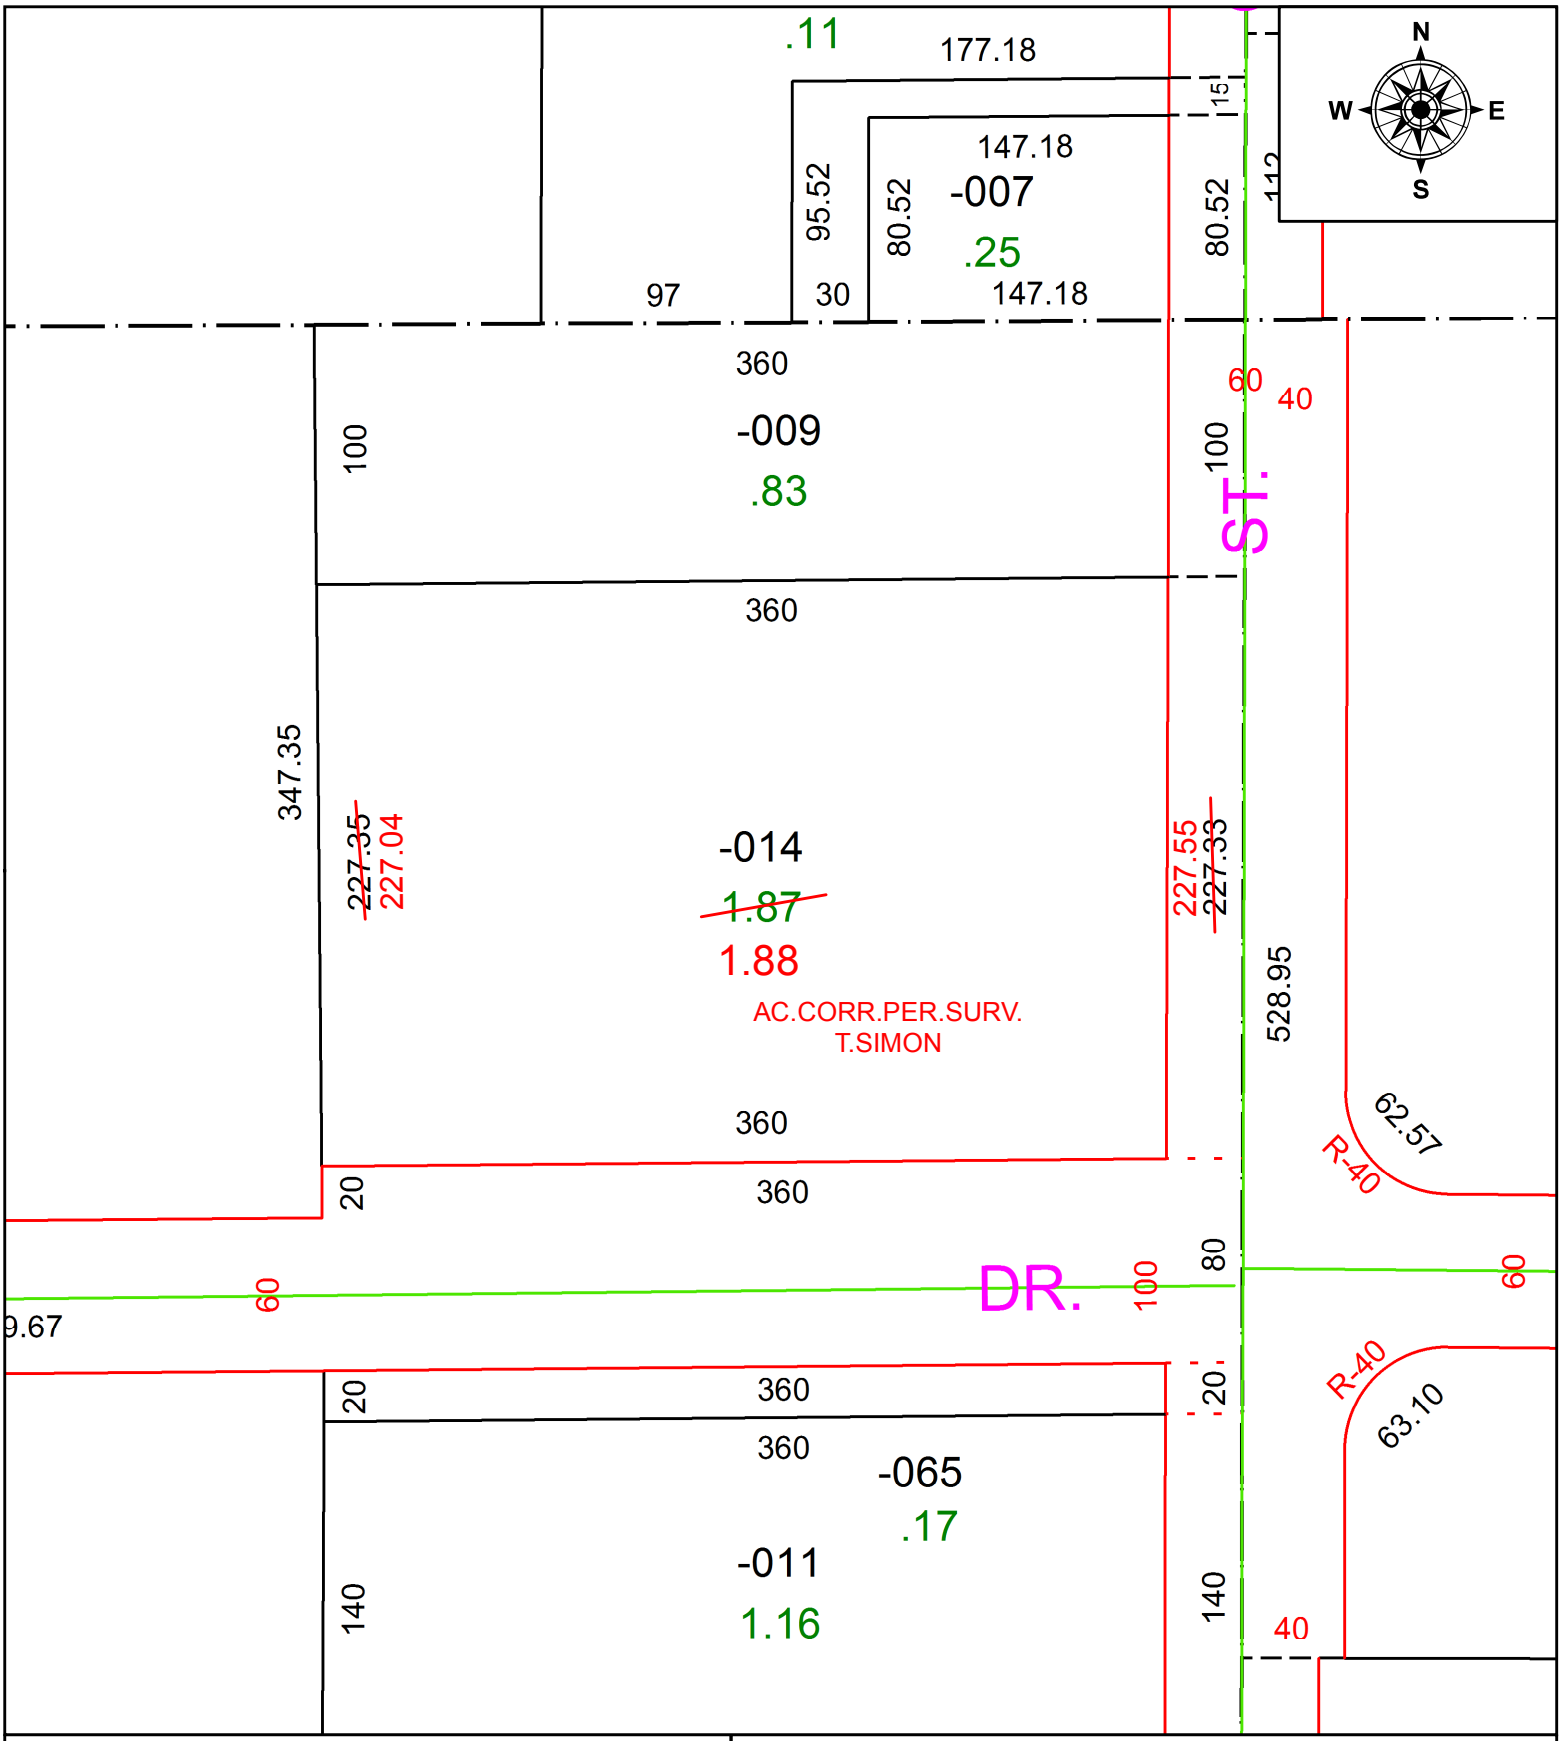

SPLITS/DEEDS PROCESSED

LORAIN COUNTY TAX MAP DEPARTMENT
226 MIDDLE AVE. ELYRIA, OH

SURVEYED BY: THOMAS A. SIMON
CLOSURE: 1:332,557
MAP PAGE(S): 15-00-065
APPOVED BY: RRM **DATE:** 9-2-20
SCALE: 1" = 75 **PRIOR INSTRUMENT:** 20180659332