PARENT PARCEL: 07-00-043-103-043

CHILD PARCEL:

STARTING POINT: INTERSECTION OF C/L OF BARRES RD. AND C/L OF CASE RD.

20-04393-D

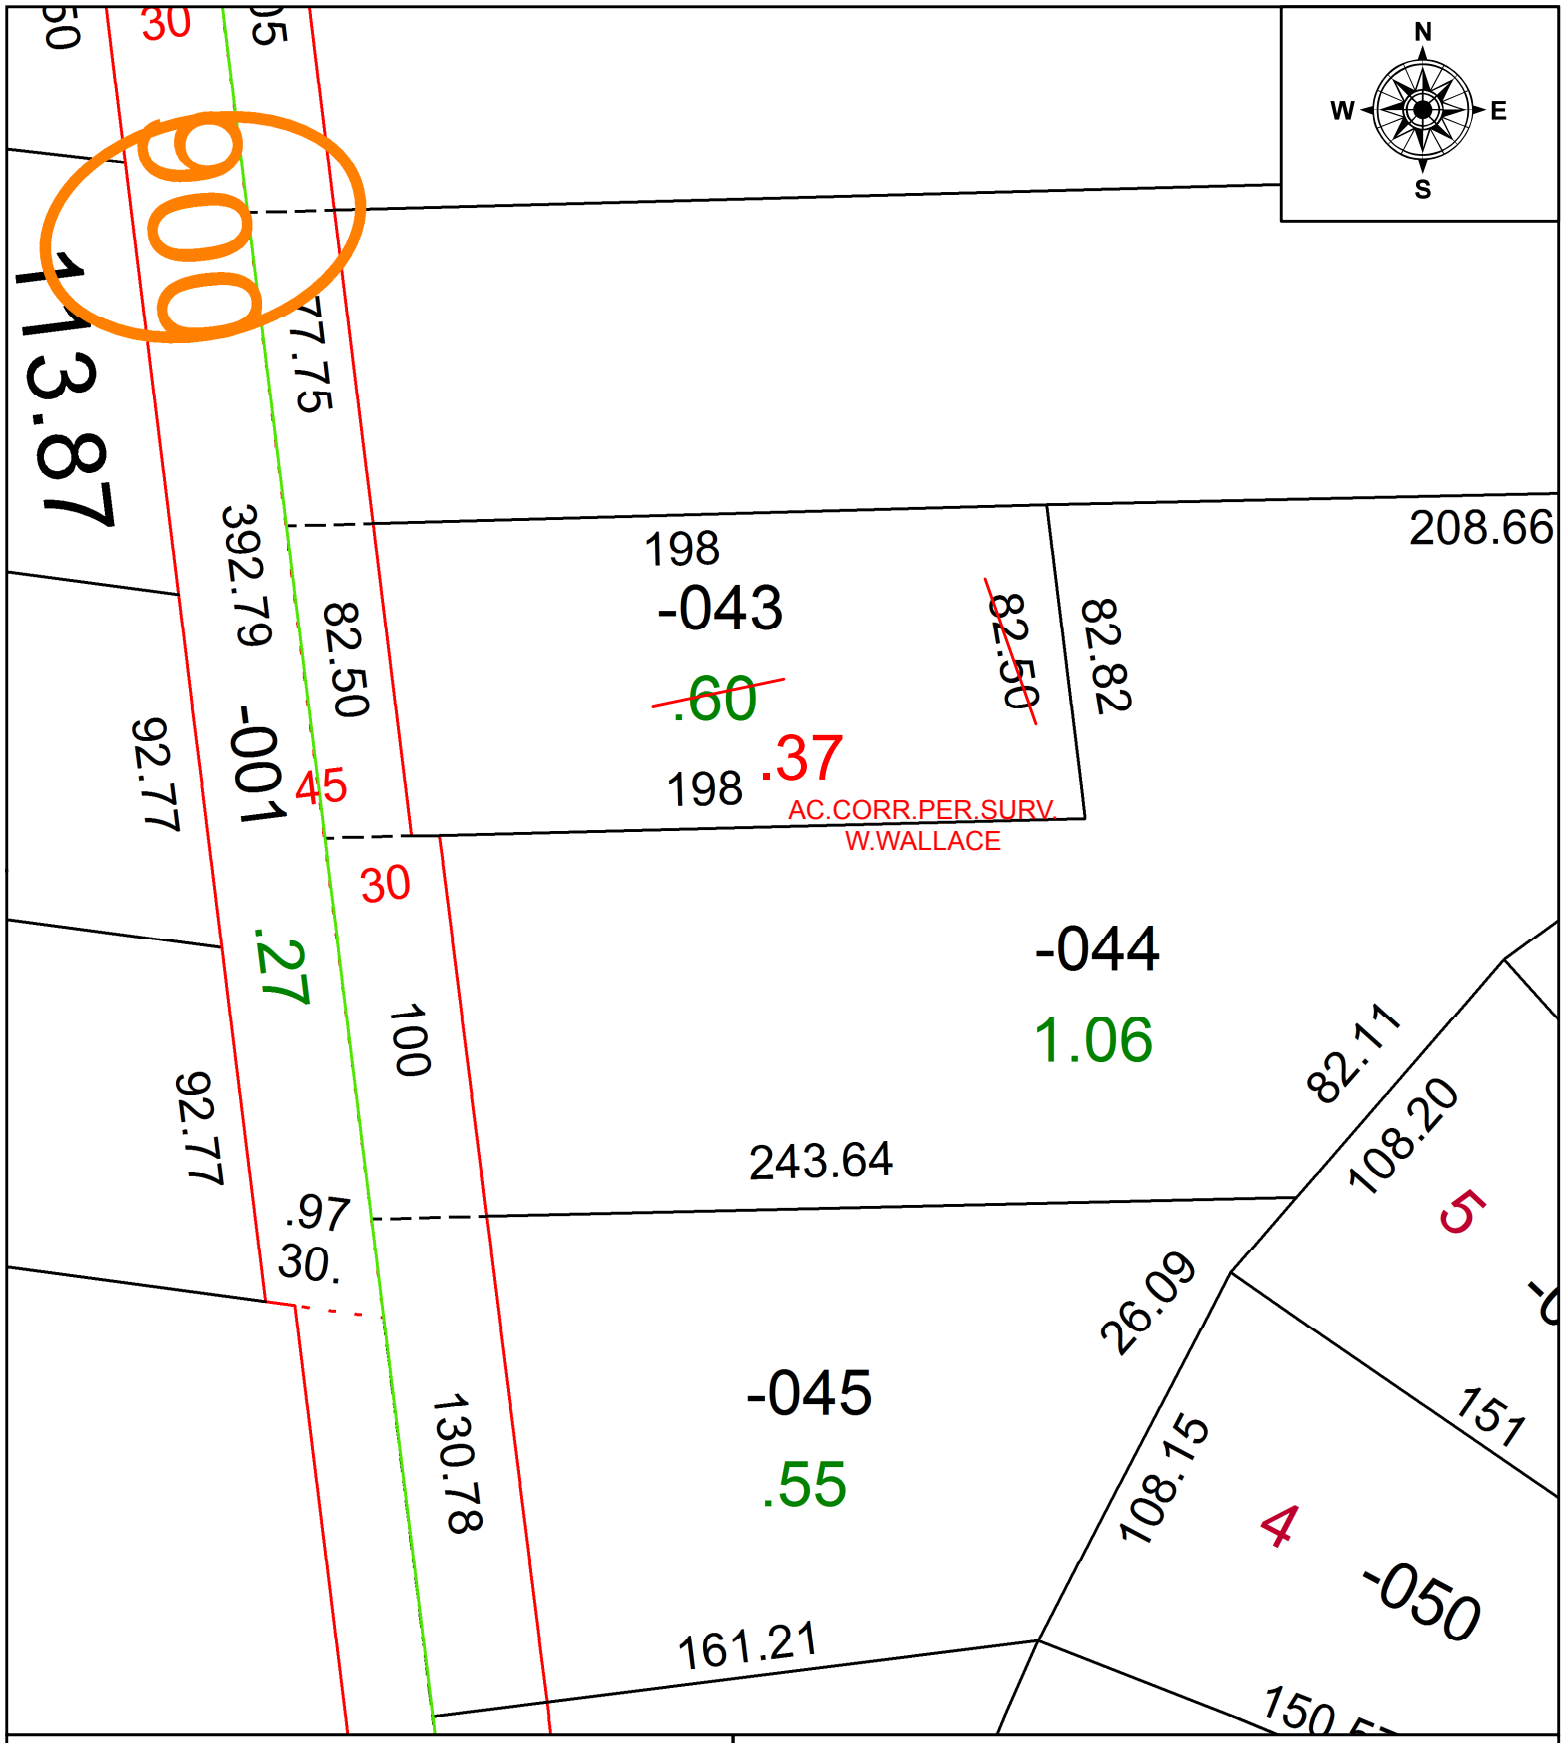

SPLITS/DEEDS PROCESSED

LORAIN COUNTY TAX MAP DEPARTMENT
226 MIDDLE AVE. ELYRIA, OH

SURVEYED BY: WILLIAM R. WALLACE
CLOSURE: 1:116,737
MAP PAGE(S): 7-00-043
APPOVED BY: RRM **DATE:** 9-9-20
SCALE: 1" = 50 **PRIOR INSTRUMENT:** 20190702809