PARENT PARCEL: 17-06-032-000-010 **AC CORR PER SURV BY JAMES ALLEN COTTRELL**

CHILD PARCEL: 17-06-032-000-031 THRU -033

STARTING POINT: C/L OF QUARRY AND JONES RD

21-04393

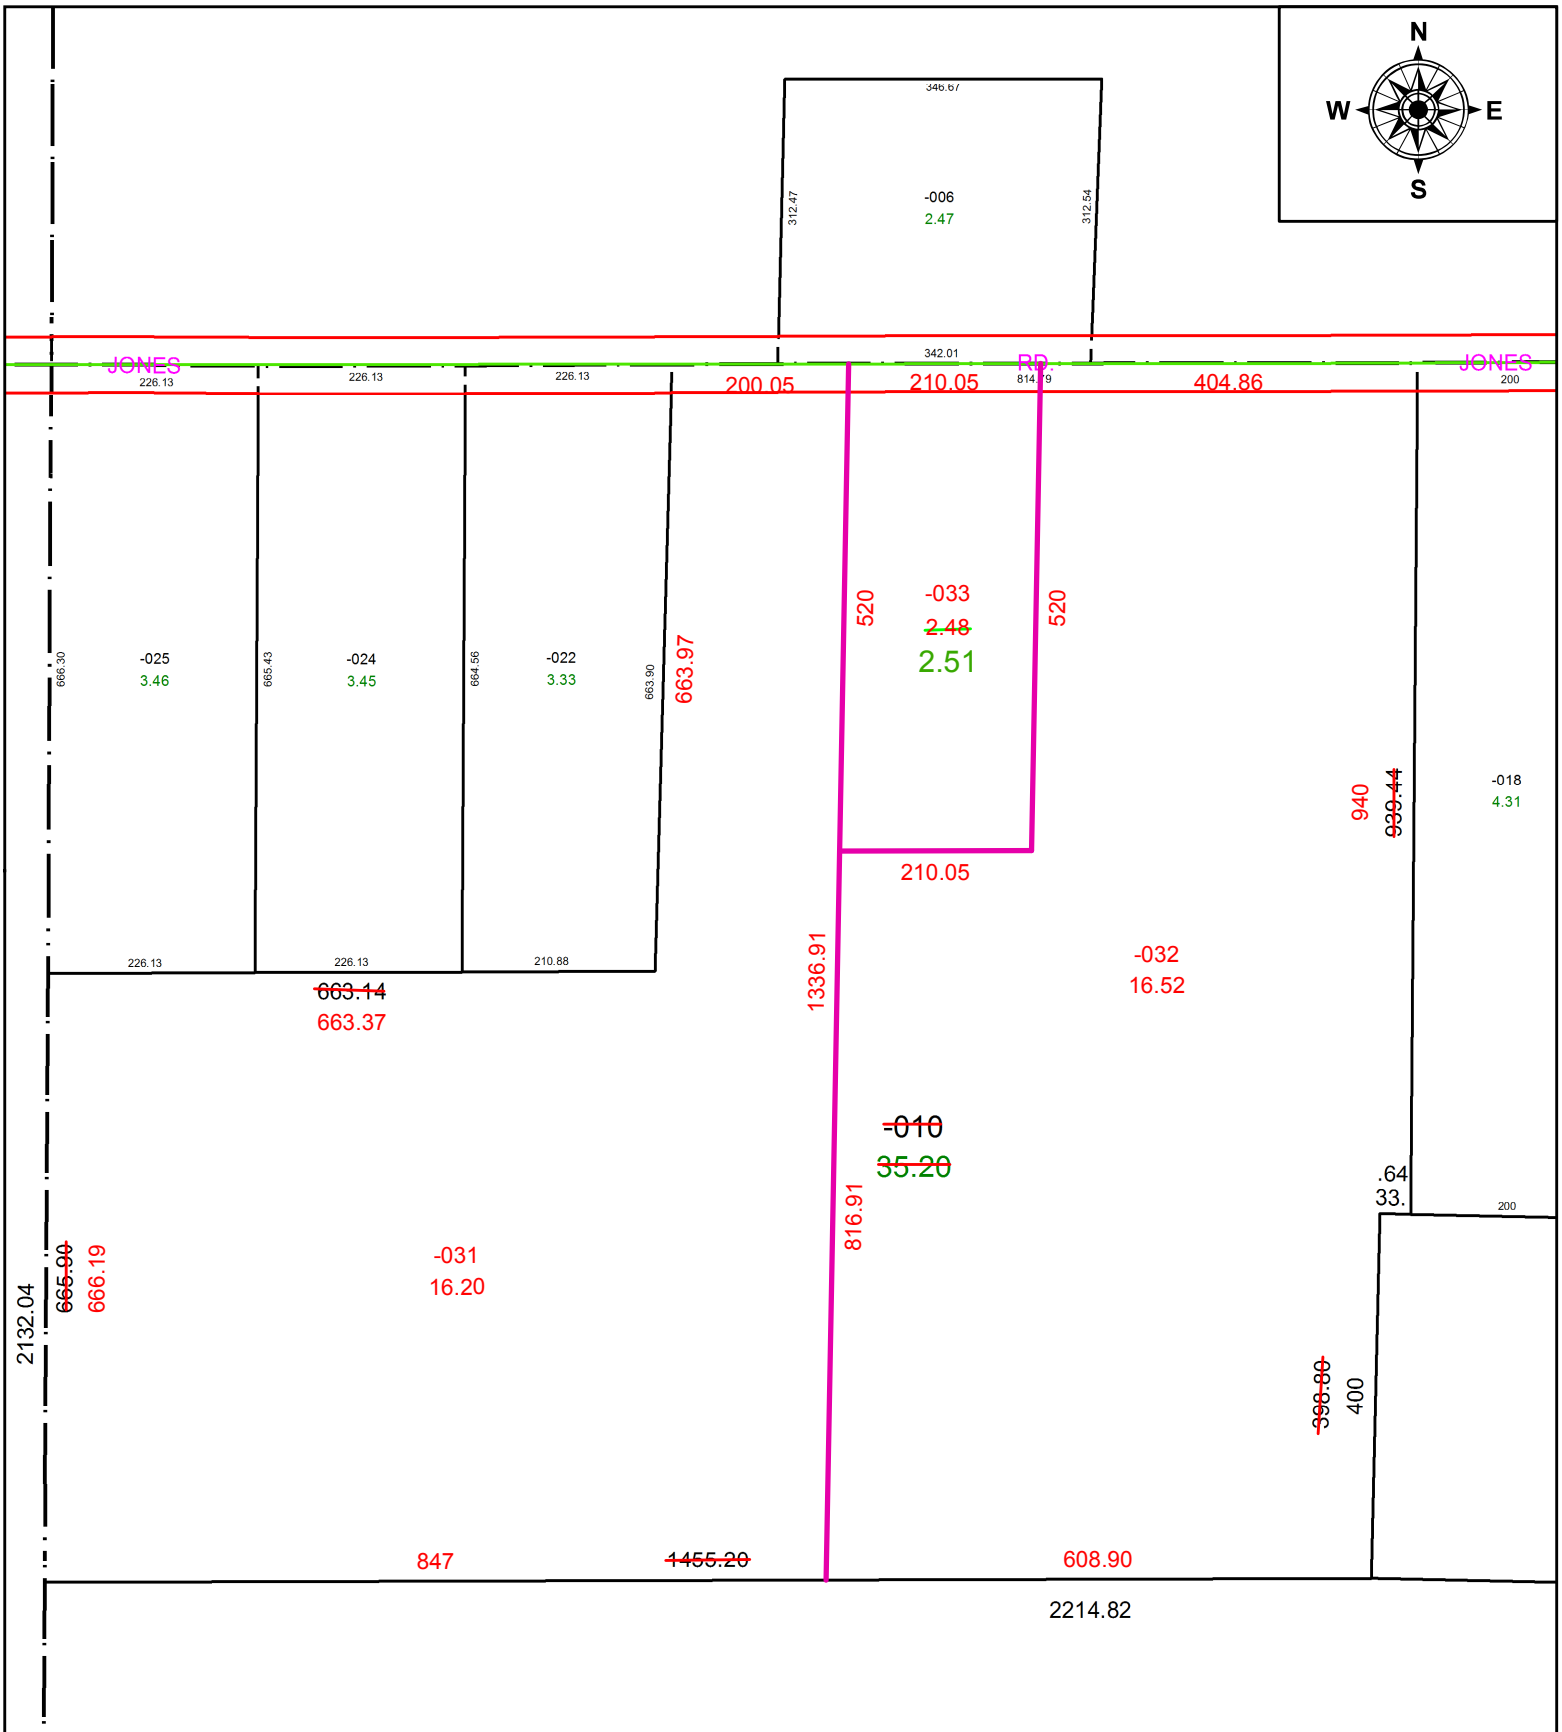

SPLITS/DEEDS PROCESSED

LORAIN COUNTY TAX MAP DEPARTMENT
226 MIDDLE AVE. ELYRIA, OH

SURVEYED BY: JAMES ALLEN COTTRELL
CLOSURE: 1: 1814350
MAP PAGE(S): 17-06-032-A
APPOVED BY: AC **DATE:** 10/21/2021
SCALE: 1" = 210 **PRIOR INSTRUMENT:** 2011- 0390551