PARENT PARCEL: 16-00-019-101-002, -003

CHILD PARCEL: 16-00-019-101-023, -024 **AC CORR PER SURV BY THOMAS SIMON**

STARTING POINT: SW CORNER OF O/L 19 AND ALONG C/L OF CROOK ST

21-04396

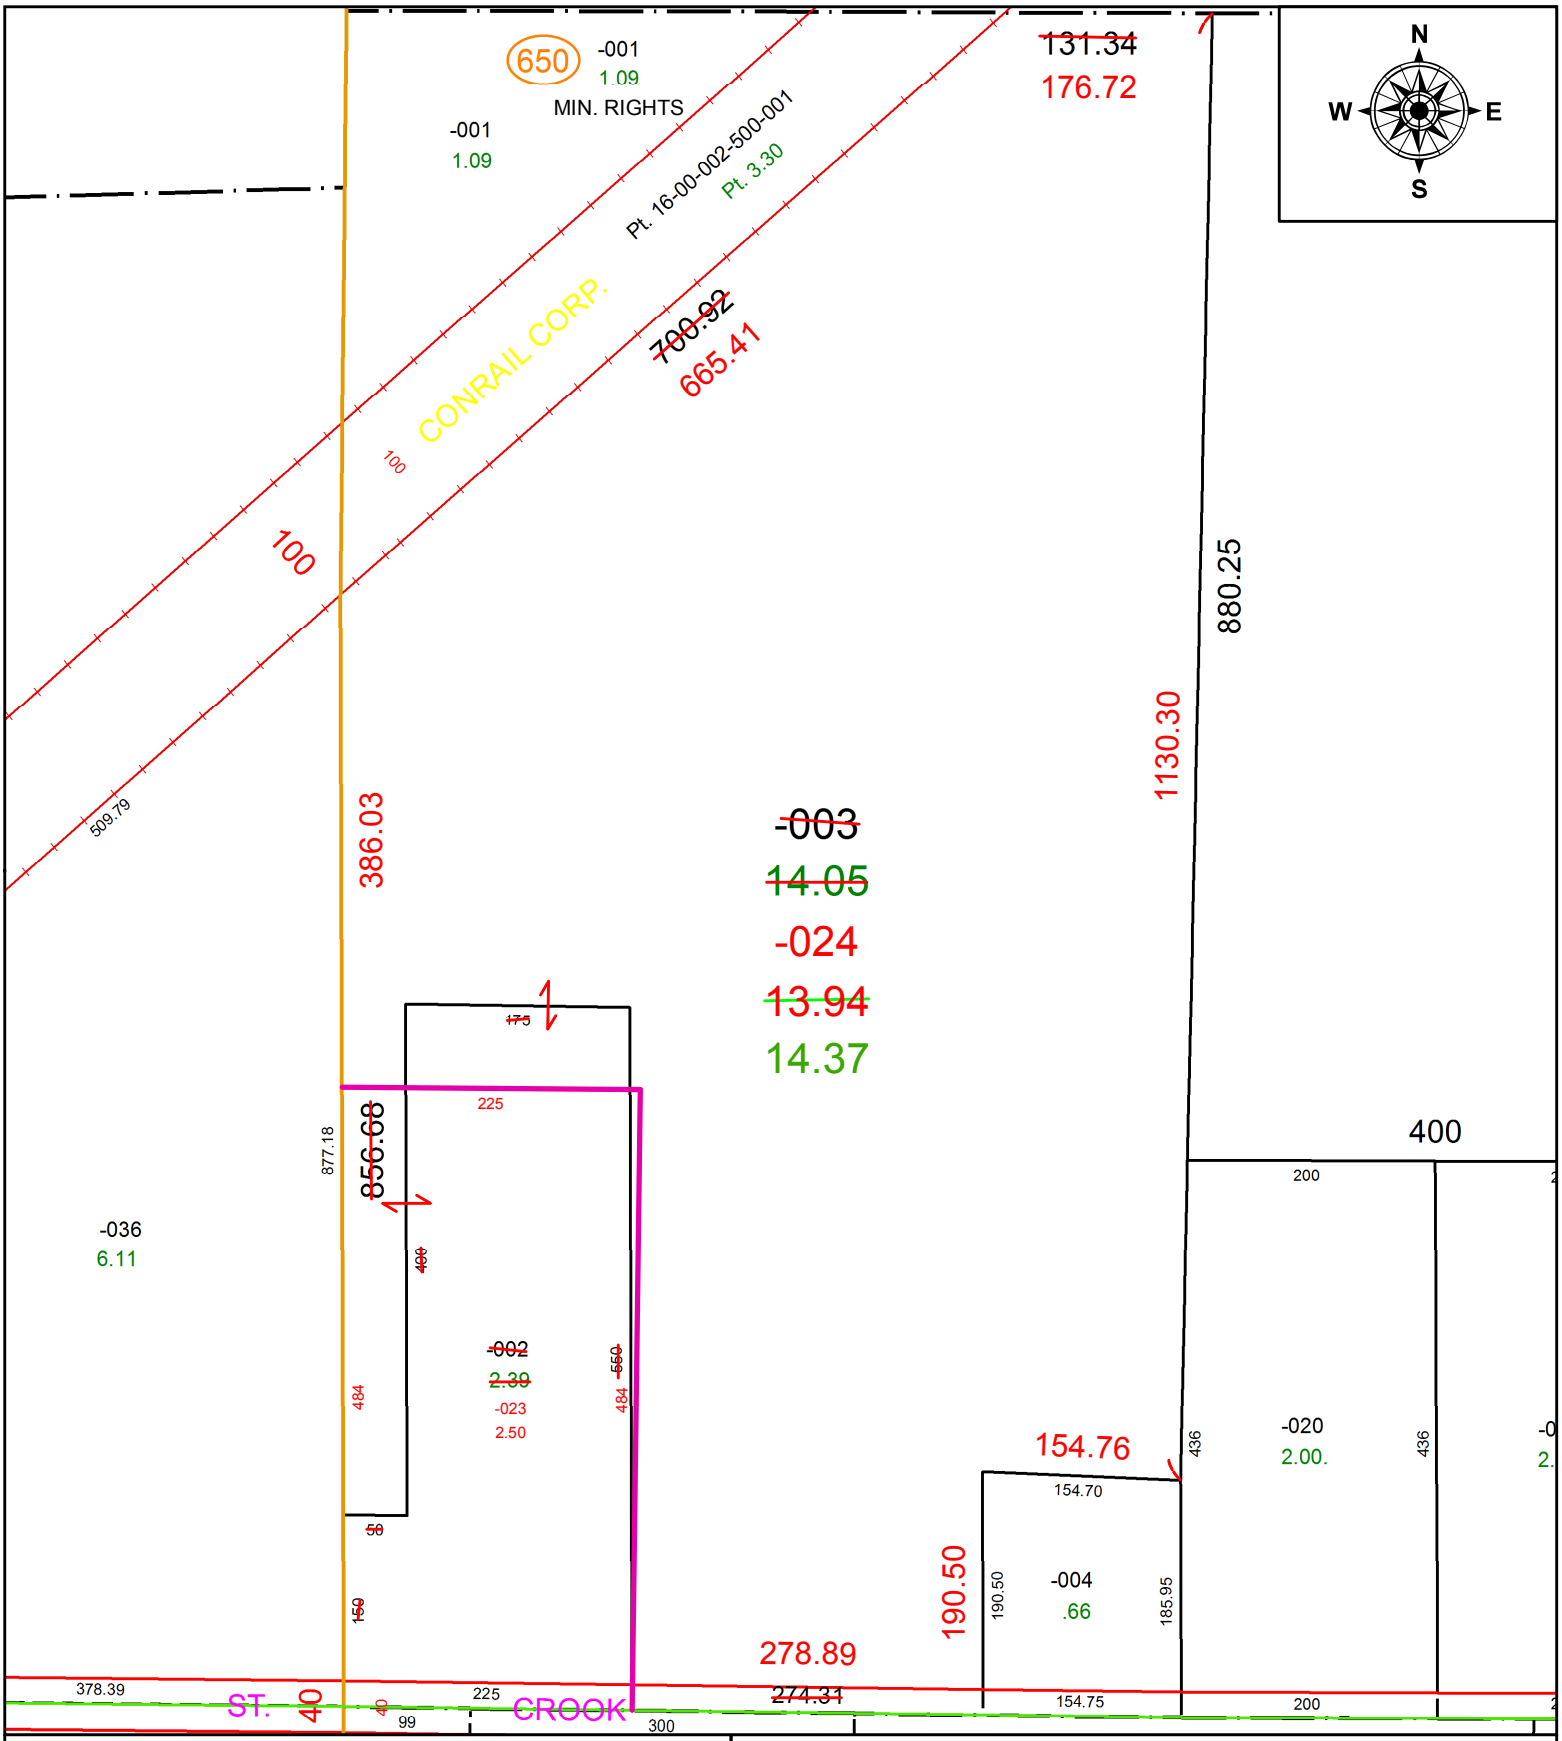

SPLITS/DEEDS PROCESSED

LORAIN COUNTY TAX MAP DEPARTMENT
226 MIDDLE AVE. ELYRIA, OH

SURVEYED BY: THOMAS A. SIMON
CLOSURE: 1: 2147483648
MAP PAGE(S): 16-00-019
APPOVED BY: AC **DATE:** 10/27/2021
SCALE: 1" = 150 **PRIOR INSTRUMENT:** 2020- 0747442