PARENT PARCEL: 03-00-015-000-049 & -061

CHILD PARCEL: 03-00-015-000-063

STARTING POINT: CL OF ABBE RD & FRENCH CREEK RD

21-04403

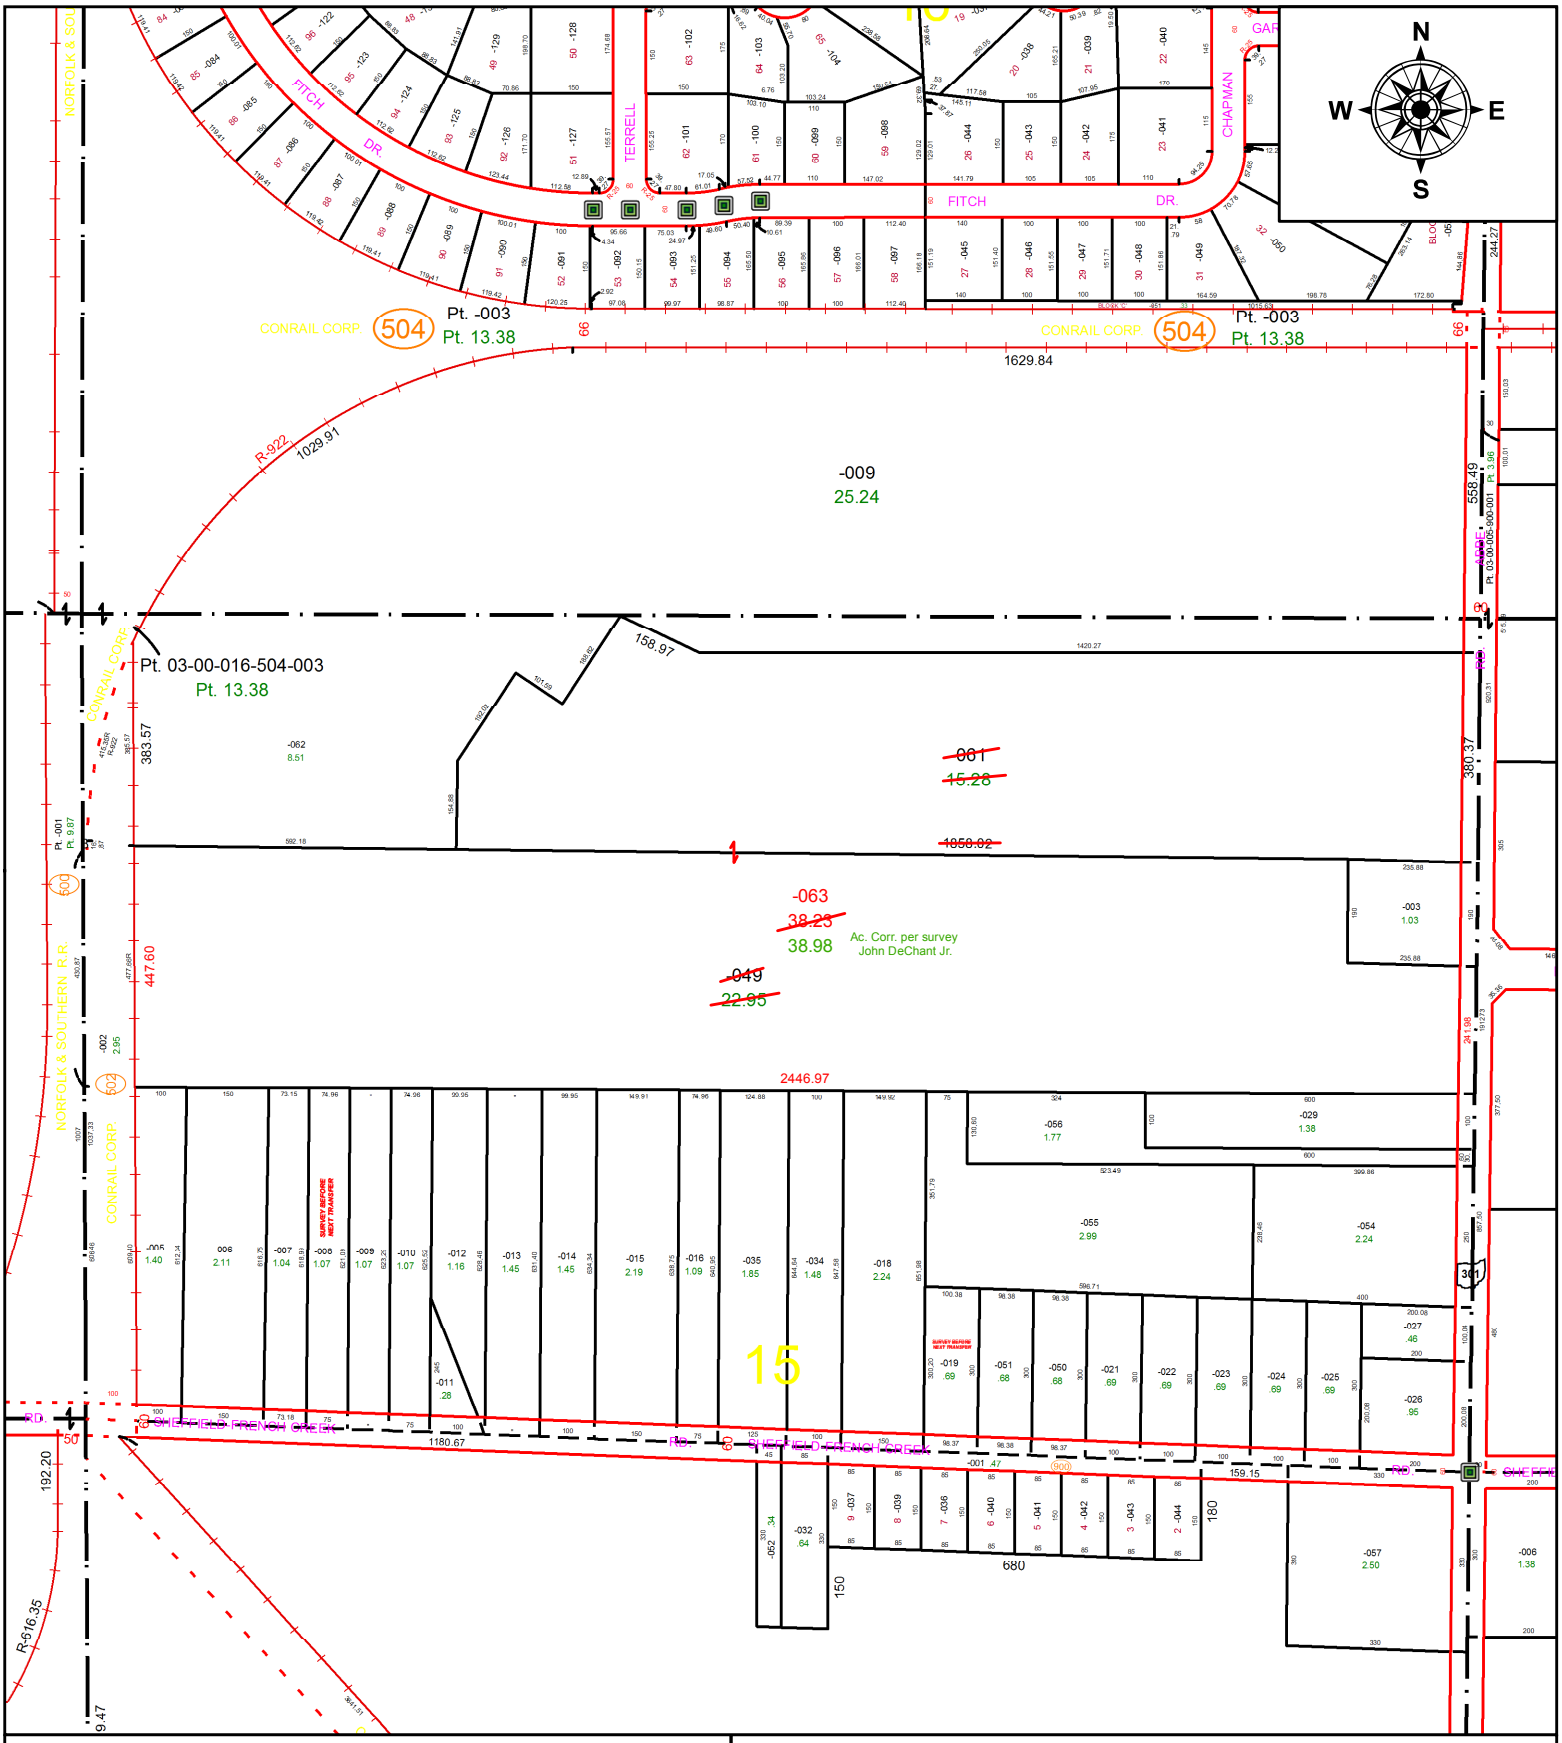

SPLITS/DEEDS PROCESSED

LORAIN COUNTY TAX MAP DEPARTMENT
226 MIDDLE AVE. ELYRIA, OH

SURVEYED BY: JOHN A. DeCHANT JR.
CLOSURE: 1: 1,406,614
MAP PAGE(S): 03-00-015
APPOVED BY: DMA **DATE:** 11/5/2021
SCALE: 1" = 350' **PRIOR INSTRUMENT:** 20190713790 & 20210842224