PARENT PARCEL: 09-00-033-000-013, 09-00-034-000-011, -013

CHILD PARCEL: 09-00-033-000-019, -020, -021, -022, 09-00-034-000-011, -013

STARTING POINT: NE CORNER OF O/L 33

21-04405

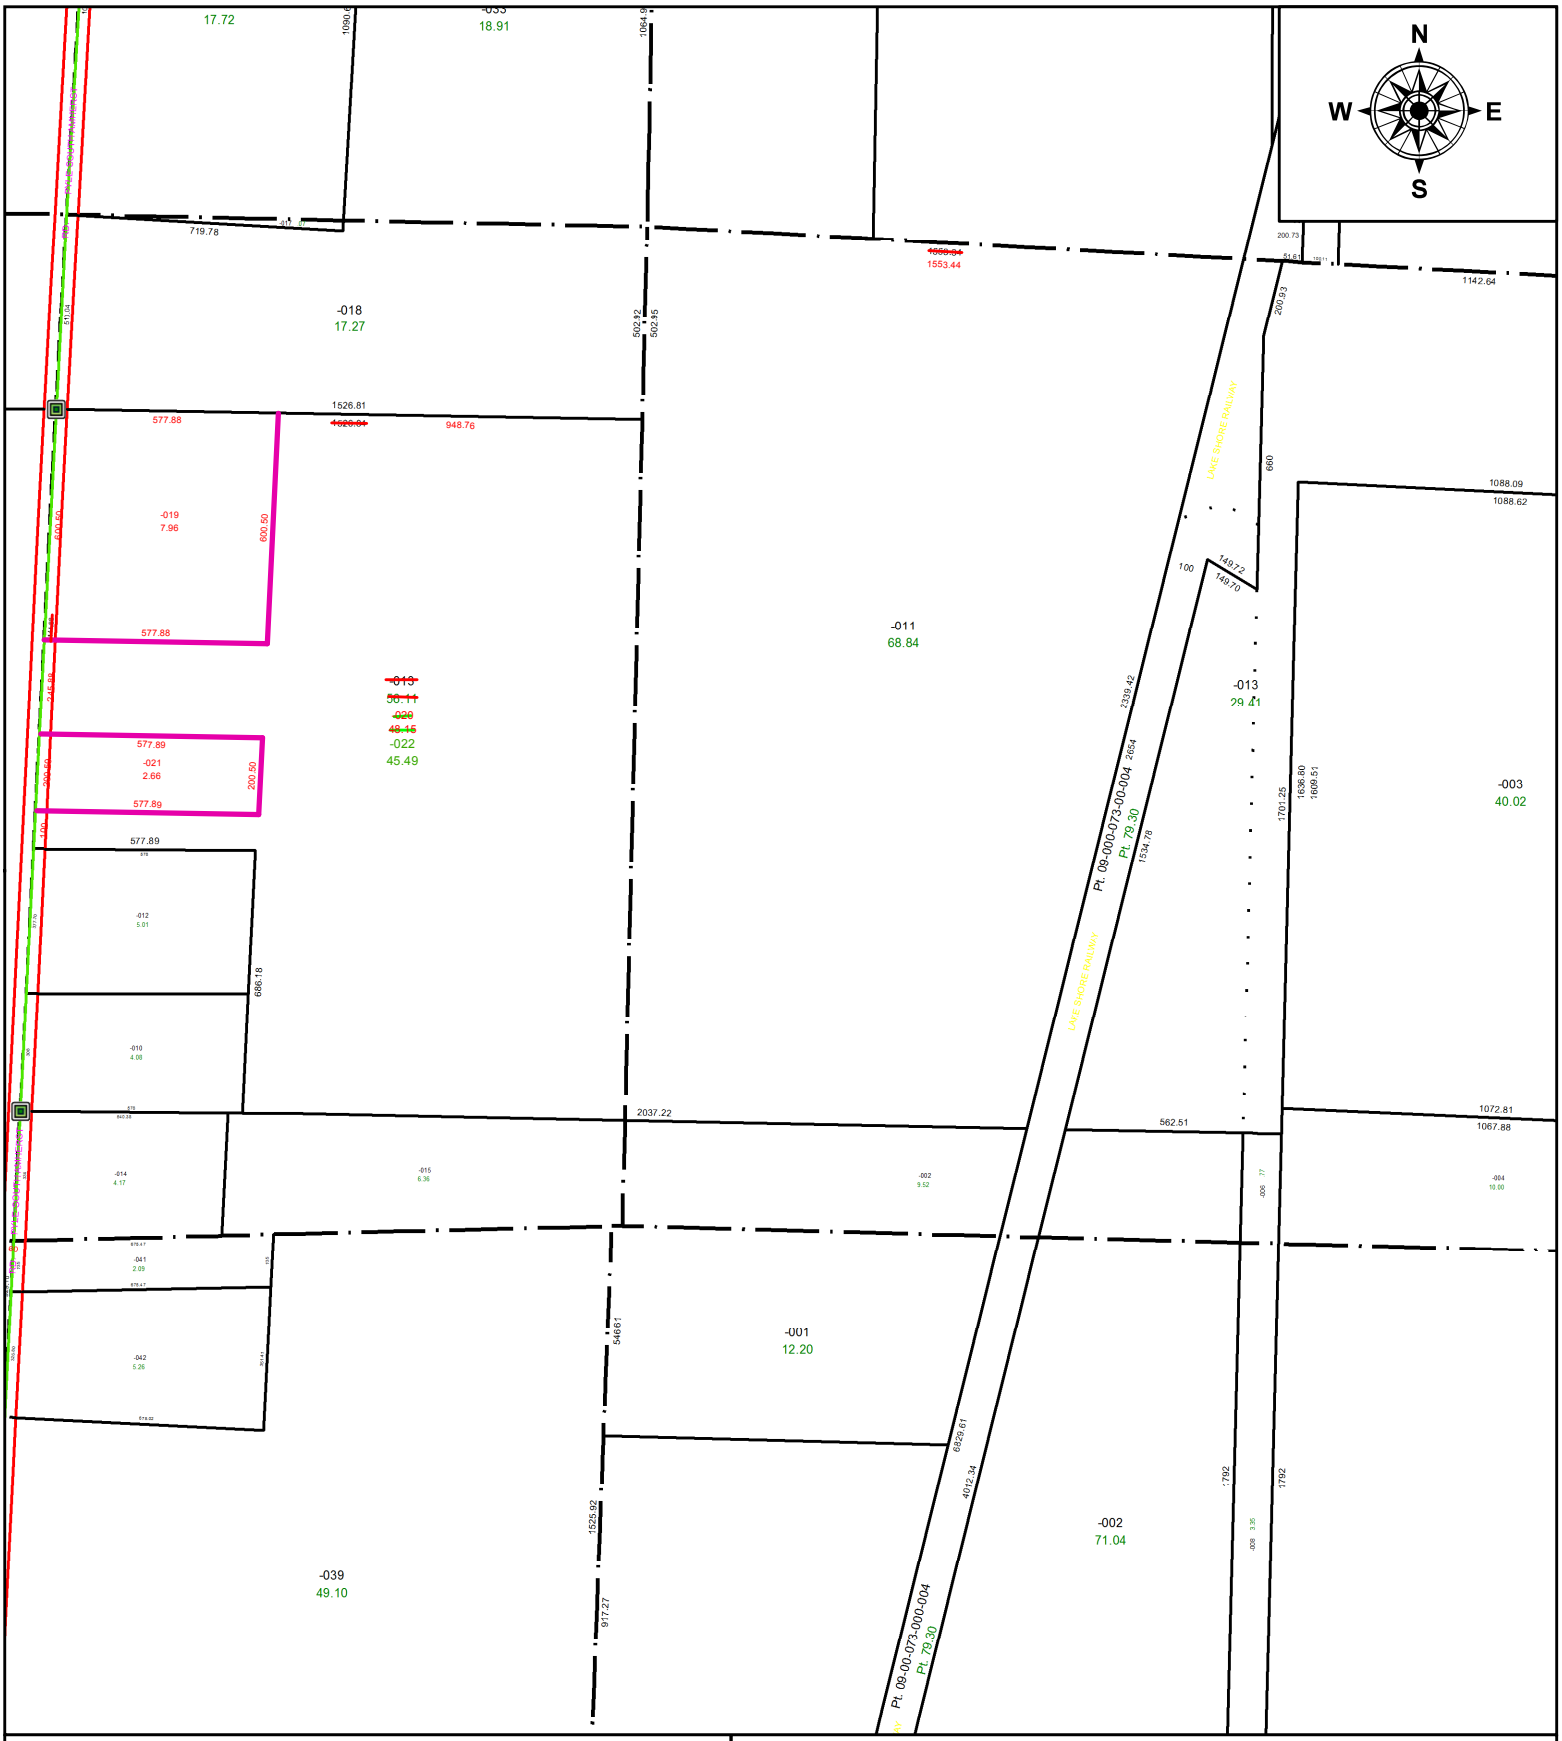

SPLITS/DEEDS PROCESSED

LORAIN COUNTY TAX MAP DEPARTMENT
226 MIDDLE AVE. ELYRIA, OH

SURVEYED BY: TIMOTHY D. HOZALSKI
CLOSURE: 1: 2147483648
MAP PAGE(S): 09-00-033-B, 09-00-034-A,B
APPOVED BY: AC **DATE:** 11/10/2021
SCALE: 1" = 550 **PRIOR INSTRUMENT:** 2018- 0670720