PARENT PARCEL: 03-00-108-112-006

CHILD PARCEL: 03-00-108-112-065, -066

STARTING POINT: S/L 144 AND SOUTH 10 FT OF S/L 145 IN HILL'S ALLOT.

20-04408-U

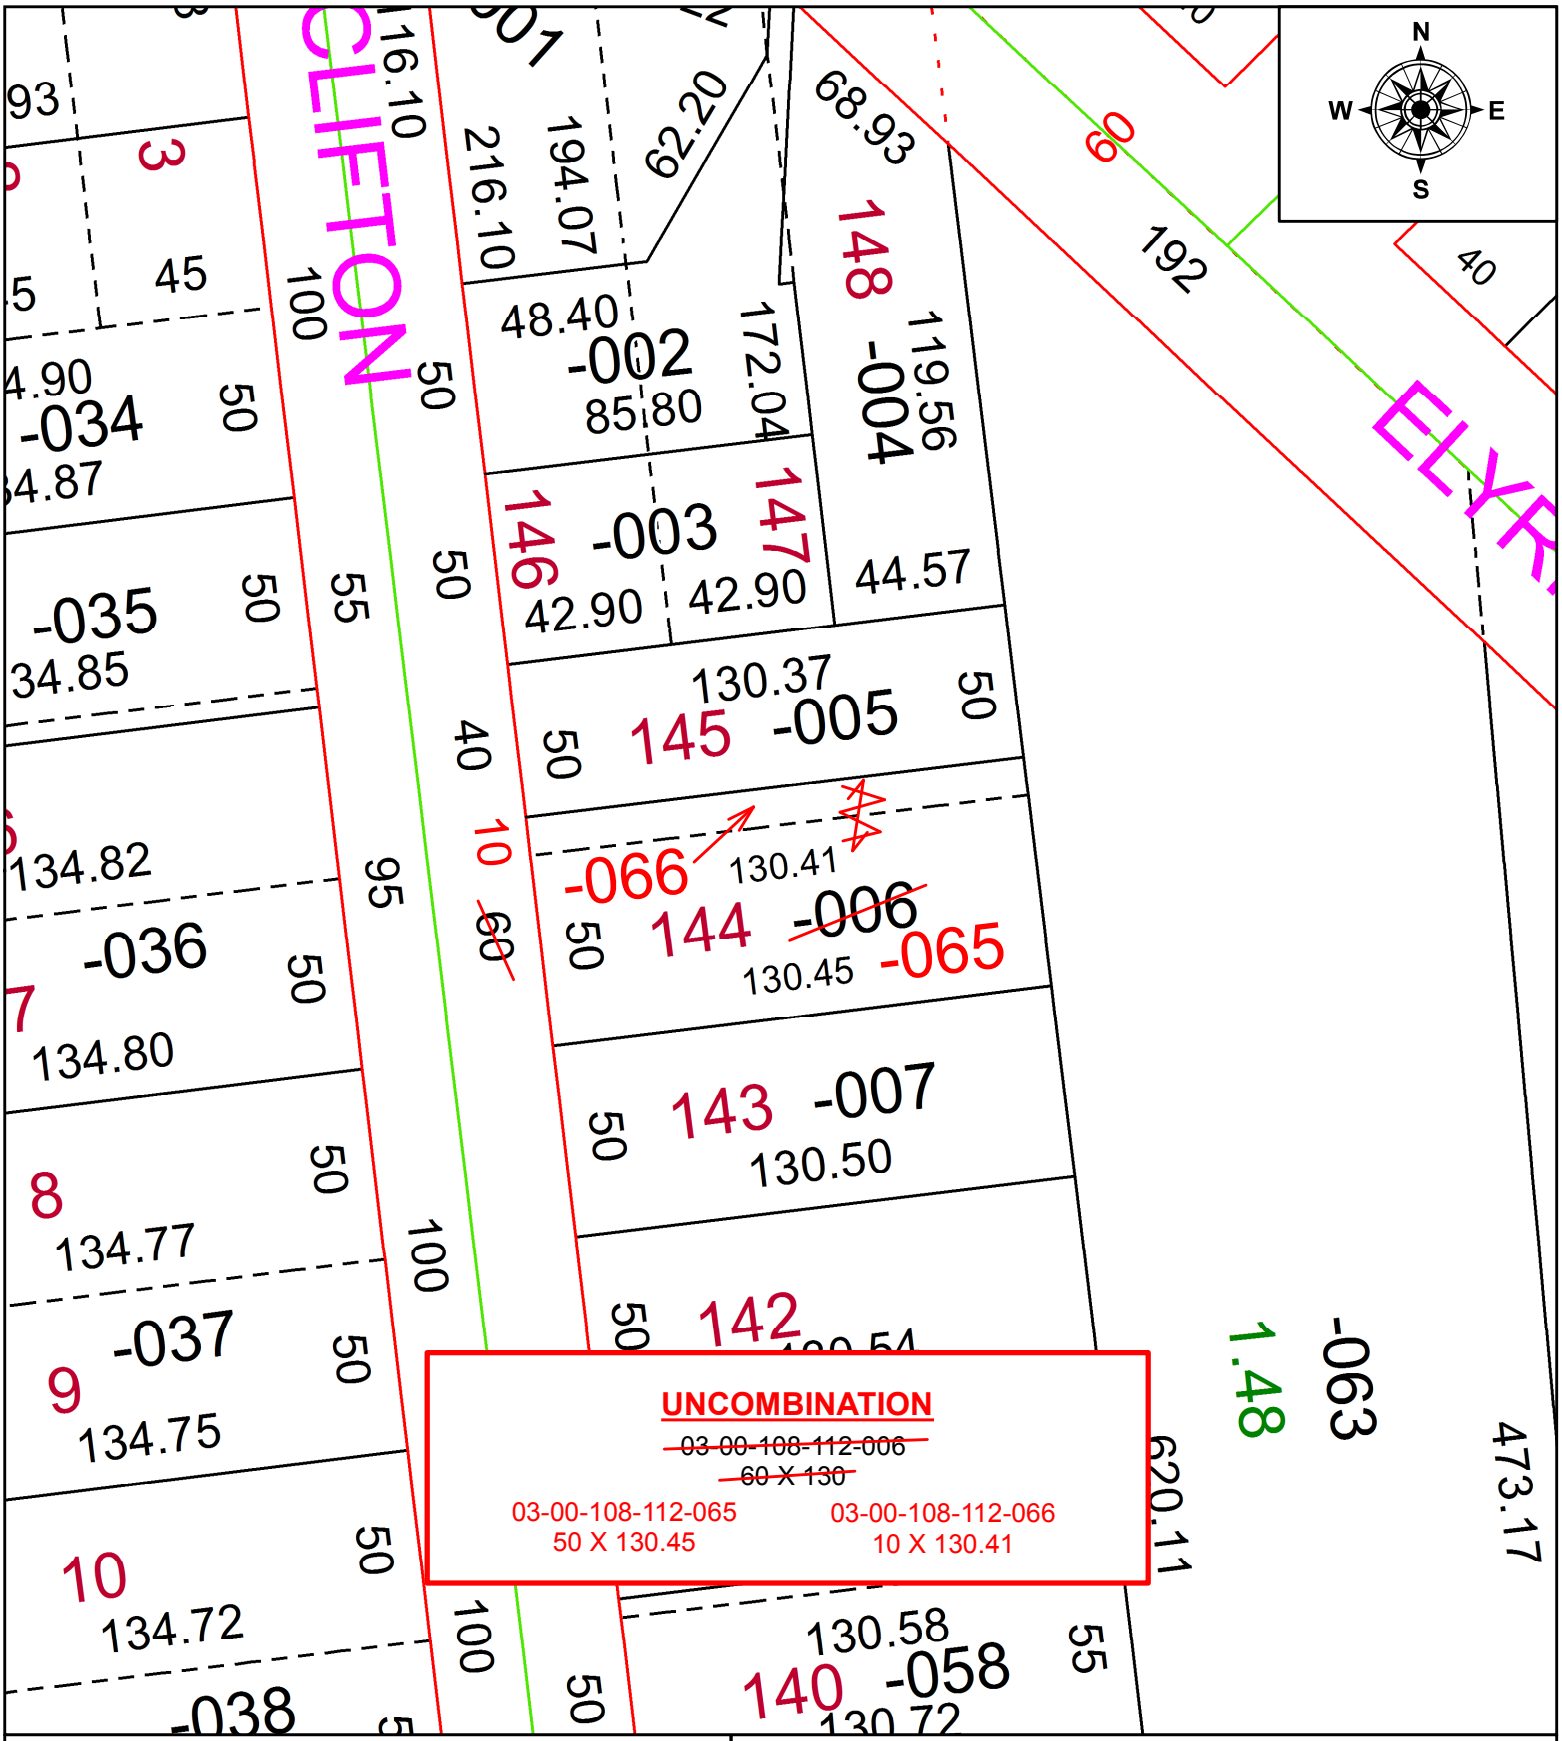

SPLITS/DEEDS PROCESSED

LORAIN COUNTY TAX MAP DEPARTMENT
226 MIDDLE AVE. ELYRIA, OH

SURVEYED BY: N/A
CLOSURE: N/A
MAP PAGE(S): 3-00-108
APPOVED BY: RRM **DATE:** 9-29-20
SCALE: 1" = 50 **PRIOR INSTRUMENT:** OR 1287/726