PARENT PARCEL: 01-00-026-000-050

CHILD PARCEL:

STARTING POINT: INTERSECTION OF C/L OF BAUMHART RD. AND C/L OF WHITTLESEY RD.

20-04416-A

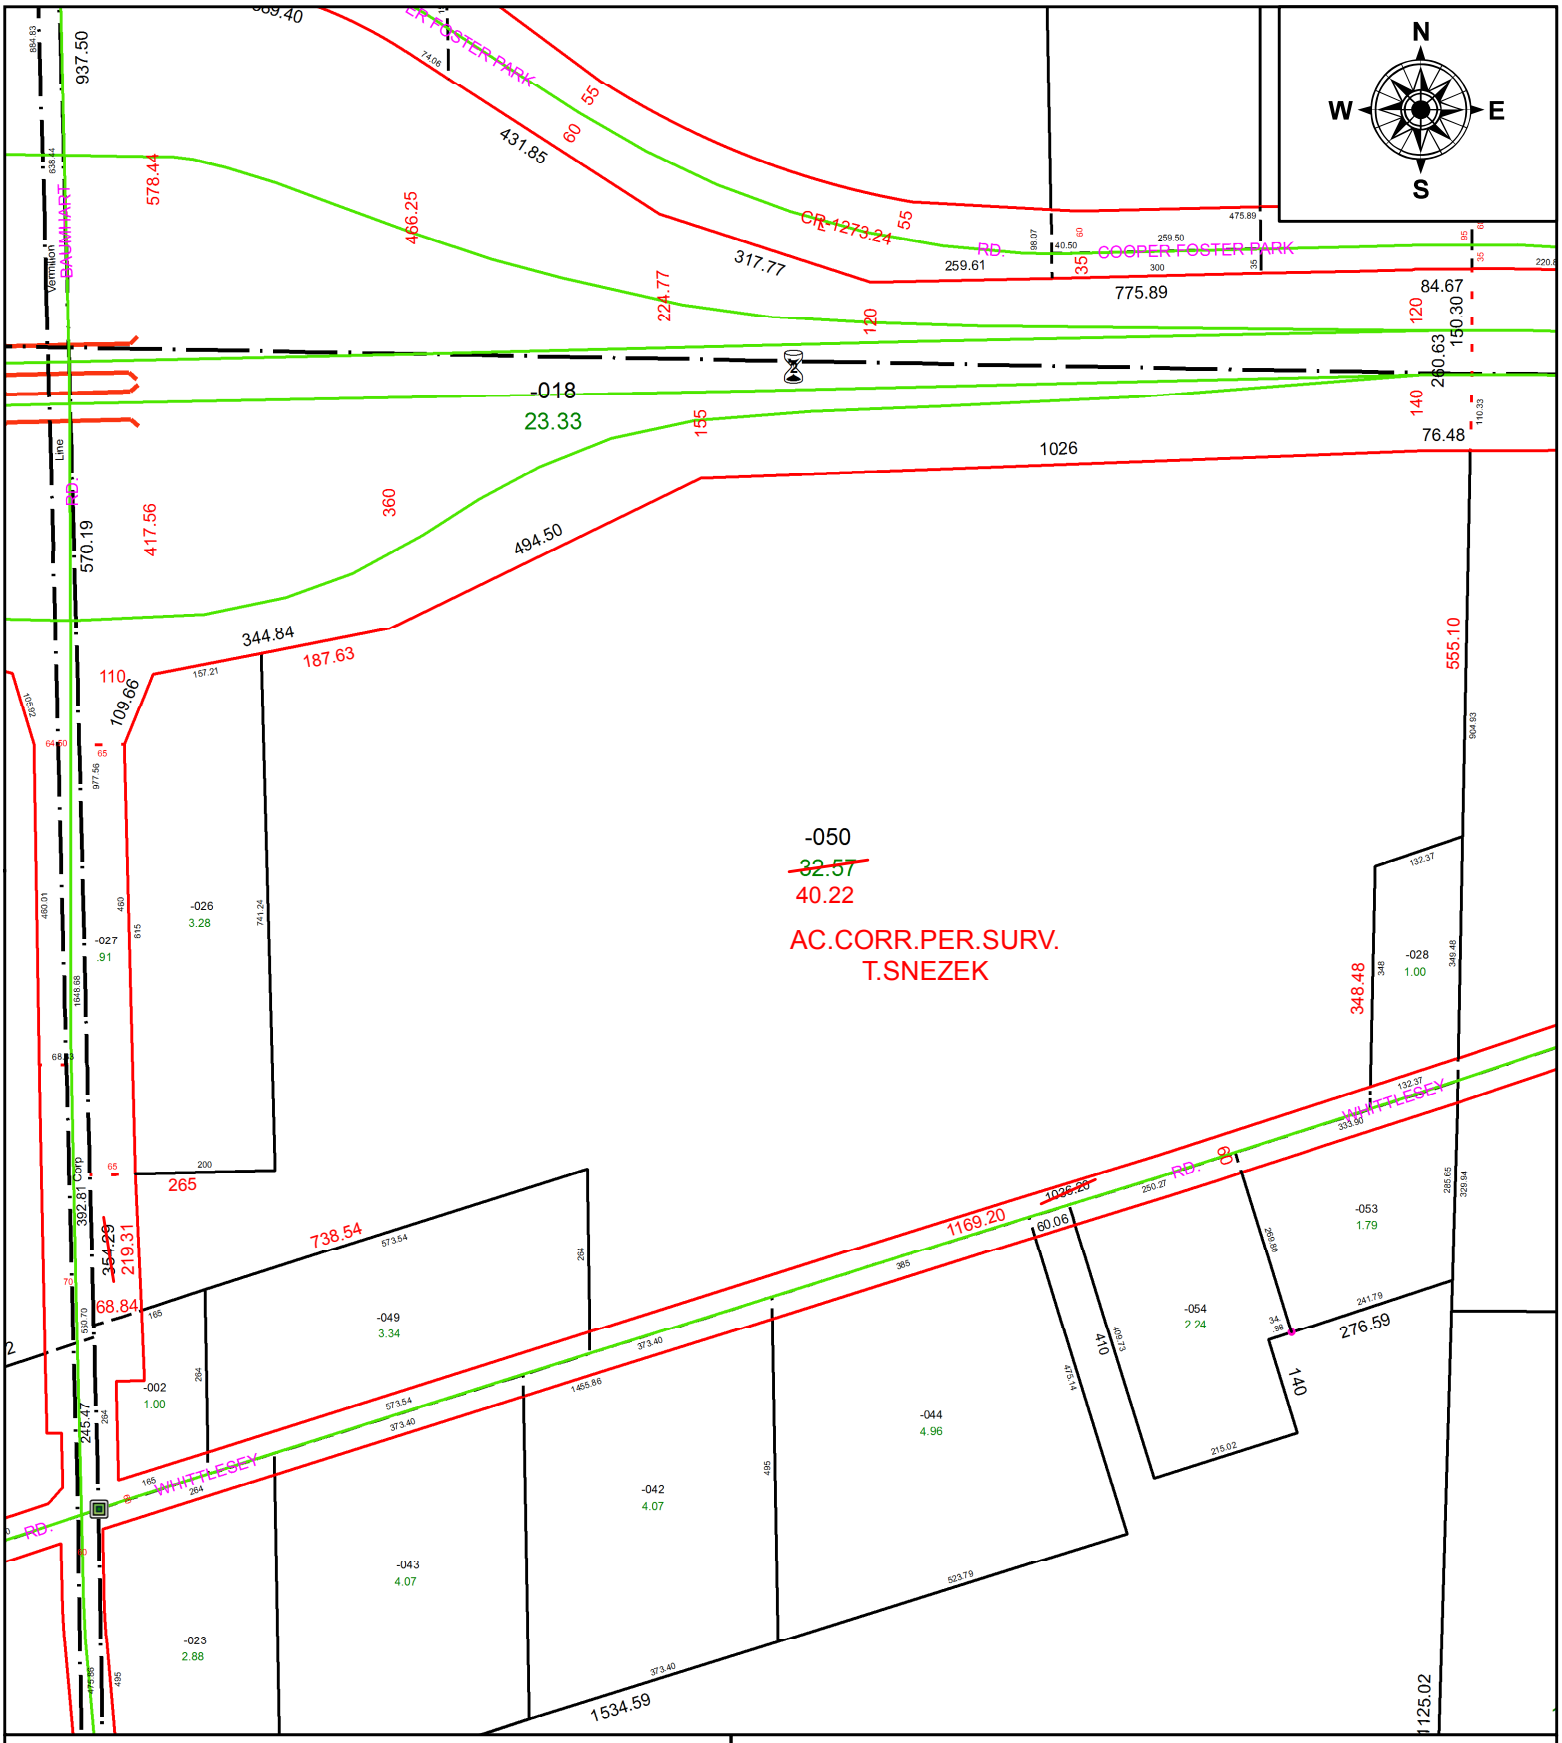

SPLITS/DEEDS PROCESSED

LORAIN COUNTY TAX MAP DEPARTMENT
226 MIDDLE AVE. ELYRIA, OH

SURVEYED BY: THOMAS M. SNEZEK
CLOSURE: 1:694,749
MAP PAGE(S): 1-00-026
APPOVED BY: RRM **DATE:** 10-20-20
SCALE: 1" = 275 **PRIOR INSTRUMENT:** 20000667960