PARENT PARCEL: 15-00-009-000-028

CHILD PARCEL: 15-00-009-000-032 & -033

STARTING POINT: INTERSECTION OF C/L OF PARSONS RD & WEST LINE OF OL 9

21-04417

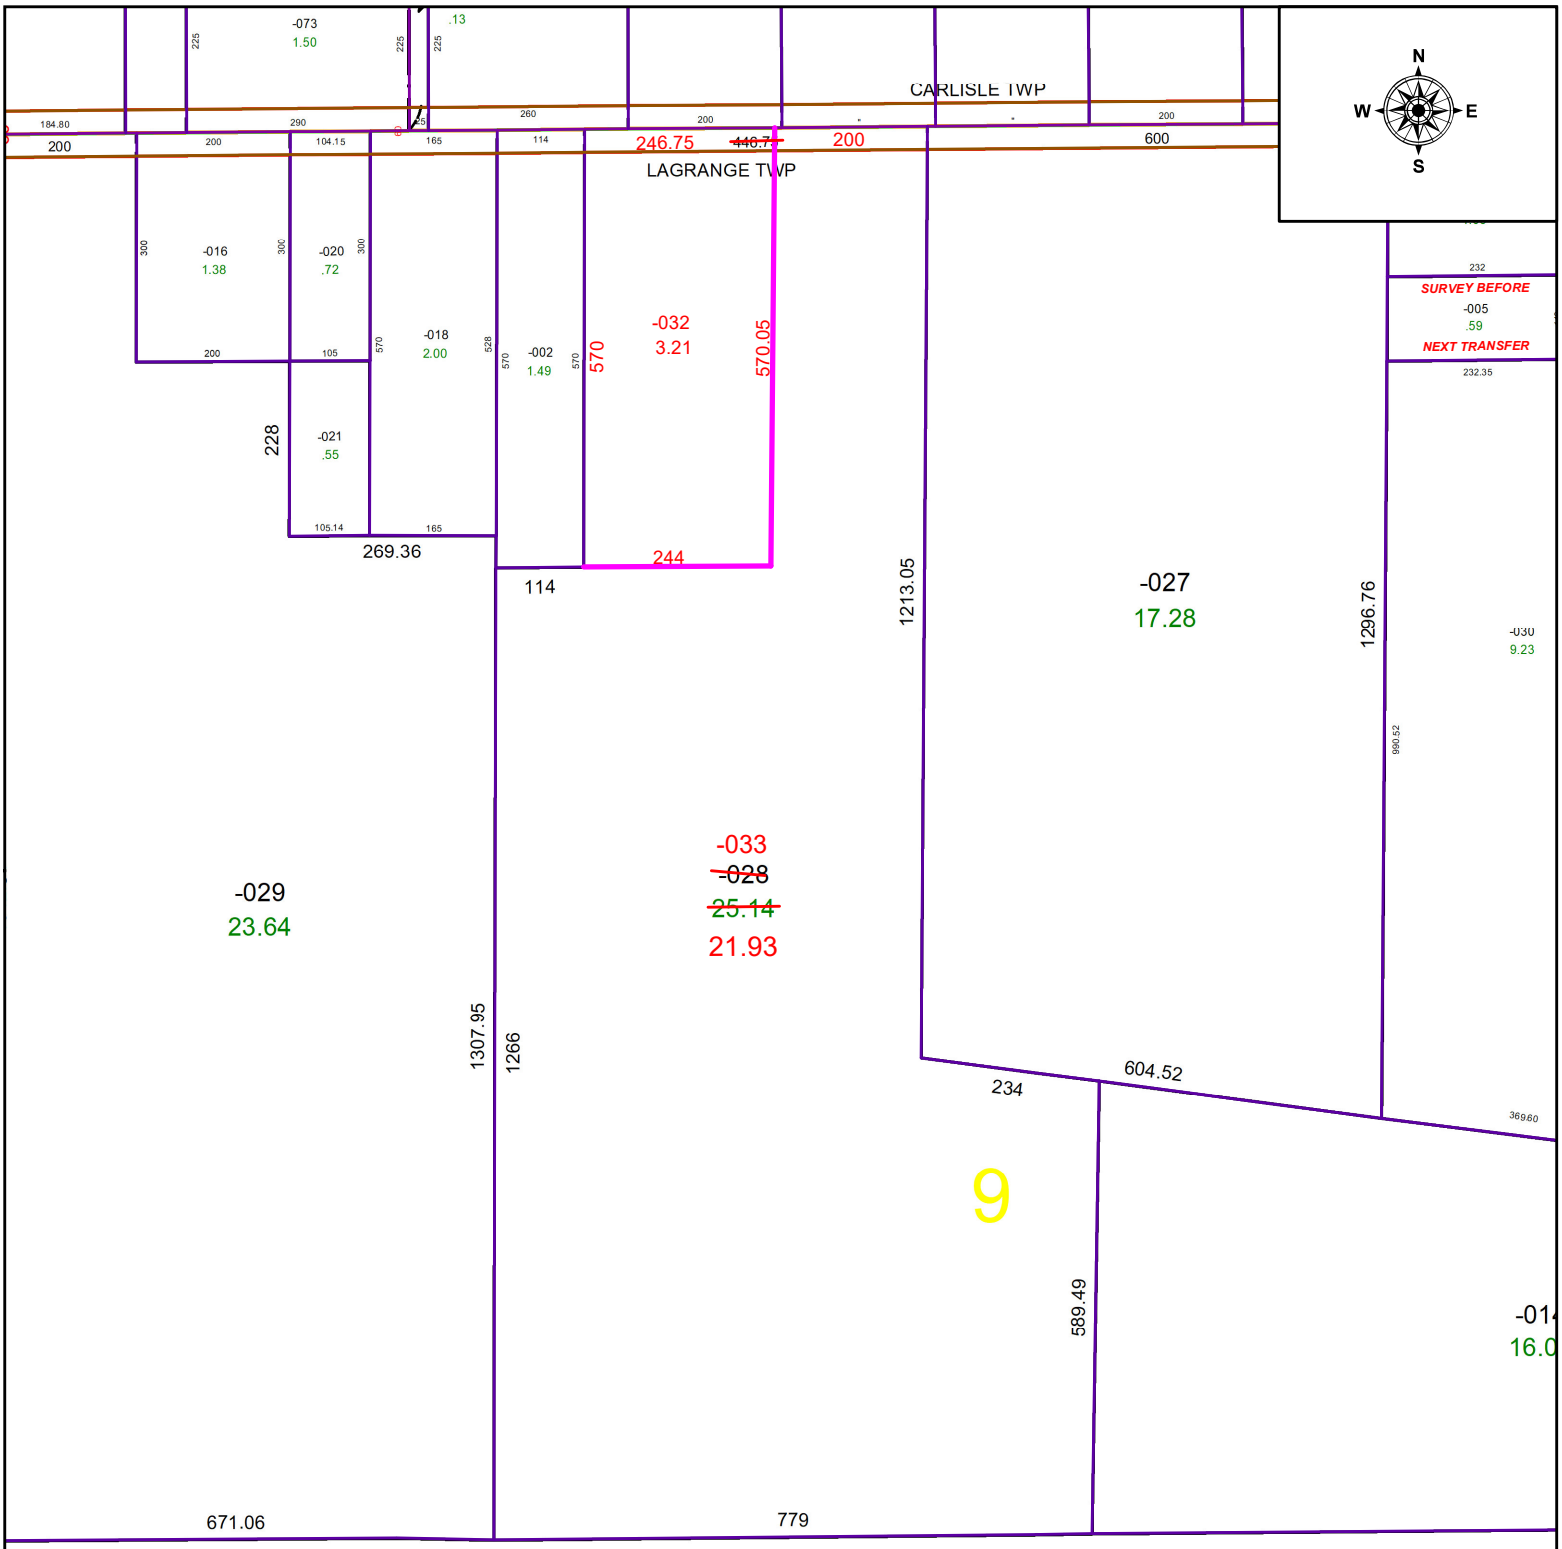

SPLITS/DEEDS PROCESSED

LORAIN COUNTY TAX MAP DEPARTMENT
226 MIDDLE AVE. ELYRIA, OH

SURVEYED BY: GEORGE A HOFMANN
CLOSURE: 1: 118659
MAP PAGE(S): 15-00-009
APPOVED BY: WRZ **DATE:** 12/7/2021
SCALE: 1" = 250 **PRIOR INSTRUMENT:** 2009-0315220