PARENT PARCEL: 16-00-094-000-013 & -015

CHILD PARCEL: 16-00-094-000-017 THRU -021

STARTING POINT: SE CORNER OF O/L 93

21-04421

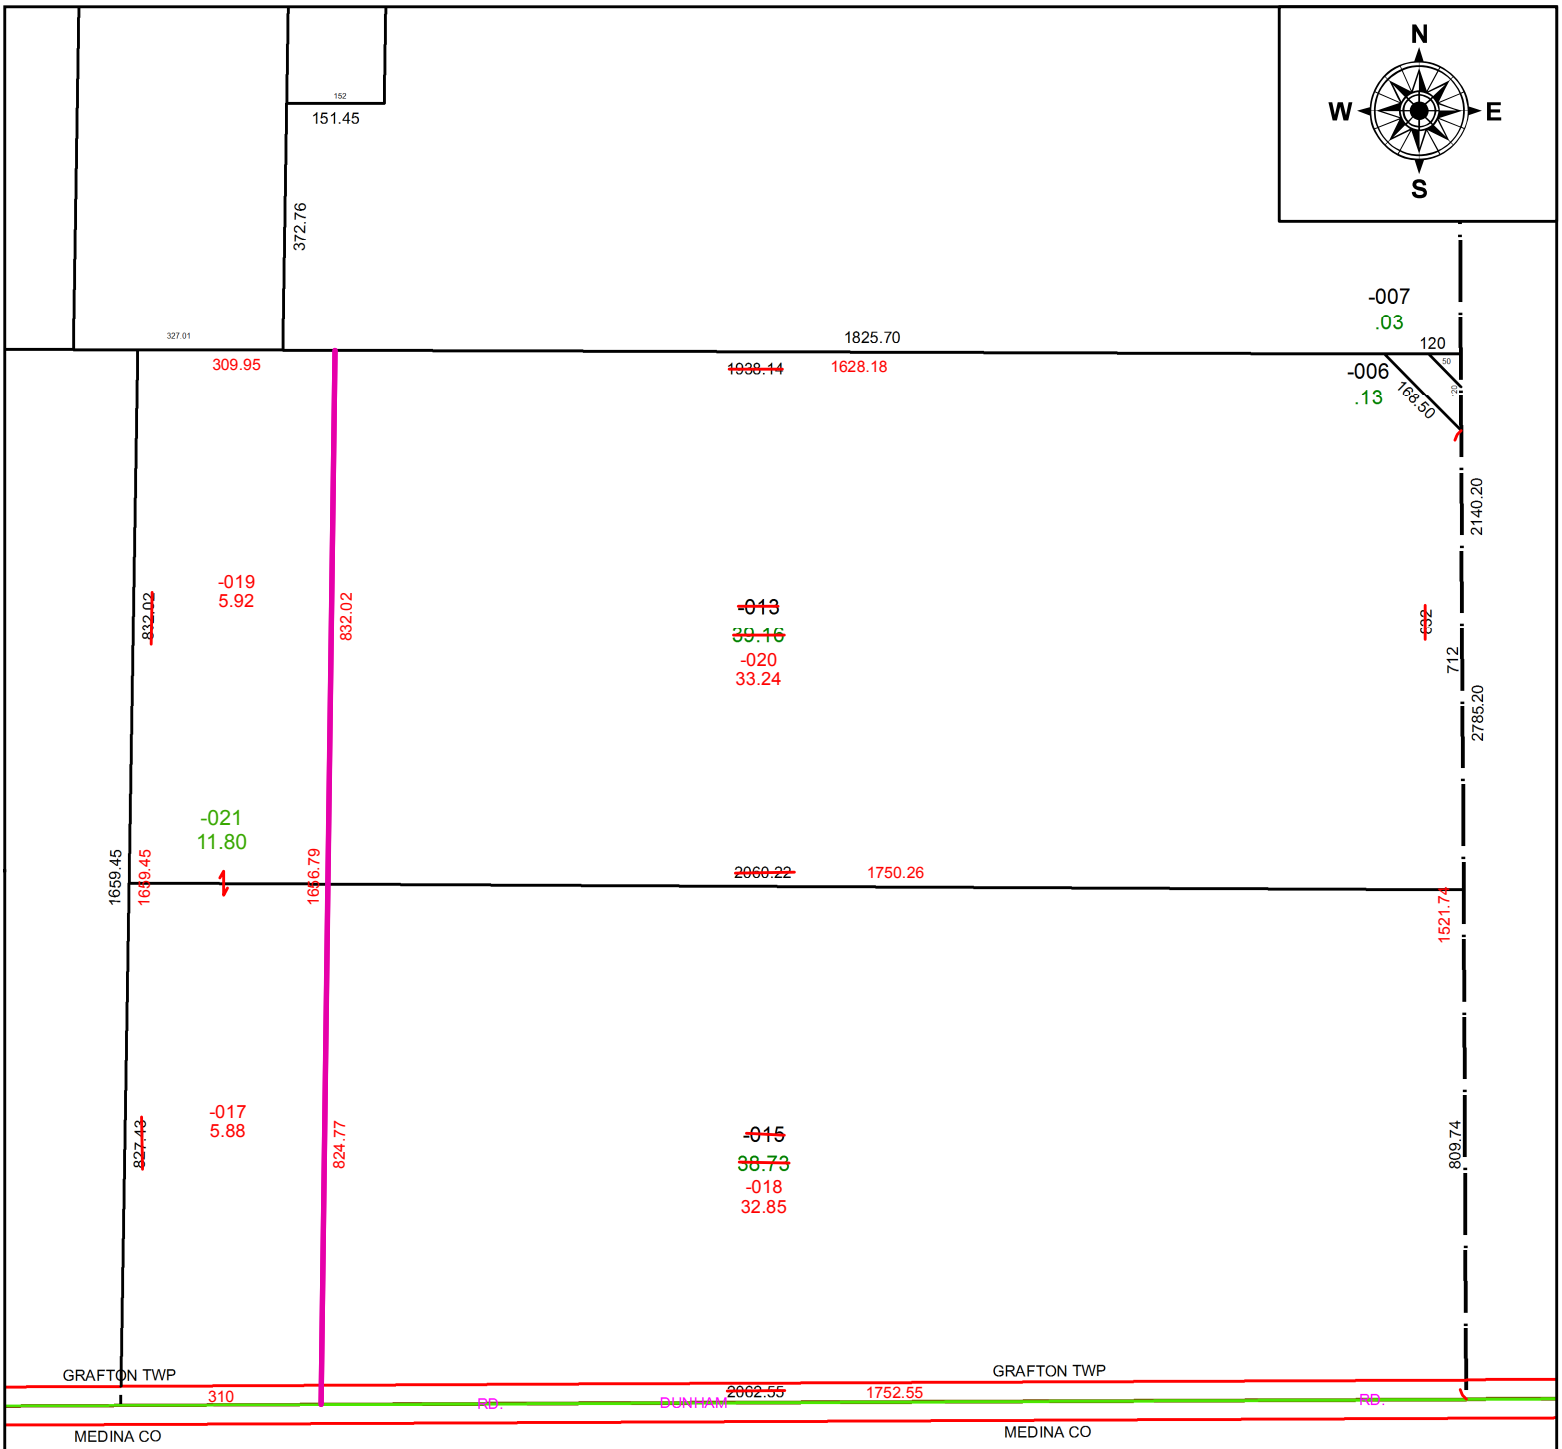

SPLITS/DEEDS PROCESSED

LORAIN COUNTY TAX MAP DEPARTMENT
226 MIDDLE AVE. ELYRIA, OH

SURVEYED BY: AMY M. KELLY
CLOSURE: 1: 340622
MAP PAGE(S): 16-00-094
APPOVED BY: AC **DATE:** 12/13/2021
SCALE: 1" = 300 **PRIOR INSTRUMENT:** 2011- 0364852