**PARENT PARCEL:** 06-26-070-000-013, -014
**CHILD PARCEL:** 06-26-070-000-020
**STARTING POINT:** FRONTAGE & DEPTH TO AC CORR PER SURVBY PATRICK A. MCGANNON

21-04422

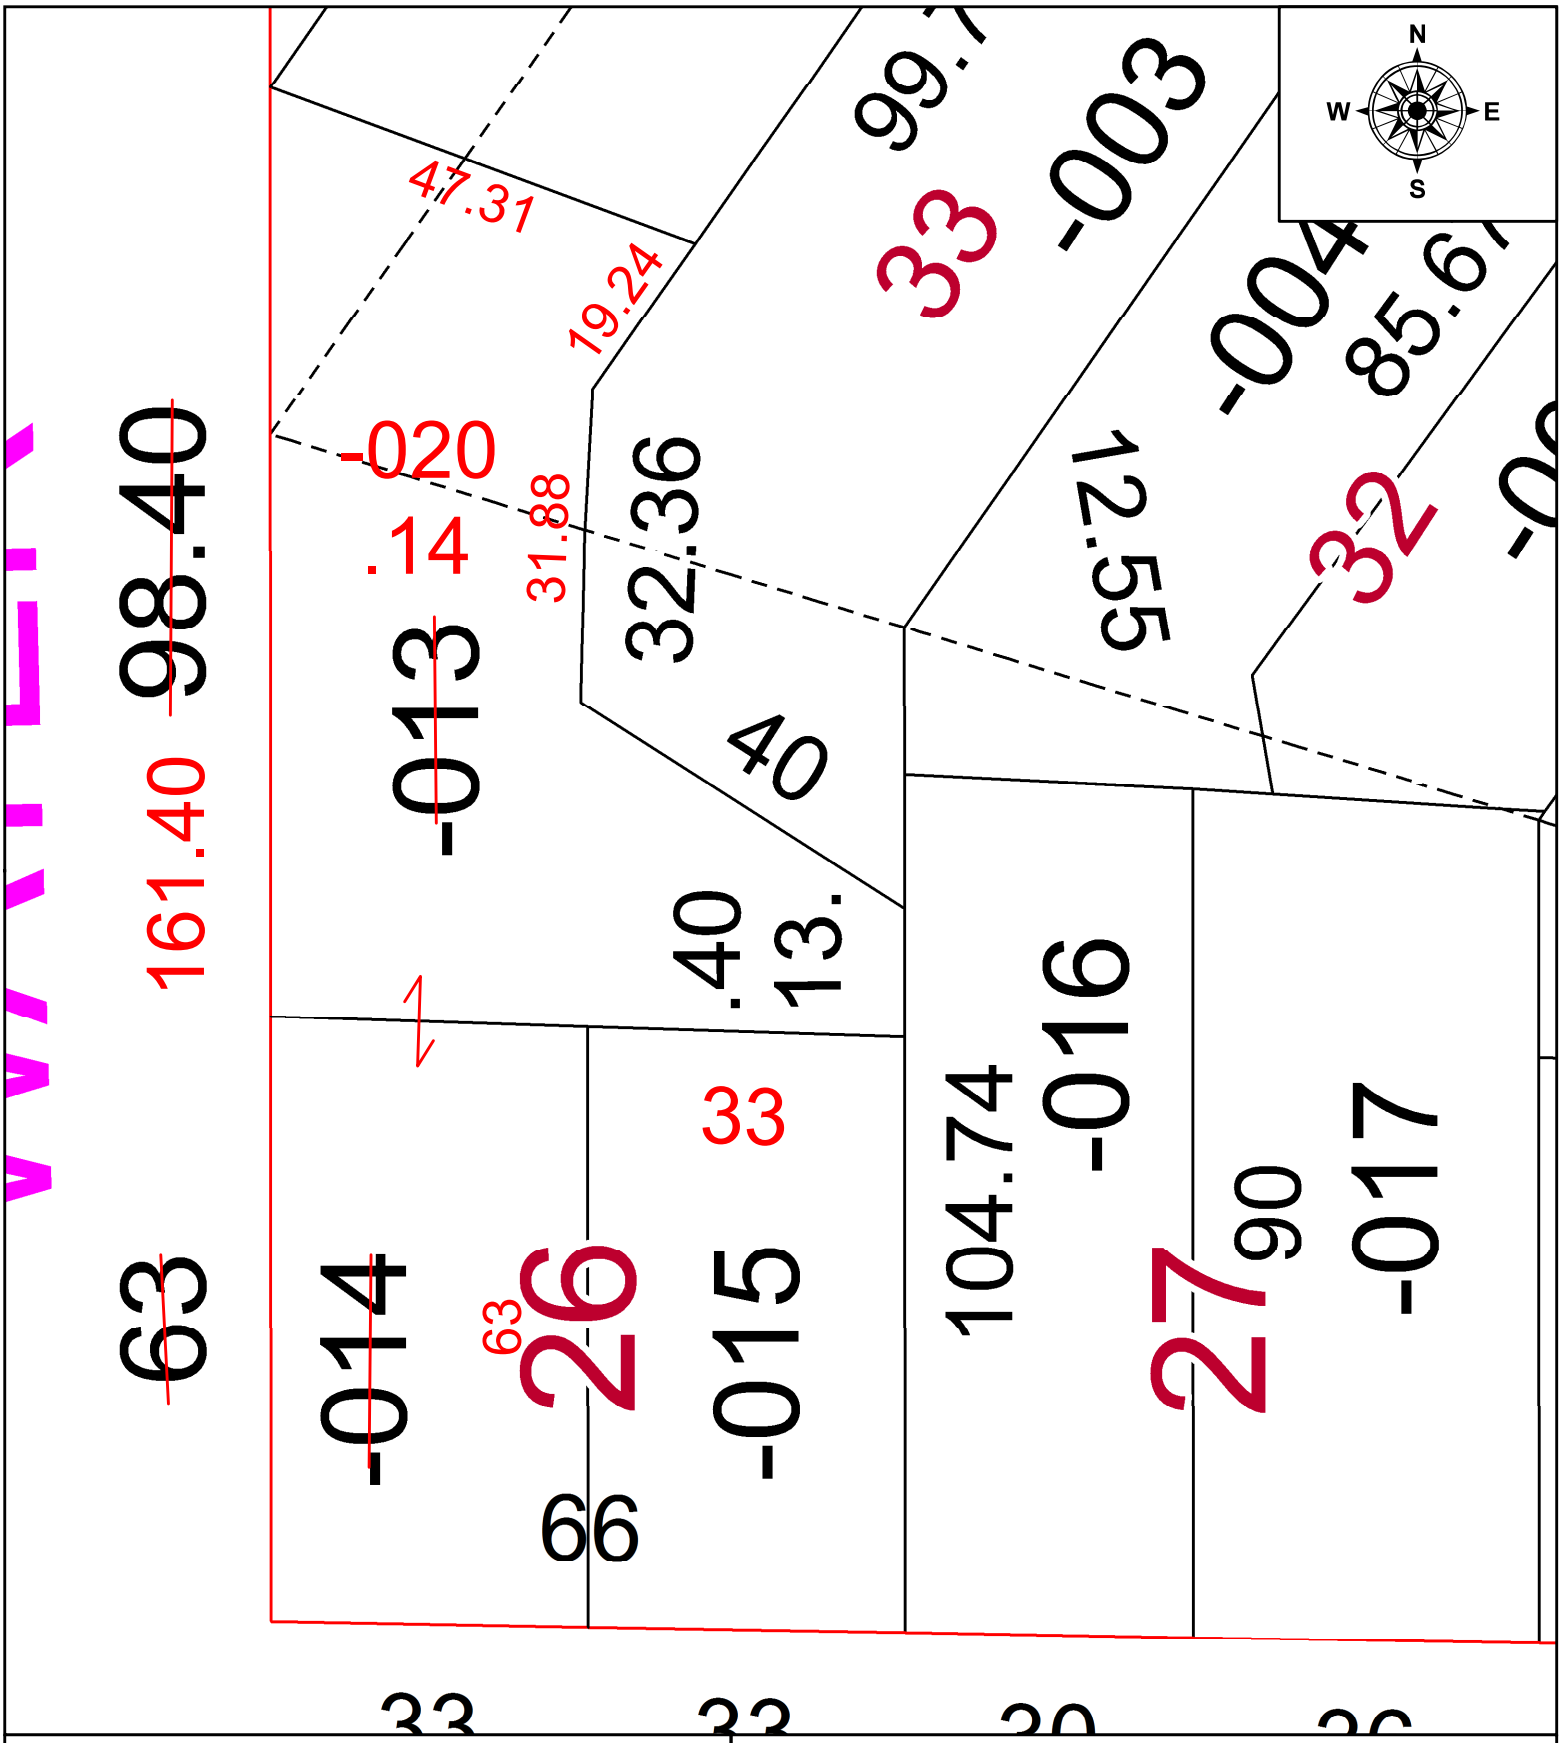


**SPLITS/DEEDS PROCESSED**
LORAIN COUNTY TAX MAP DEPARTMENT
226 MIDDLE AVE. ELYRIA, OH

**SURVEYED BY:** PATRICK A. MCGANNON
**CLOSURE:** 1: 106986
**MAP PAGE(S):** 06-118
**APPOVED BY:** AC **DATE:** 12/13/2021
**SCALE:** 1" = 20 **PRIOR INSTRUMENT:** 2017- 0653711