PARENT PARCEL: 16-00-085-000-024
CHILD PARCEL: 16-00-085-000-028 THRU -032
STARTING POINT: CL OF S.R. 83 & NEFF RD.

21-04424

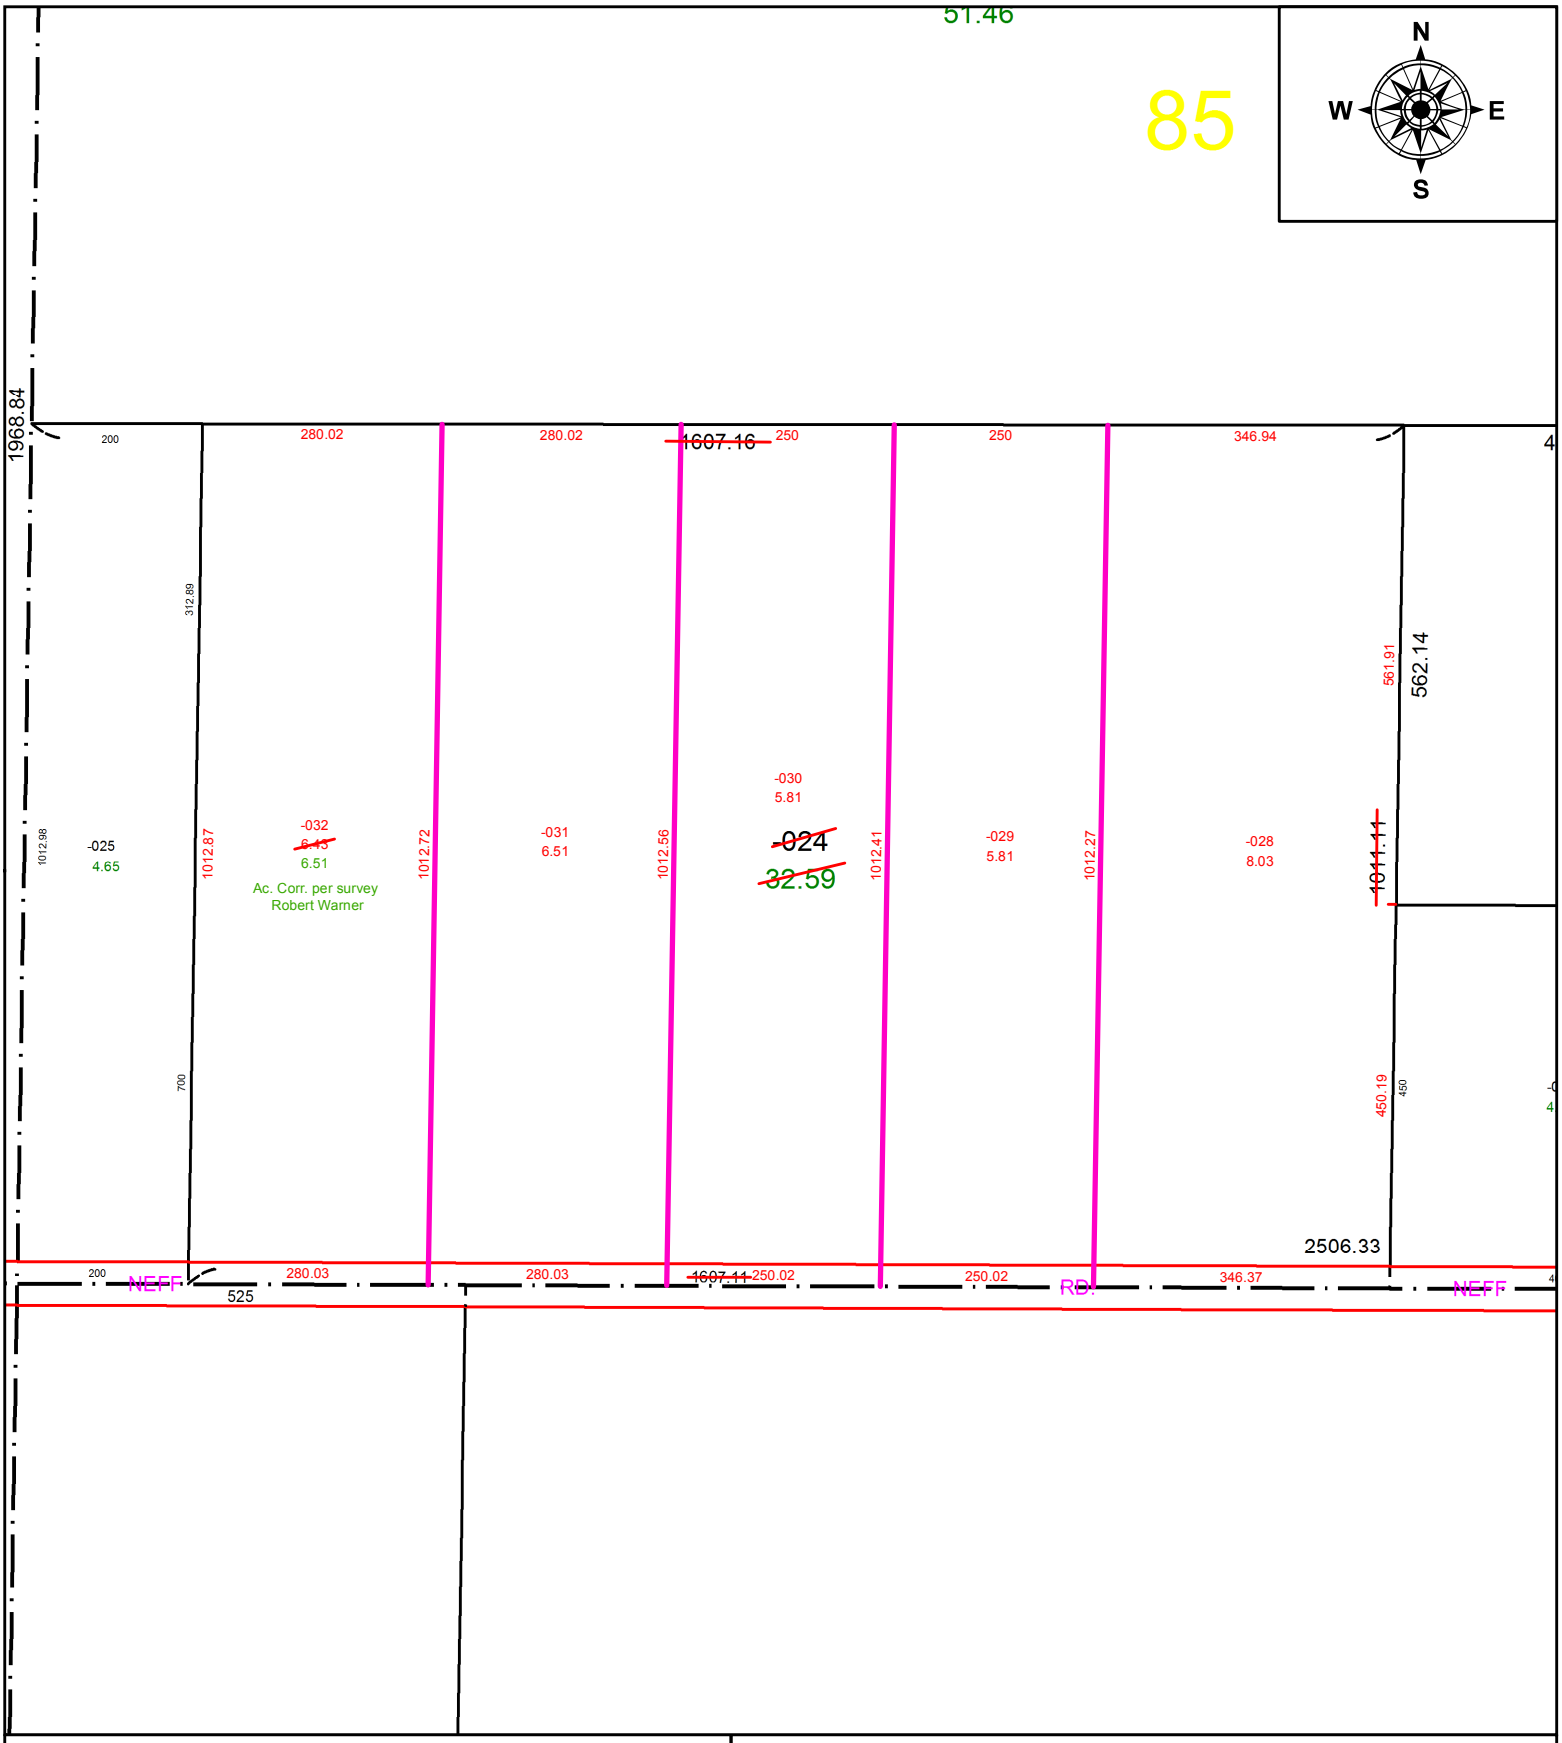

SPLITS/DEEDS PROCESSED

LORAIN COUNTY TAX MAP DEPARTMENT
226 MIDDLE AVE. ELYRIA, OH

SURVEYED BY: ROBERT WARNER
CLOSURE: 1: 421,541
MAP PAGE(S): 16-00-085
APPOVED BY: DMA **DATE:** 12/17/2021
SCALE: 1" = 225' **PRIOR INSTRUMENT:** 2019-0733377