PARENT PARCEL: ADD TO DUPLICATE

CHILD PARCEL: 05-00-016-630-001 GAS WELL API.# 34093600020000

STARTING POINT: X=2042505 Y=628370

20-04425-G

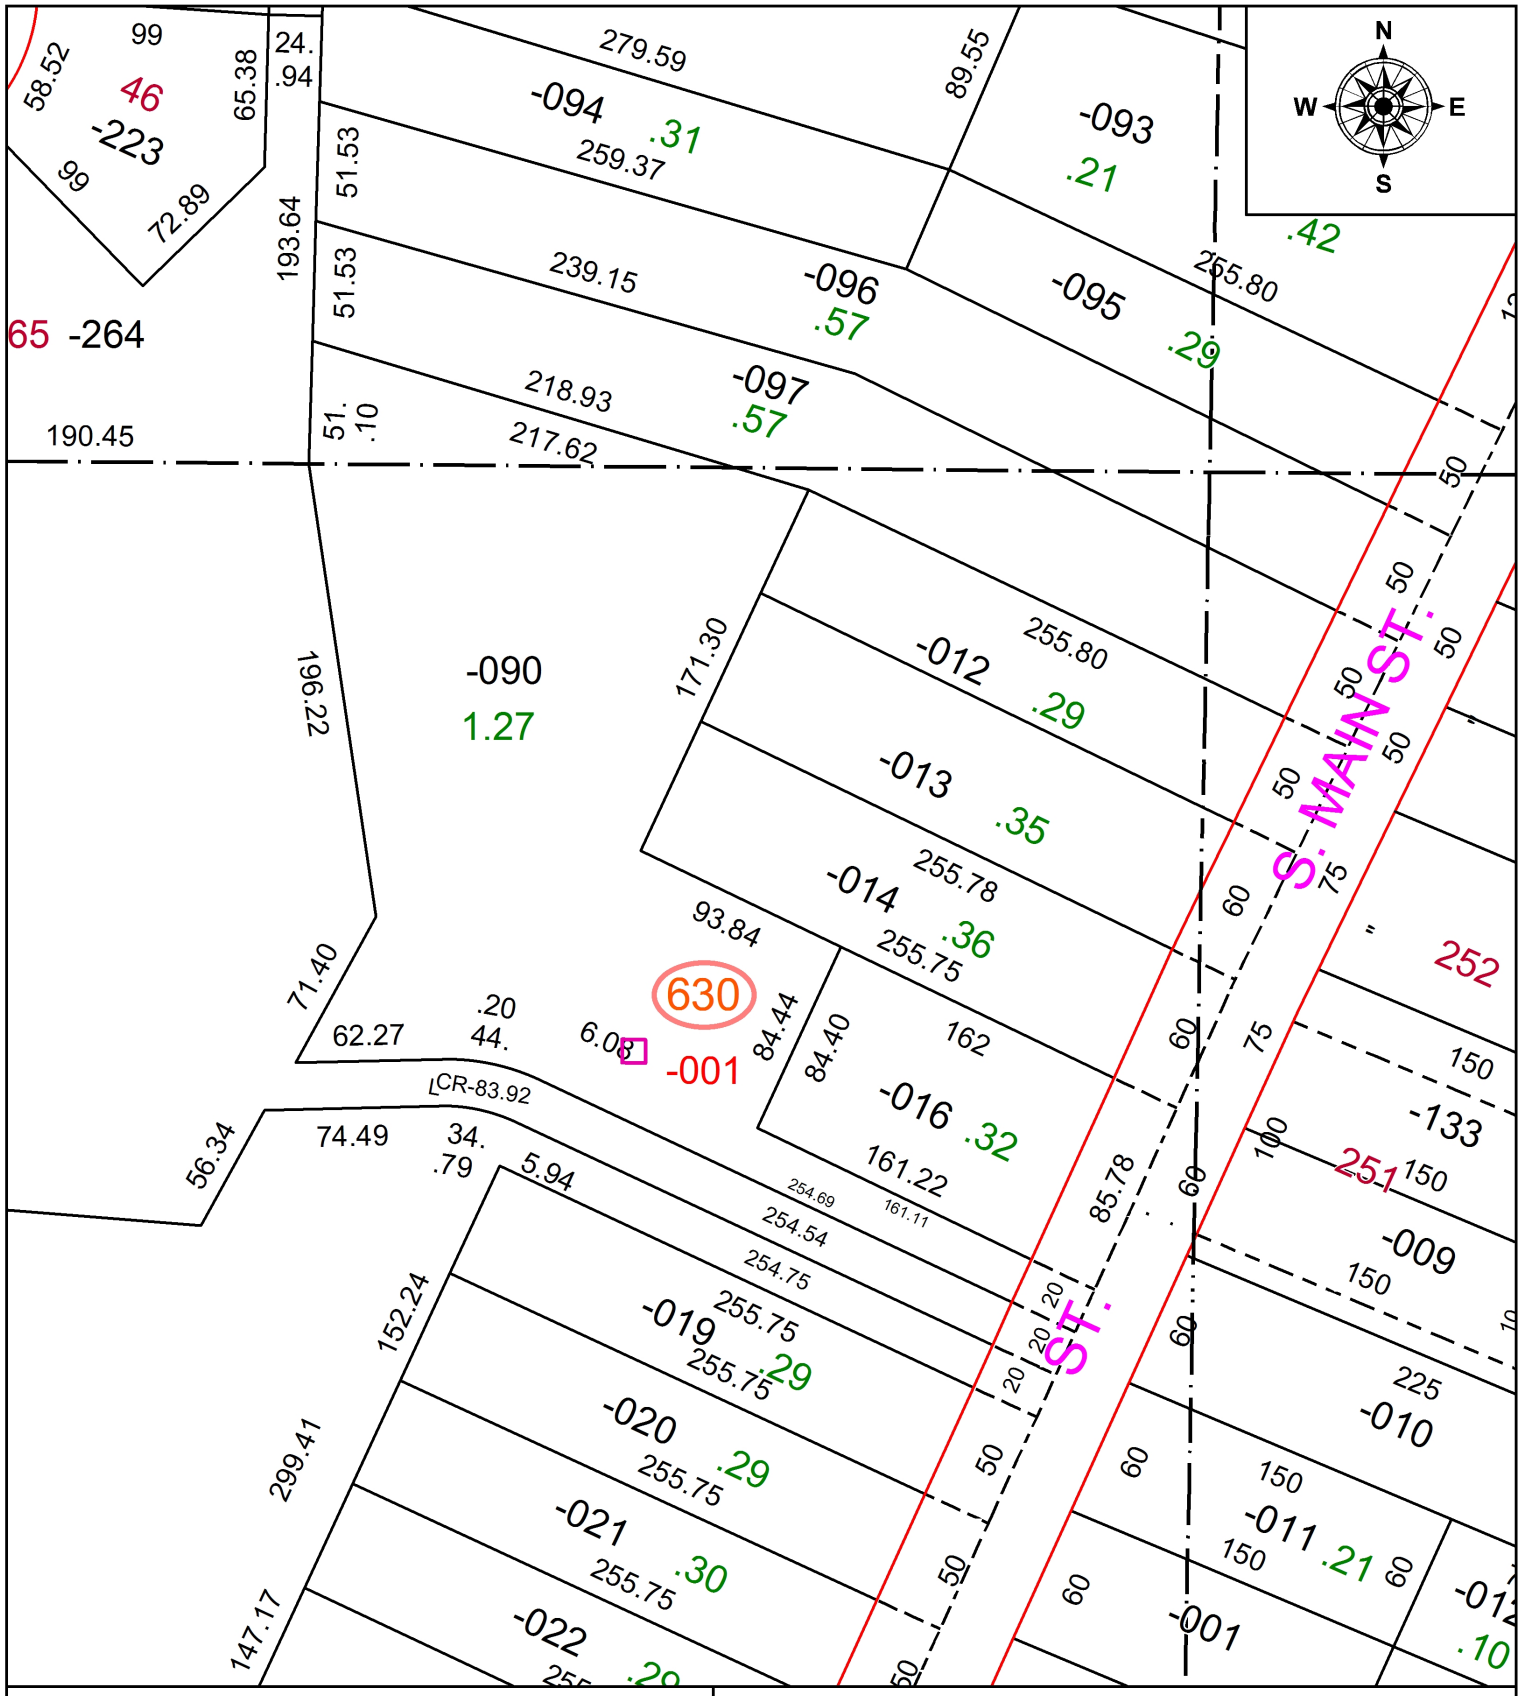

SPLITS/DEEDS PROCESSED

LORAIN COUNTY TAX MAP DEPARTMENT
226 MIDDLE AVE. ELYRIA, OH

SURVEYED BY: NA
CLOSURE: NA
MAP PAGE(S): 05-00-016
APPOVED BY: TJS **DATE:** 10/16/2020
SCALE: 1" = 80' **PRIOR INSTRUMENT:** DV XXXX/XXXX