PARENT PARCEL: 06-24-014-000-038

CHILD PARCEL: 06-24-014-000-086 THRU -088 ACREAGE CORRECTION PER SURVEYOR ROBERT J. WARNER

STARTING POINT: INTERSECTION OF SOUTH LINE OF LOWELL ST. & C/L OF MURRAY RIDGE RD.

22-04430

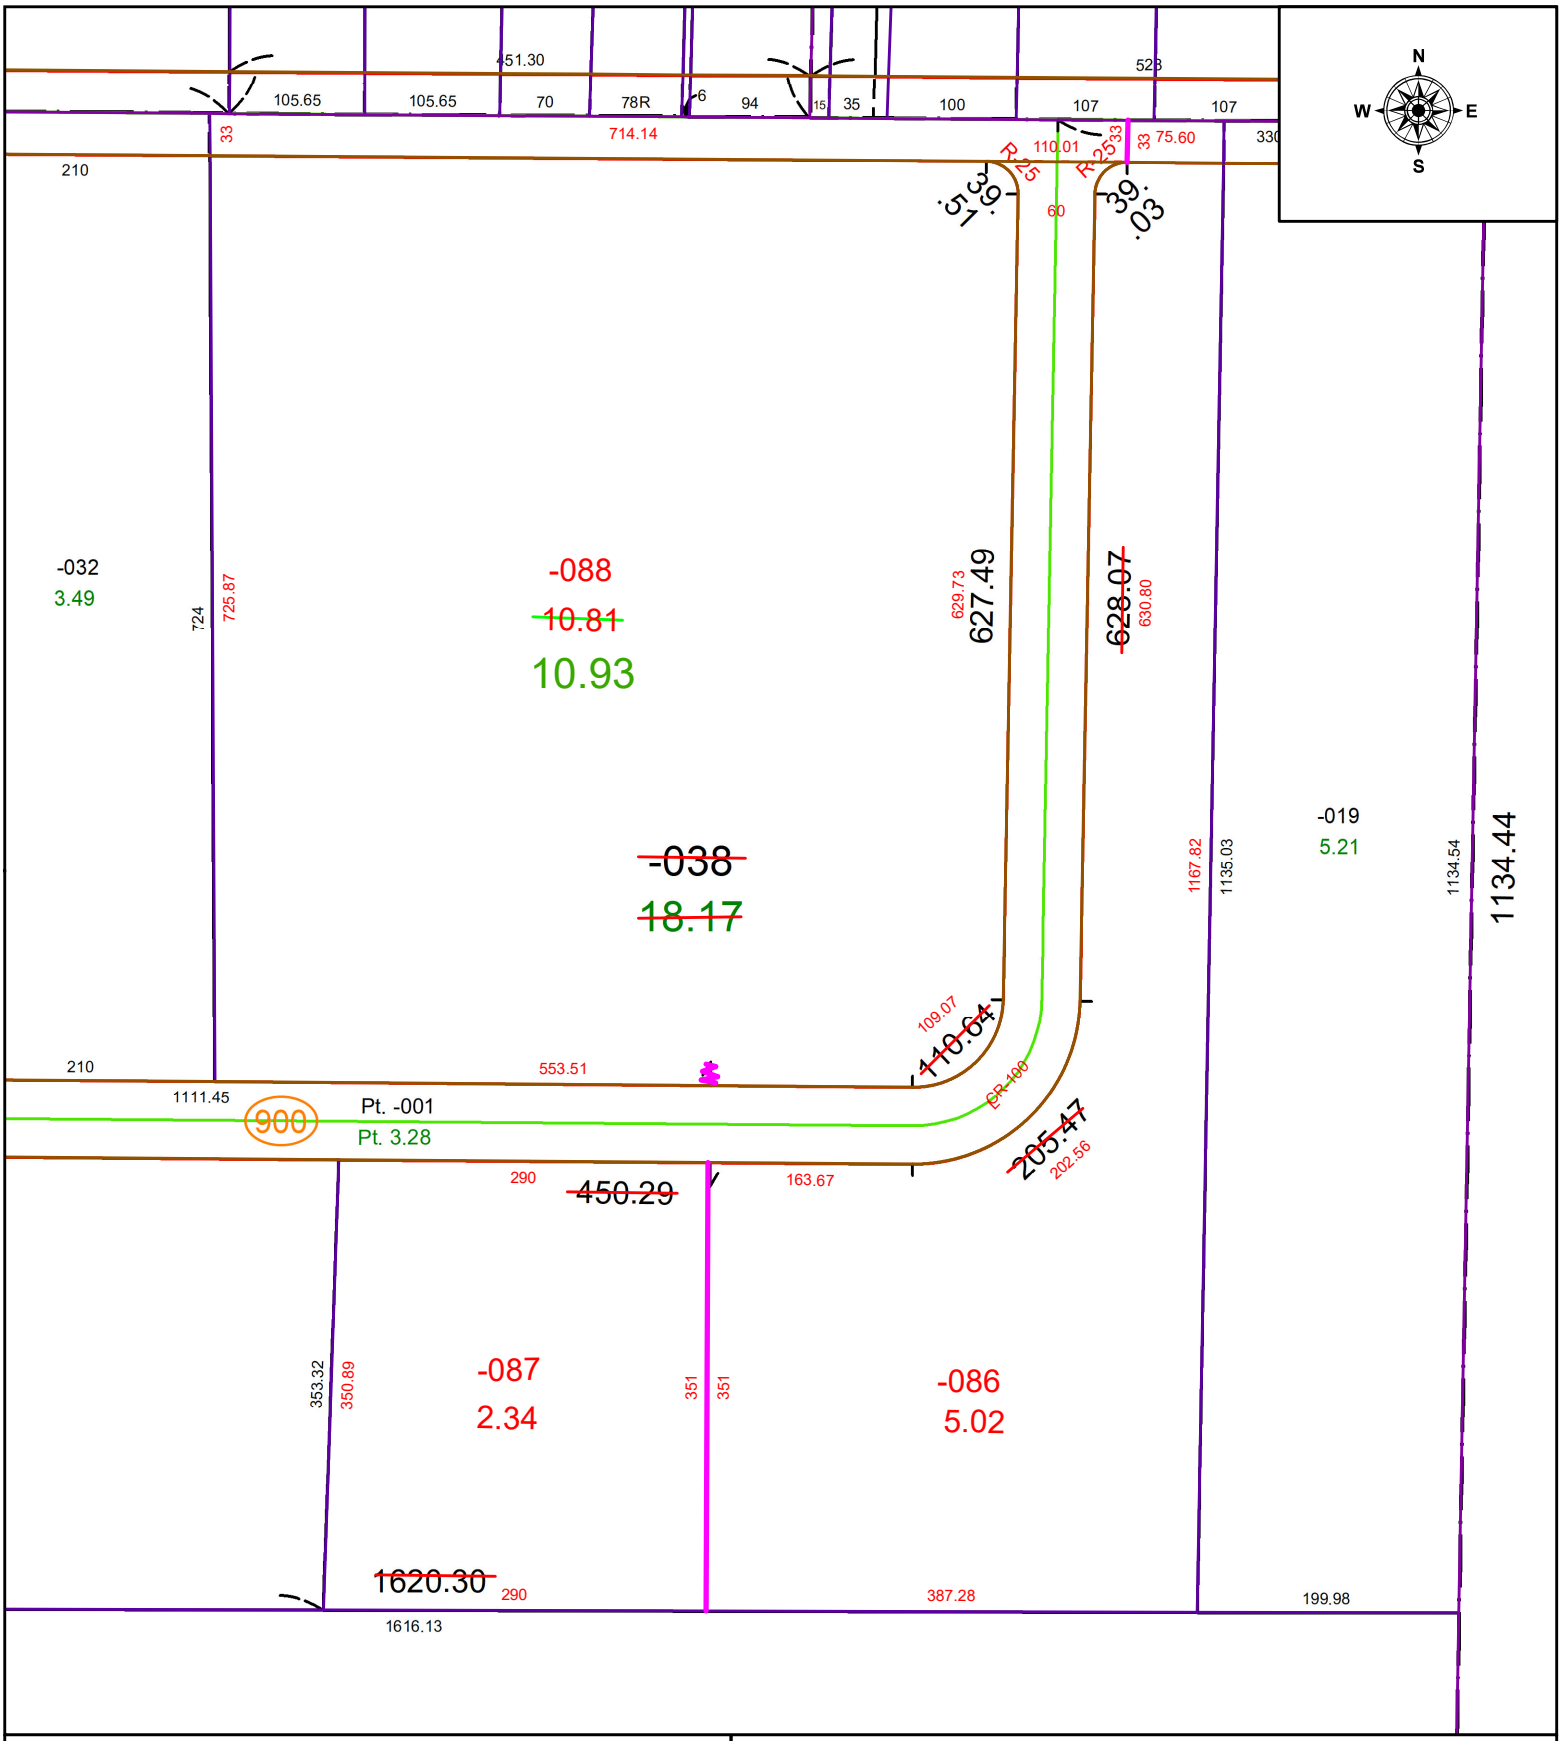

SPLITS/DEEDS PROCESSED

LORAIN COUNTY TAX MAP DEPARTMENT
226 MIDDLE AVE. ELYRIA, OH

SURVEYED BY: ROBERT J. WAGNER
CLOSURE: 1: 848440
MAP PAGE(S): 06-24-014
APPOVED BY: WRZ **DATE:** 1/12/2022
SCALE: 1" = 150 **PRIOR INSTRUMENT:** DV 1235 PG. 867