PARENT PARCEL: 07-00-006-101-040

CHILD PARCEL: 07-00-006-101-162 & -163

STARTING POINT: 3/8" I.P. FD. MON. BOX, CL OF MILLS CREEK LN. & CL OF CEDAR BRANCH DR.

22-04435

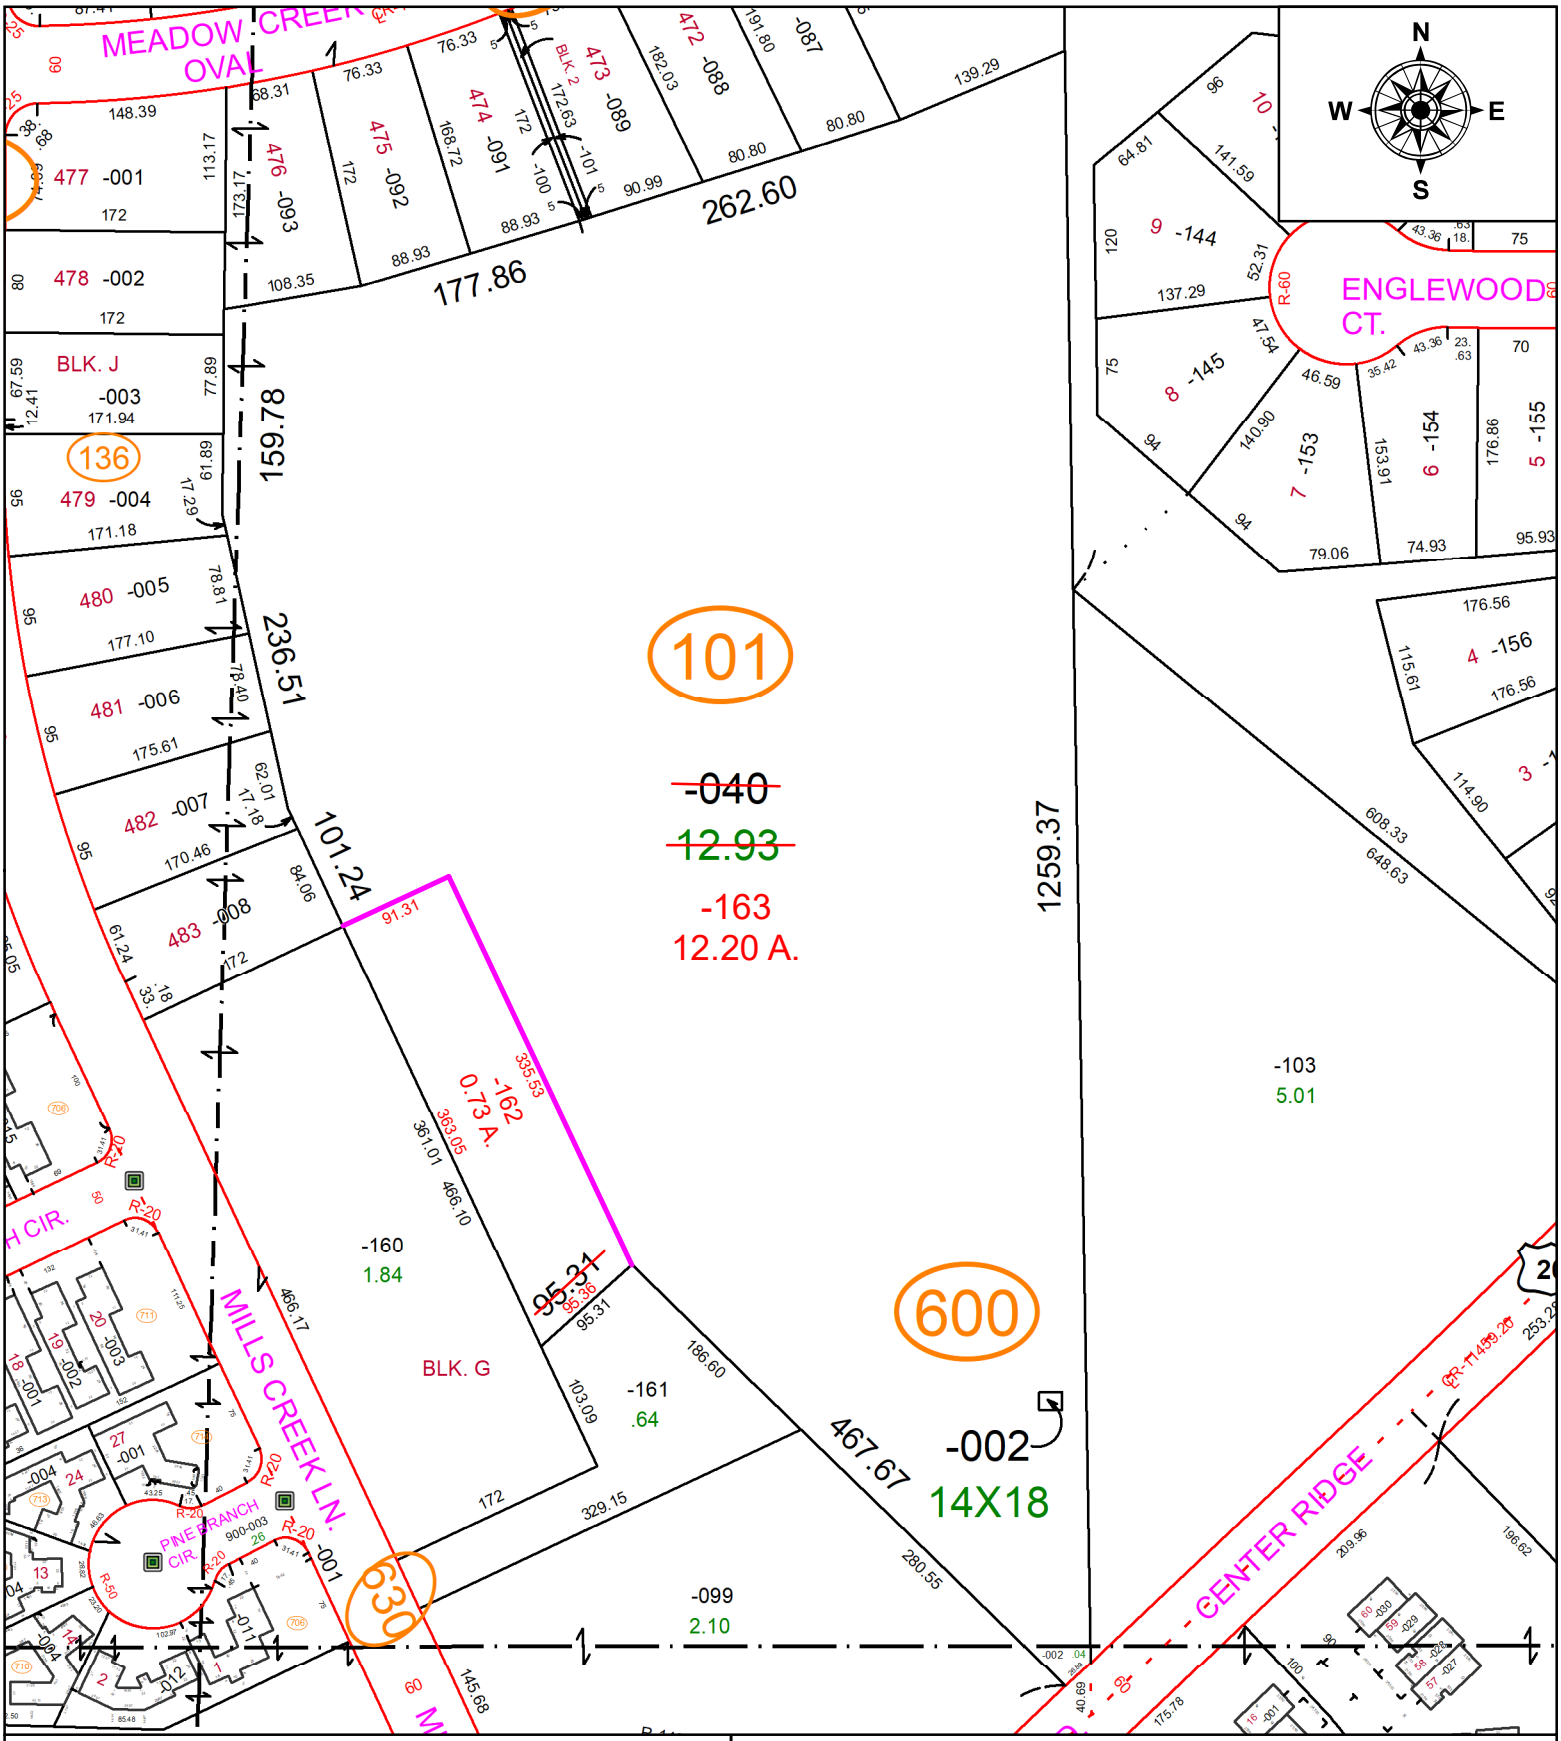

SPLITS/DEEDS PROCESSED

LORAIN COUNTY TAX MAP DEPARTMENT
226 MIDDLE AVE. ELYRIA, OH

SURVEYED BY: MICHAEL BRAMHALL
CLOSURE: 1: 33,000
MAP PAGE(S): 07-00-006
APPOVED BY: TJS **DATE:** 1/25/2022
SCALE: 1" = 150' **PRIOR INSTRUMENT:** 2021-0816675