PARENT PARCEL: 05-00-041-110-031 & -042

CHILD PARCEL: 05-00-041-110-061 thru -064

STARTING POINT: CL OF COOPER FOSTER PARK RD & N.E. CORNER OF O.L 41

22-04436

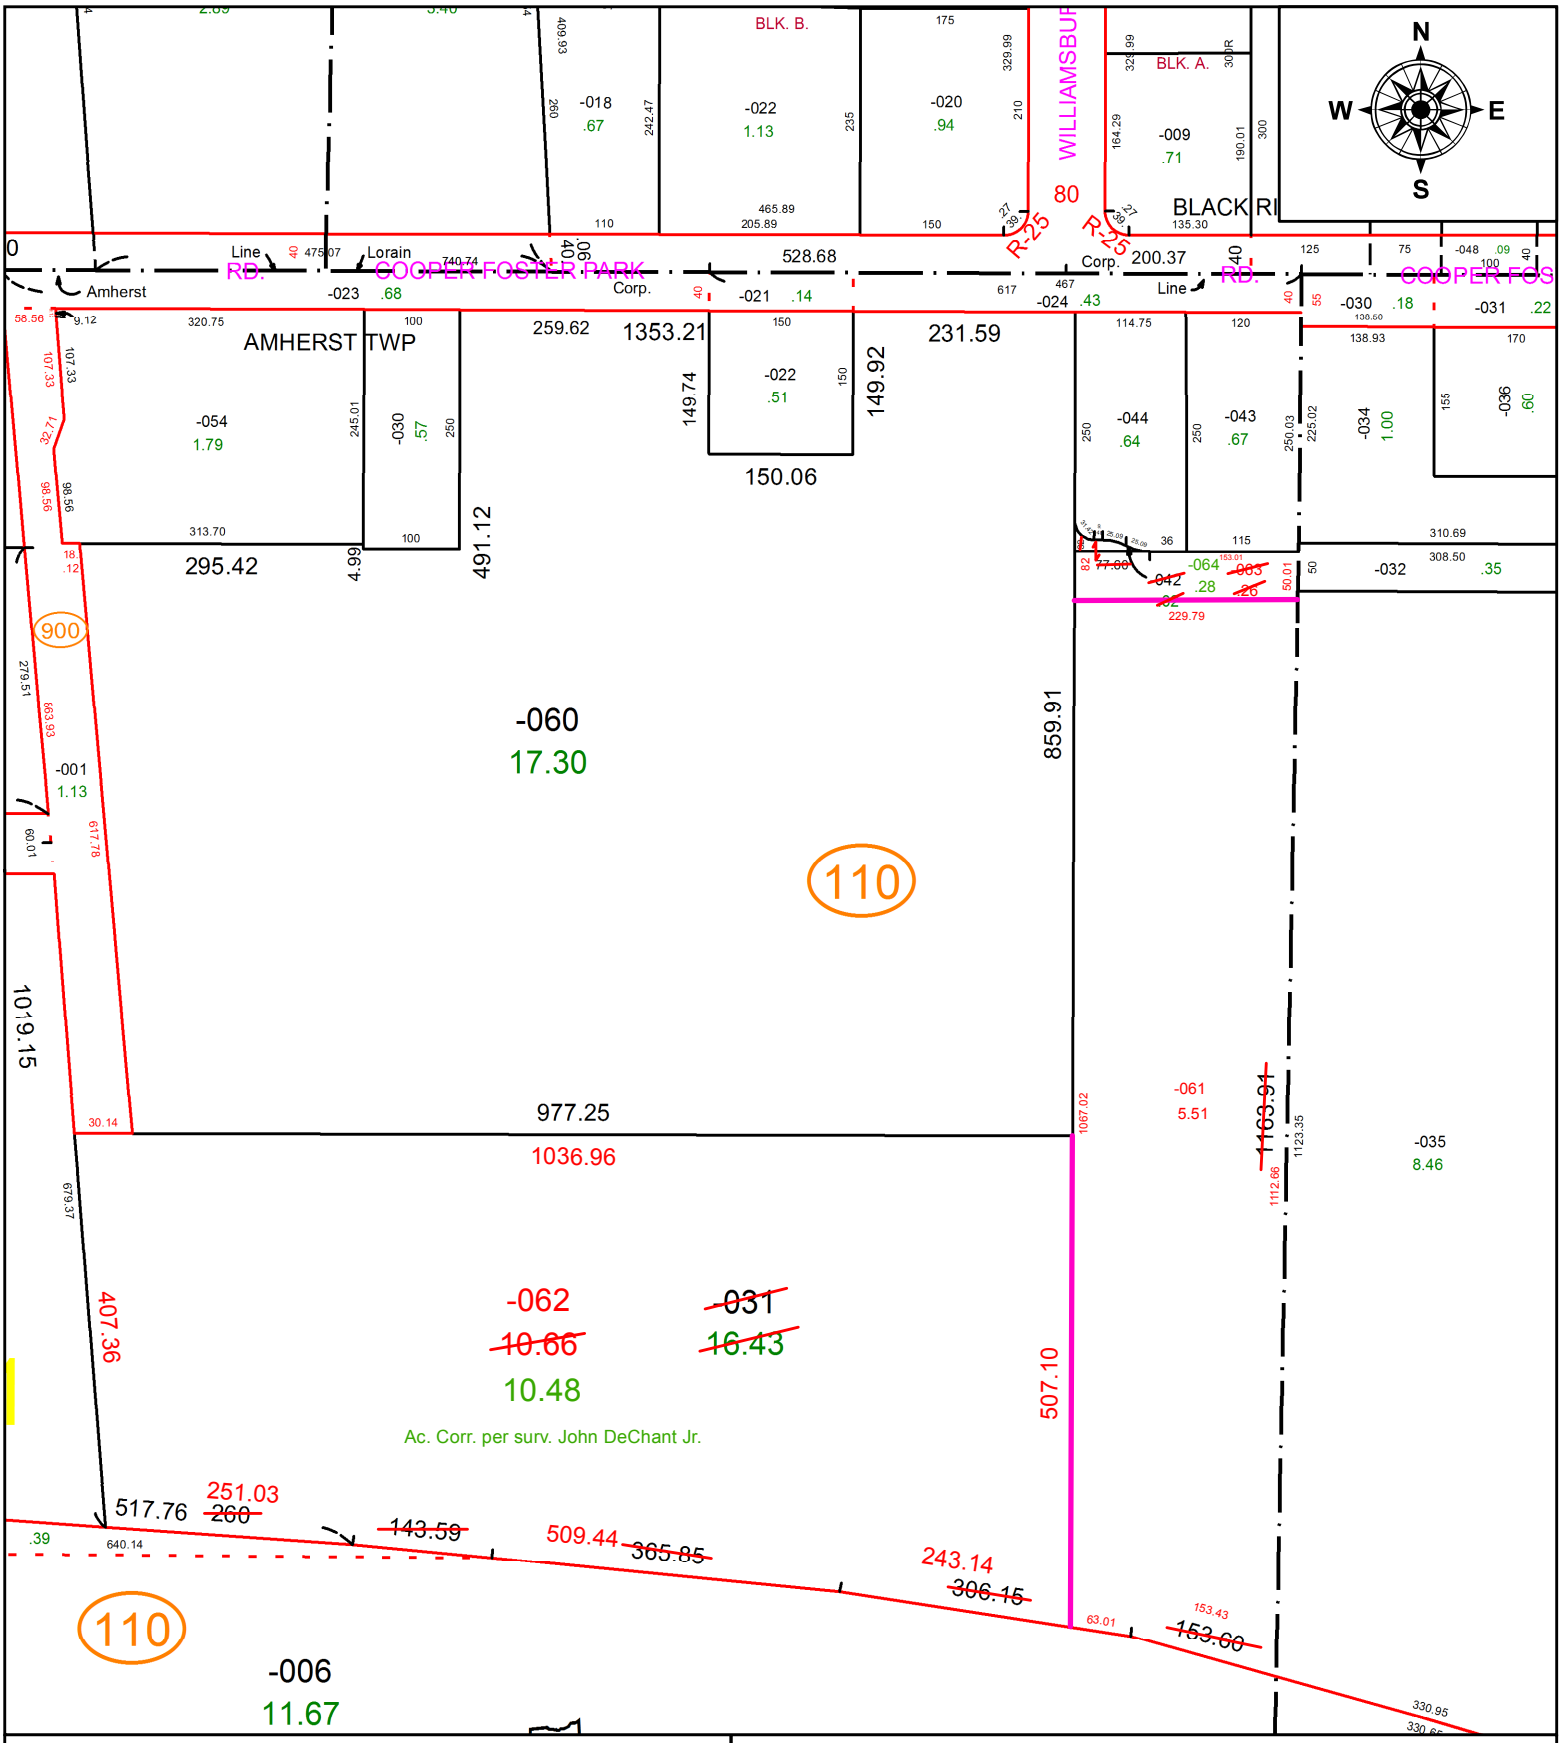

SPLITS/DEEDS PROCESSED

LORAIN COUNTY TAX MAP DEPARTMENT
226 MIDDLE AVE. ELYRIA, OH

SURVEYED BY: JOHN A DeCHANT JR.

CLOSURE: 1: 450419

MAP PAGE(S): 05-00-041

APPOVED BY: DMA **DATE:** 1/25/2022

SCALE: 1" = 200' **PRIOR INSTRUMENT:** D.V. 1164 PG. 339