PARENT PARCEL: 04-00-019-144-327 & -361

CHILD PARCEL: 04-00-019-144-383 THRU -385

STARTING POINT: SOUTHEST CORNER OF S/L 51 IN WOODFIELD ESTATES SUB. NO. 3

22-04437

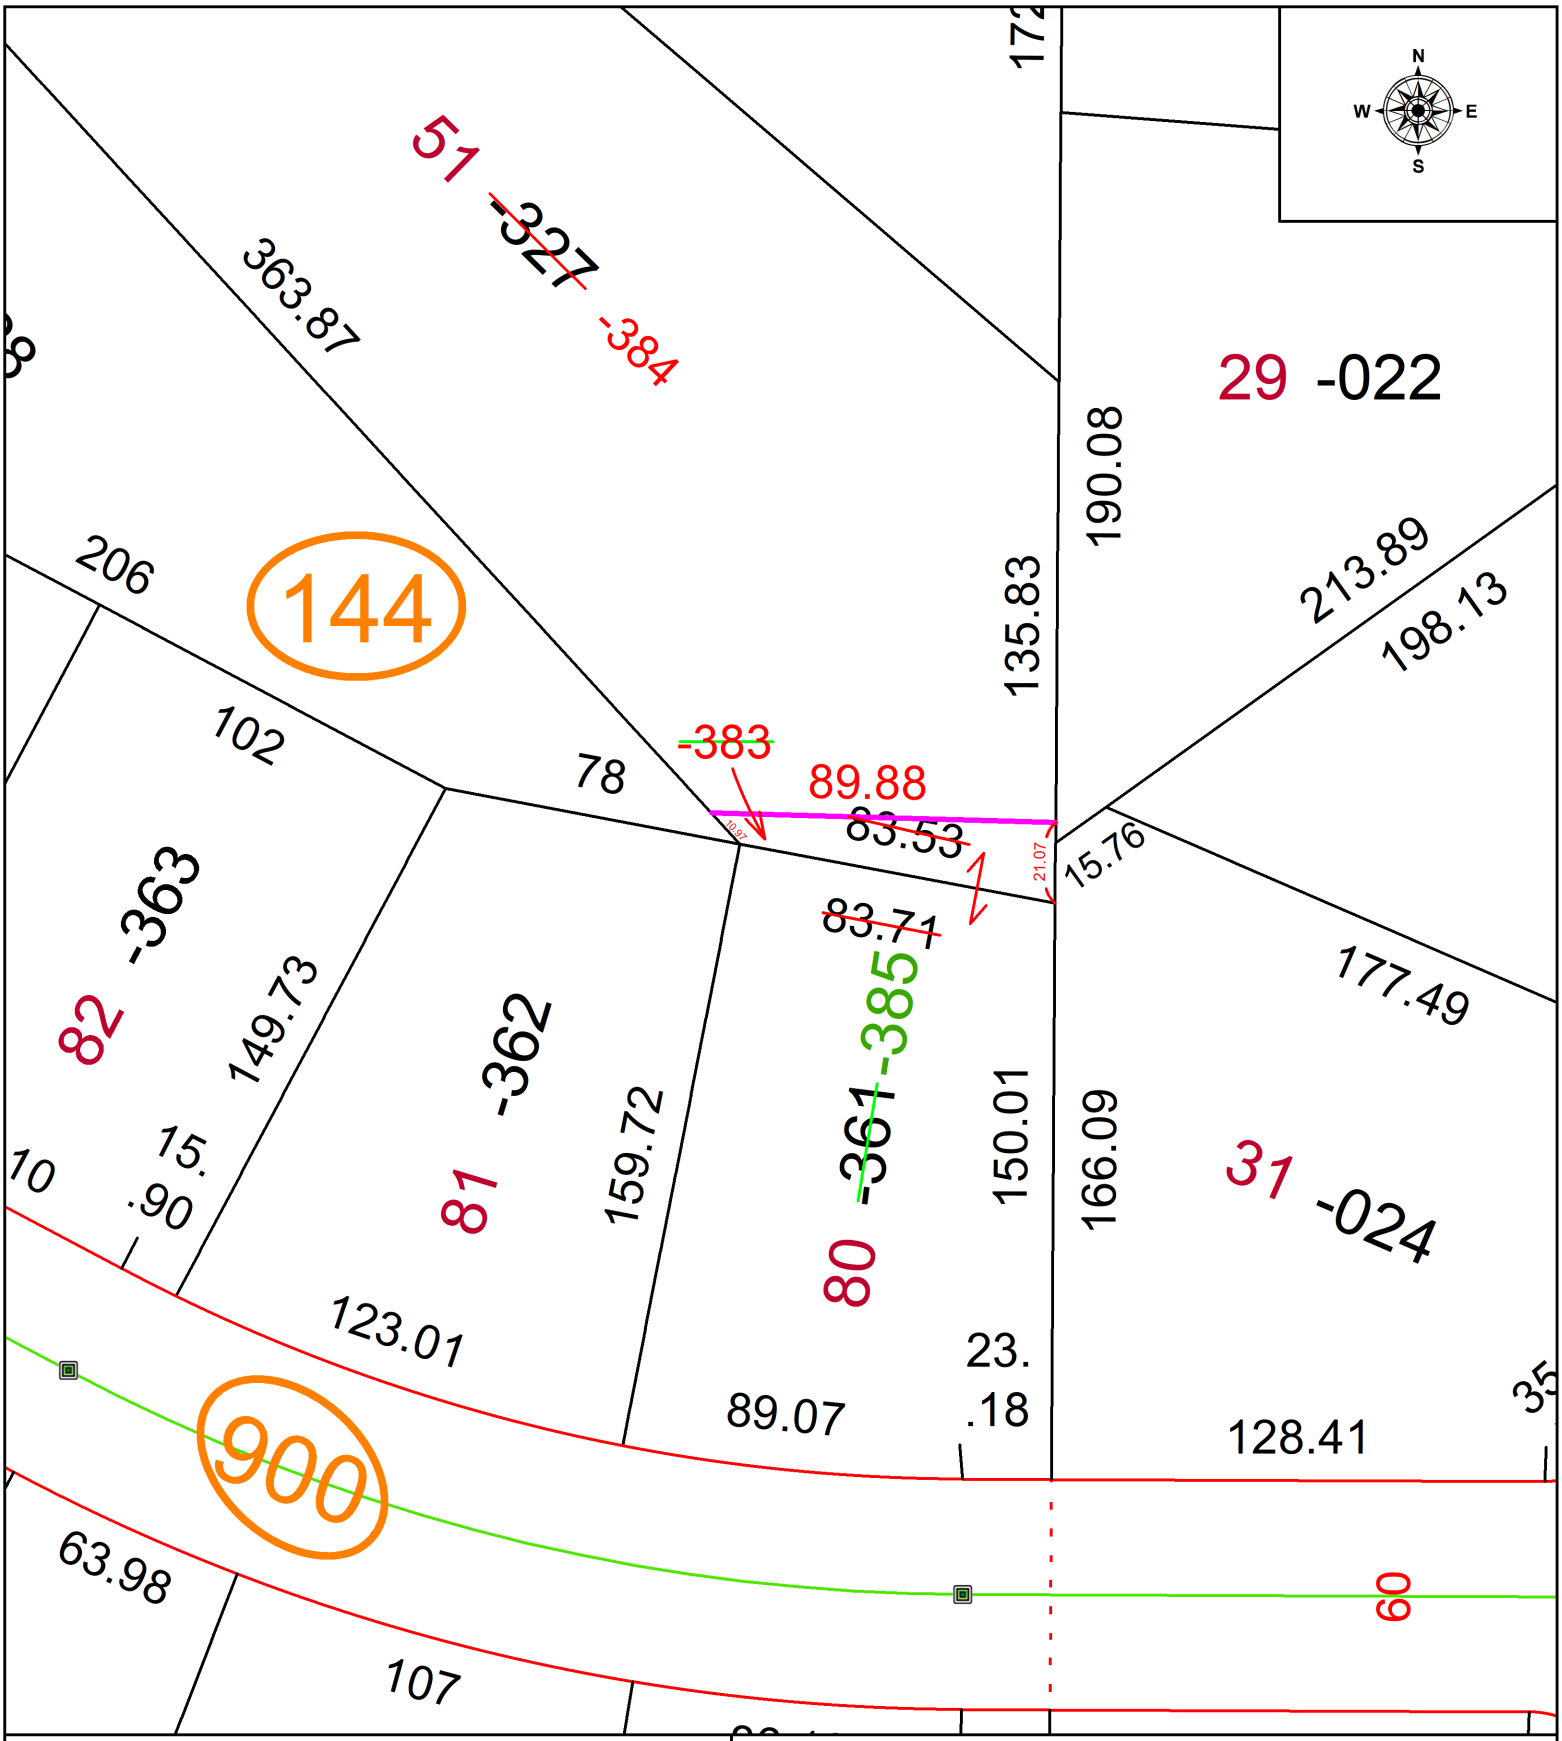

SPLITS/DEEDS PROCESSED

LORAIN COUNTY TAX MAP DEPARTMENT
226 MIDDLE AVE. ELYRIA, OH

SURVEYED BY: DINO A.F. LUSTRI
CLOSURE: 1:27893
MAP PAGE(S): 04-00-019
APPOVED BY: WRZ **DATE:** 1/31/2022
SCALE: 1" = 50 **PRIOR INSTRUMENT:** 2013-0474527