PARENT PARCEL: 19-03-013-000-004, -013
CHILD PARCEL: 19-03-013-000-033
STARTING POINT: SOUTHWESTERLY CORNER OF LAND CONVEYED TO LYLE O. & FLORENCE M. BEHNER (DV 929/425)

20-04441-C

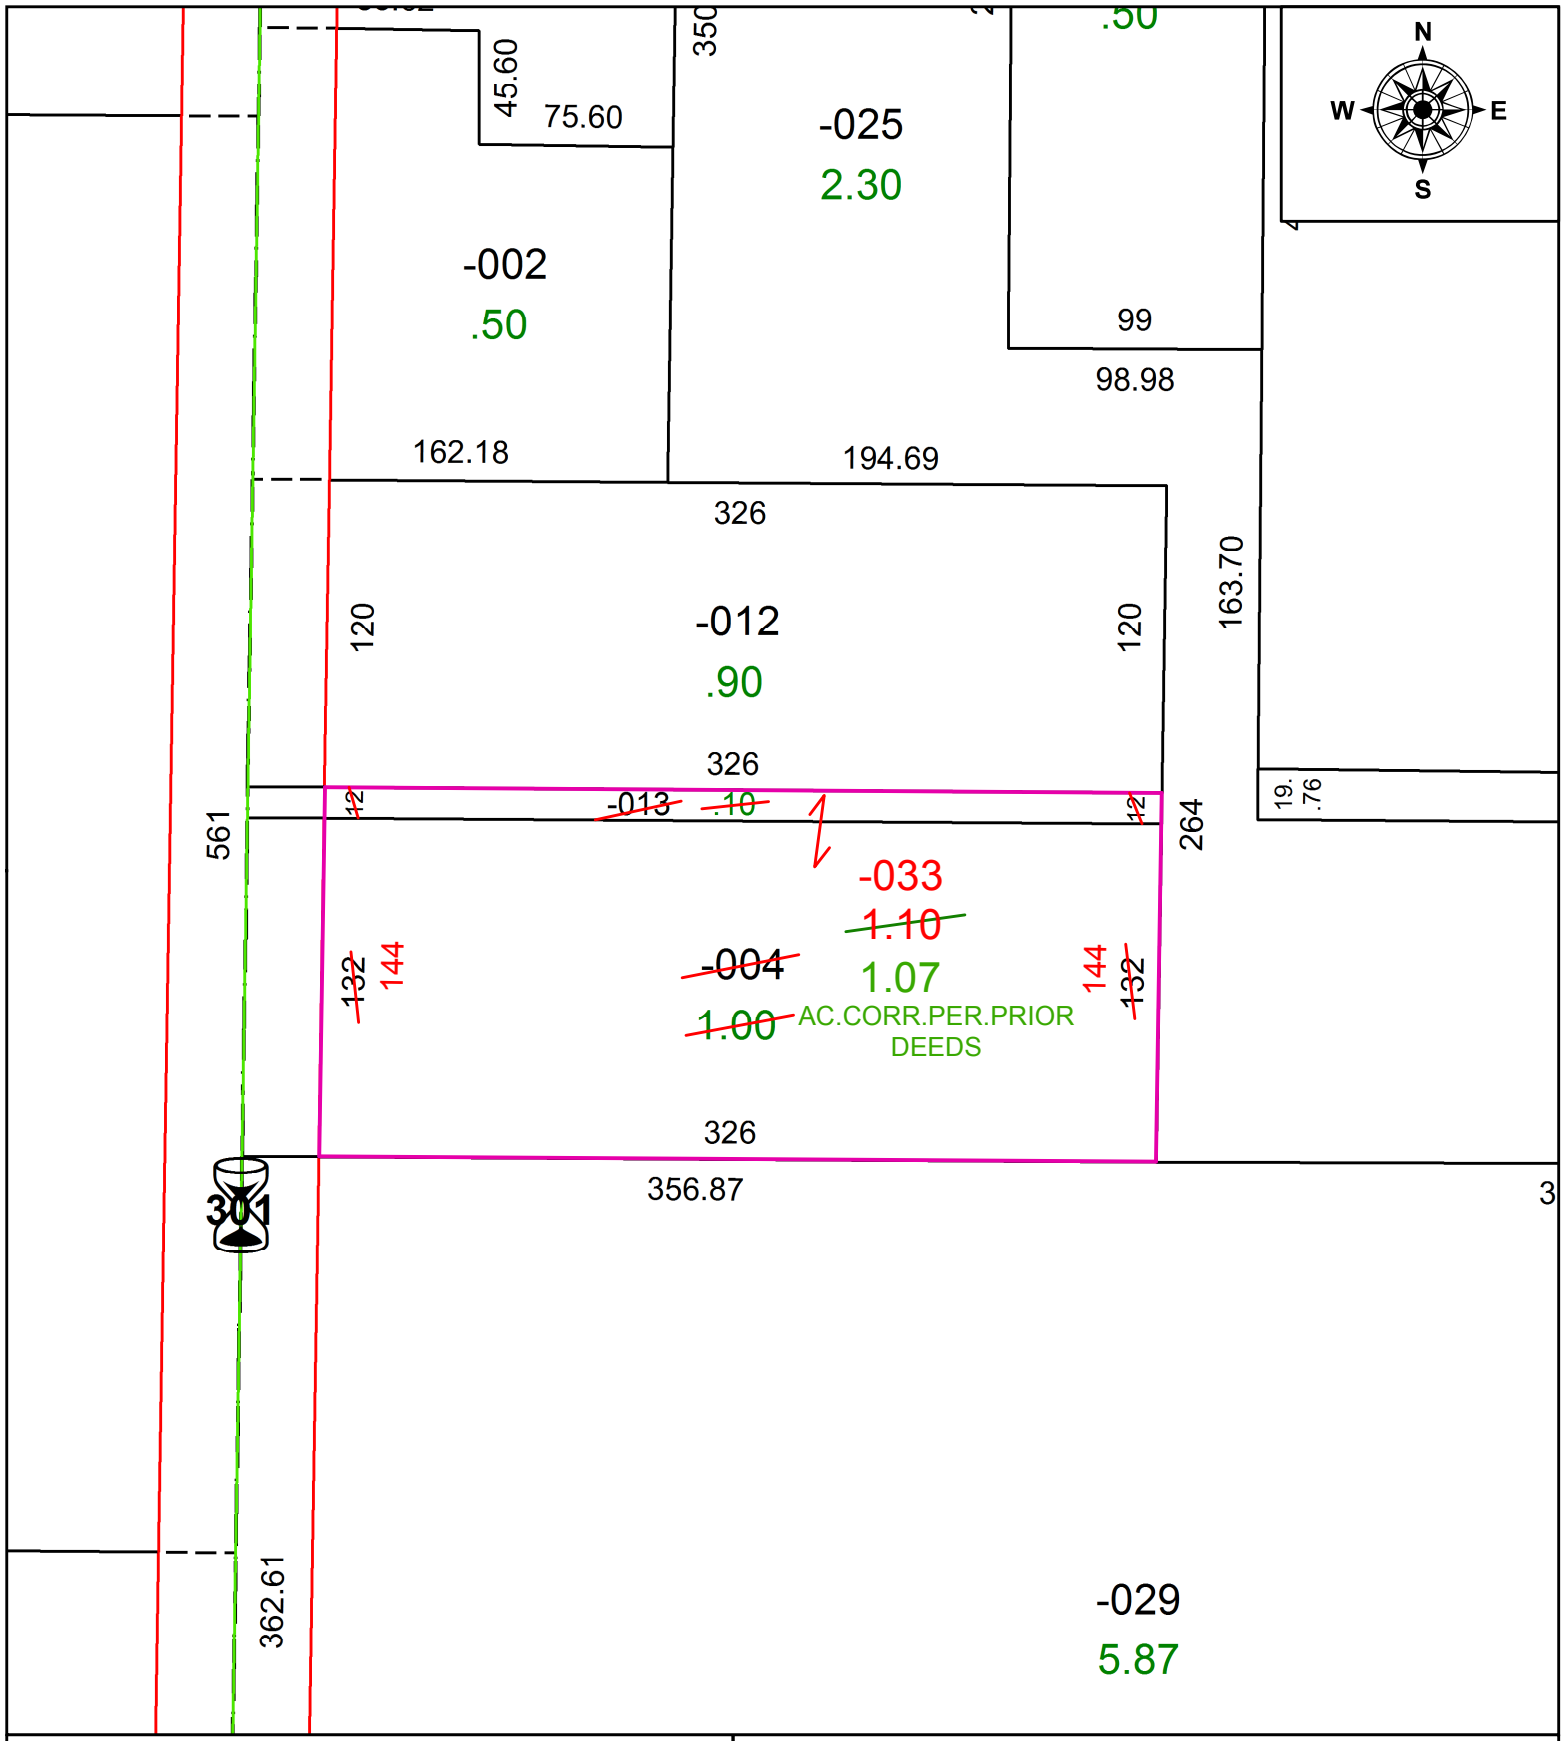

SPLITS/DEEDS PROCESSED
LORAIN COUNTY TAX MAP DEPARTMENT
226 MIDDLE AVE. ELYRIA, OH

SURVEYED BY: N/A
CLOSURE: N/A
MAP PAGE(S): 19-03-013
APPOVED BY: RRM **DATE:** 11-23-20
SCALE: 1" = 75 **PRIOR INSTRUMENT:** OR 473/506