PARENT PARCEL: 10-00-007-103-018

CHILD PARCEL: 10-00-007-103-019 & -020

STARTING POINT: CL OF MARDUN RD. & INDIAN HOLLOW RD.

22-04444

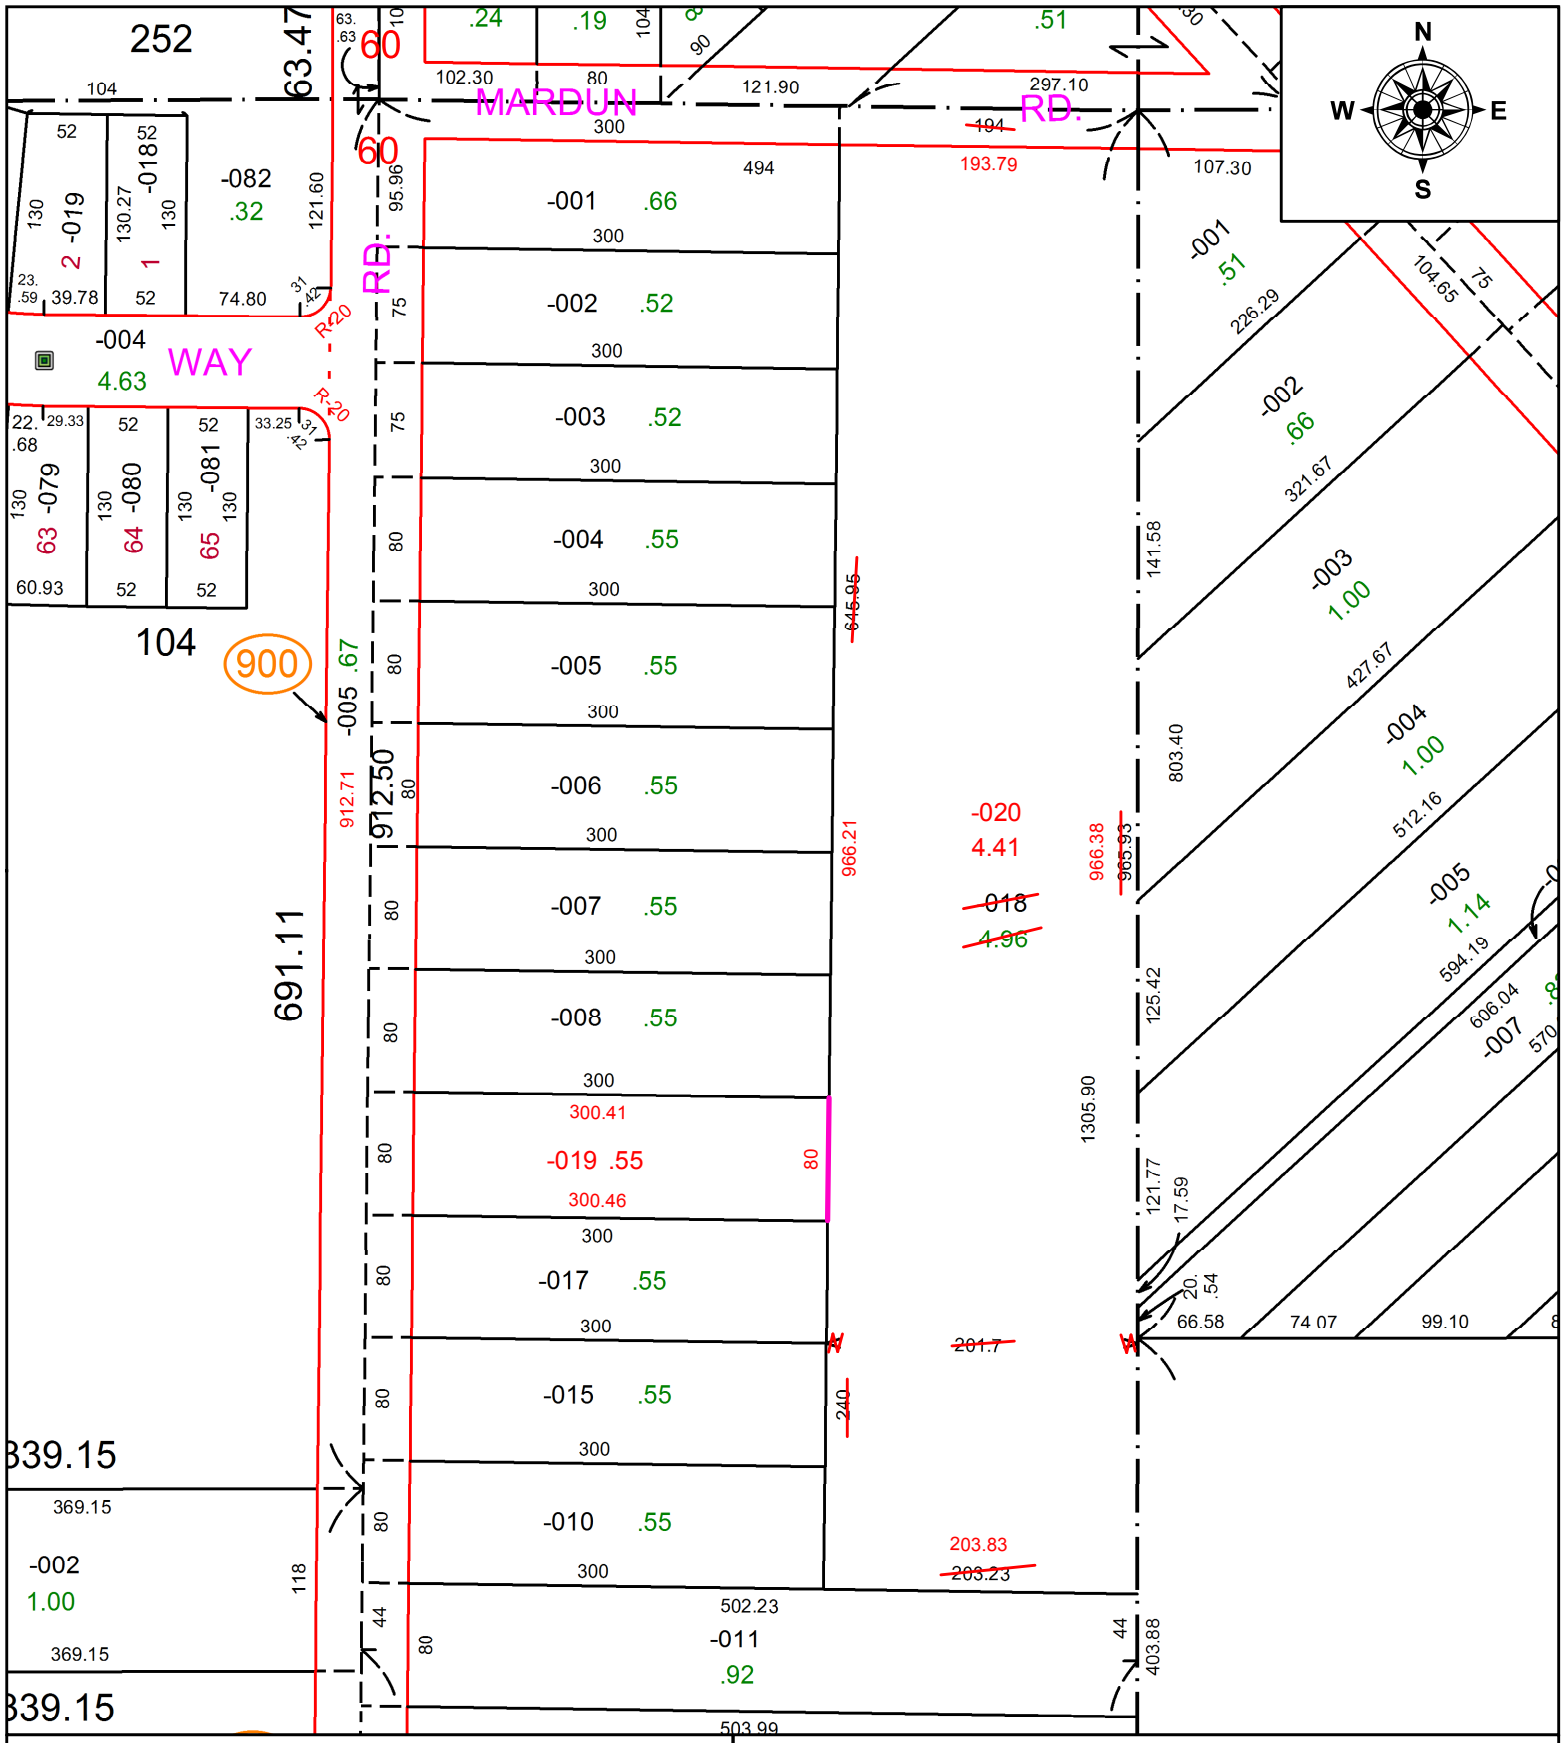

SPLITS/DEEDS PROCESSED

LORAIN COUNTY TAX MAP DEPARTMENT
226 MIDDLE AVE. ELYRIA, OH

SURVEYED BY: THOMAS SIMON

CLOSURE: 1: 936,675

MAP PAGE(S): 10-00-007

APPOVED BY: DMA **DATE:** 2/17/2022

SCALE: 1" = 125' **PRIOR INSTRUMENT:** 2003-0949804