PARENT PARCEL: 07-00-048-000-007

CHILD PARCEL:

STARTING POINT: INTERSECTION OF C/L OF CHESTNUT RIDGE RD. AND EAST LINE OF CITY OF ELYRIA

20-04446-A

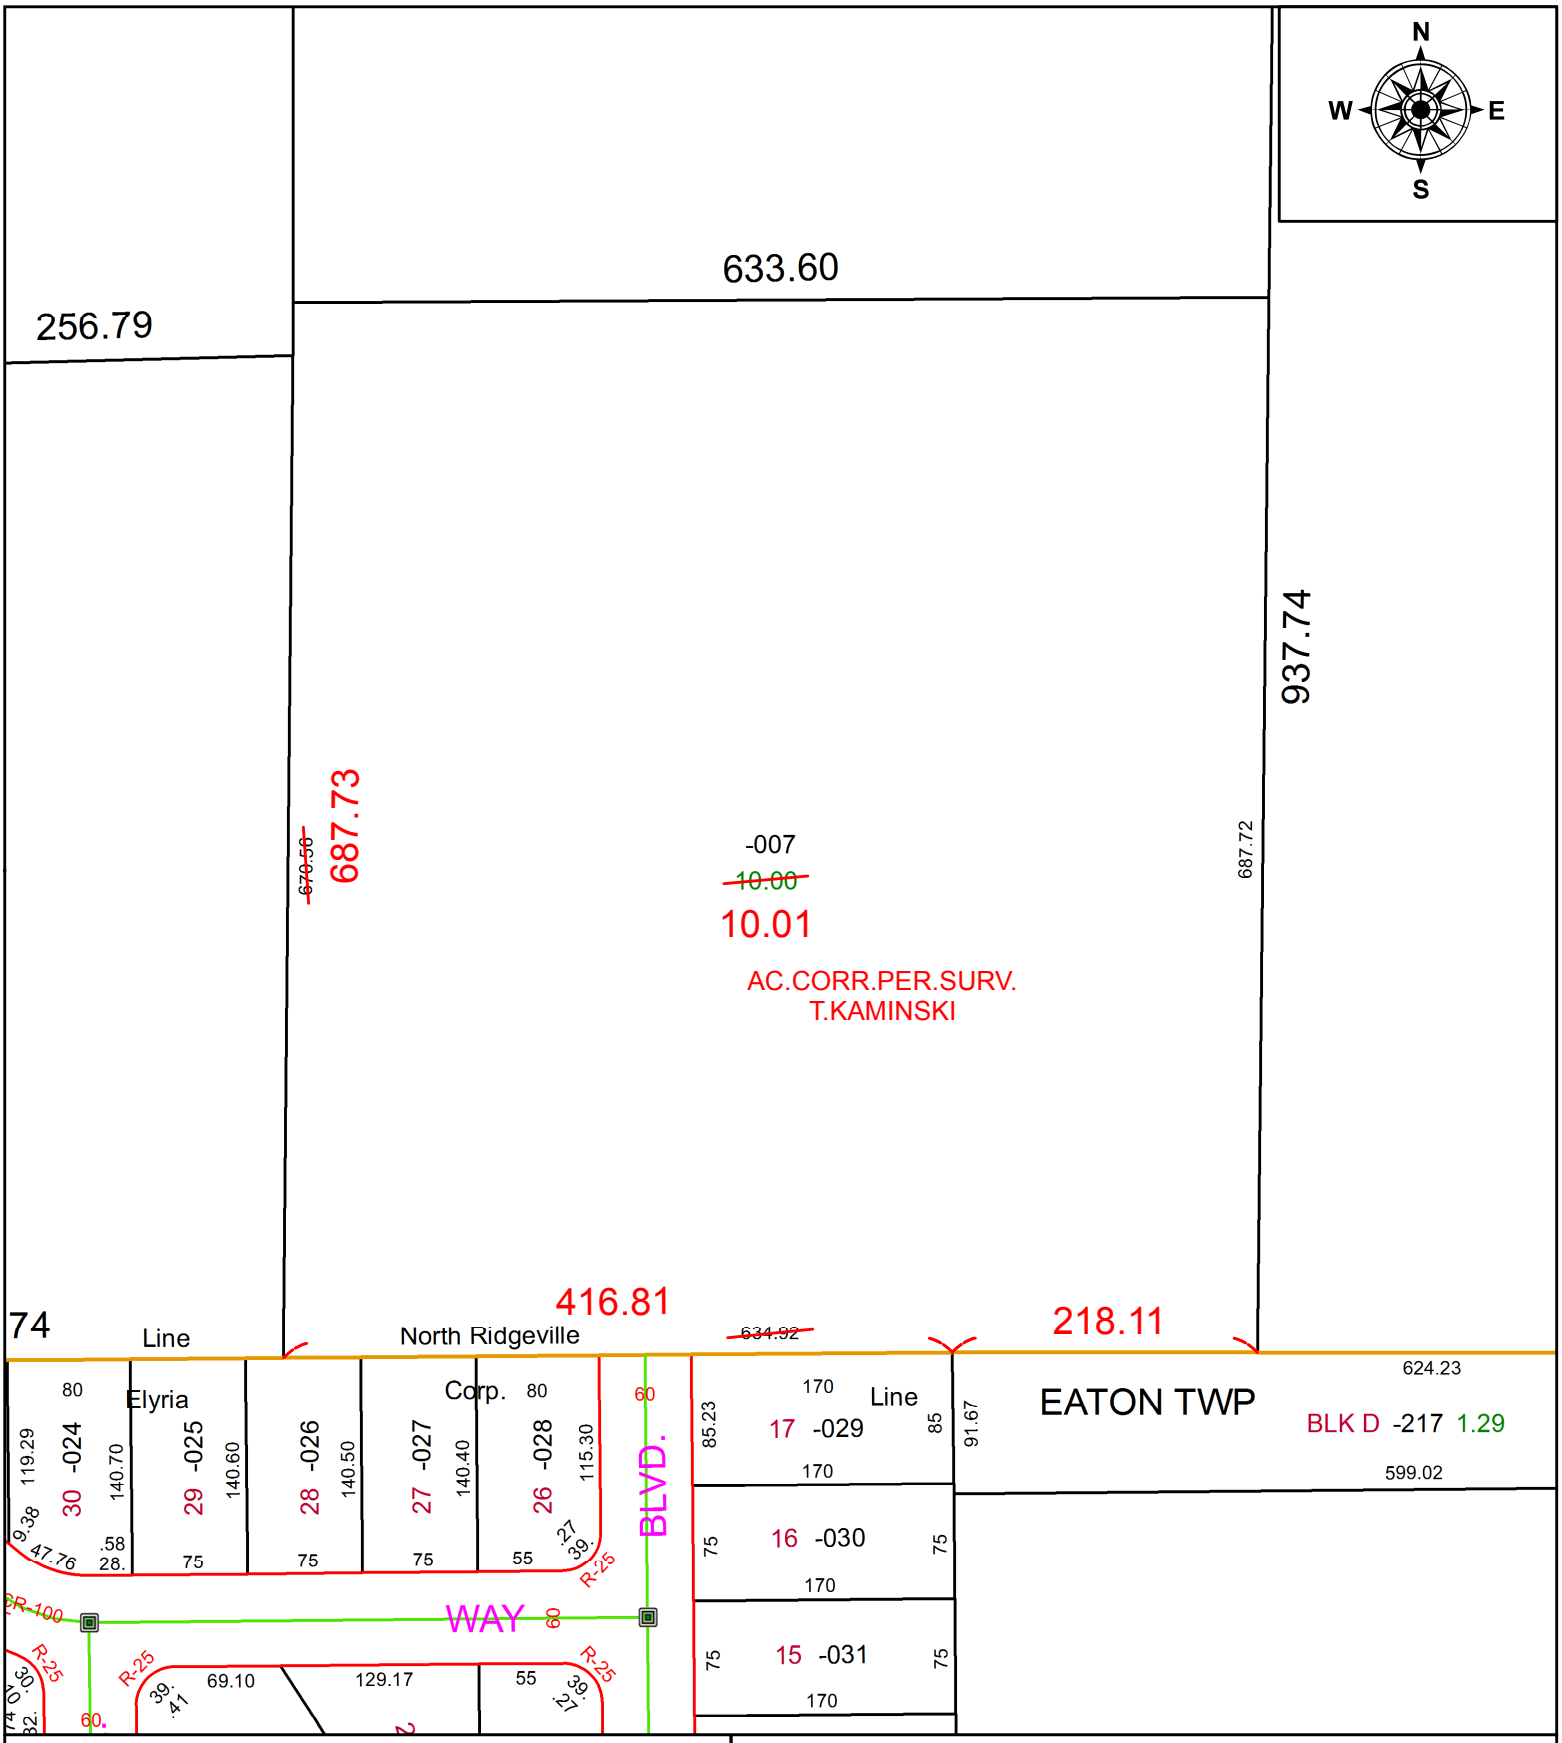

SPLITS/DEEDS PROCESSED

LORAIN COUNTY TAX MAP DEPARTMENT
226 MIDDLE AVE. ELYRIA, OH

SURVEYED BY: TERIN J. KAMINSKI
CLOSURE: 1:892,522
MAP PAGE(S): 7-00-048
APPOVED BY: RRM **DATE:** 12-3-20
SCALE: 1" = 125 **PRIOR INSTRUMENT:** 20150536395