**PARENT PARCEL:** 17-08-031-000-018

**CHILD PARCEL:**

**STARTING POINT:** INTERSECTION OF C/L OF PECK WADSWORTH RD. AND C/L OF S.R.511

# 20-04450-A

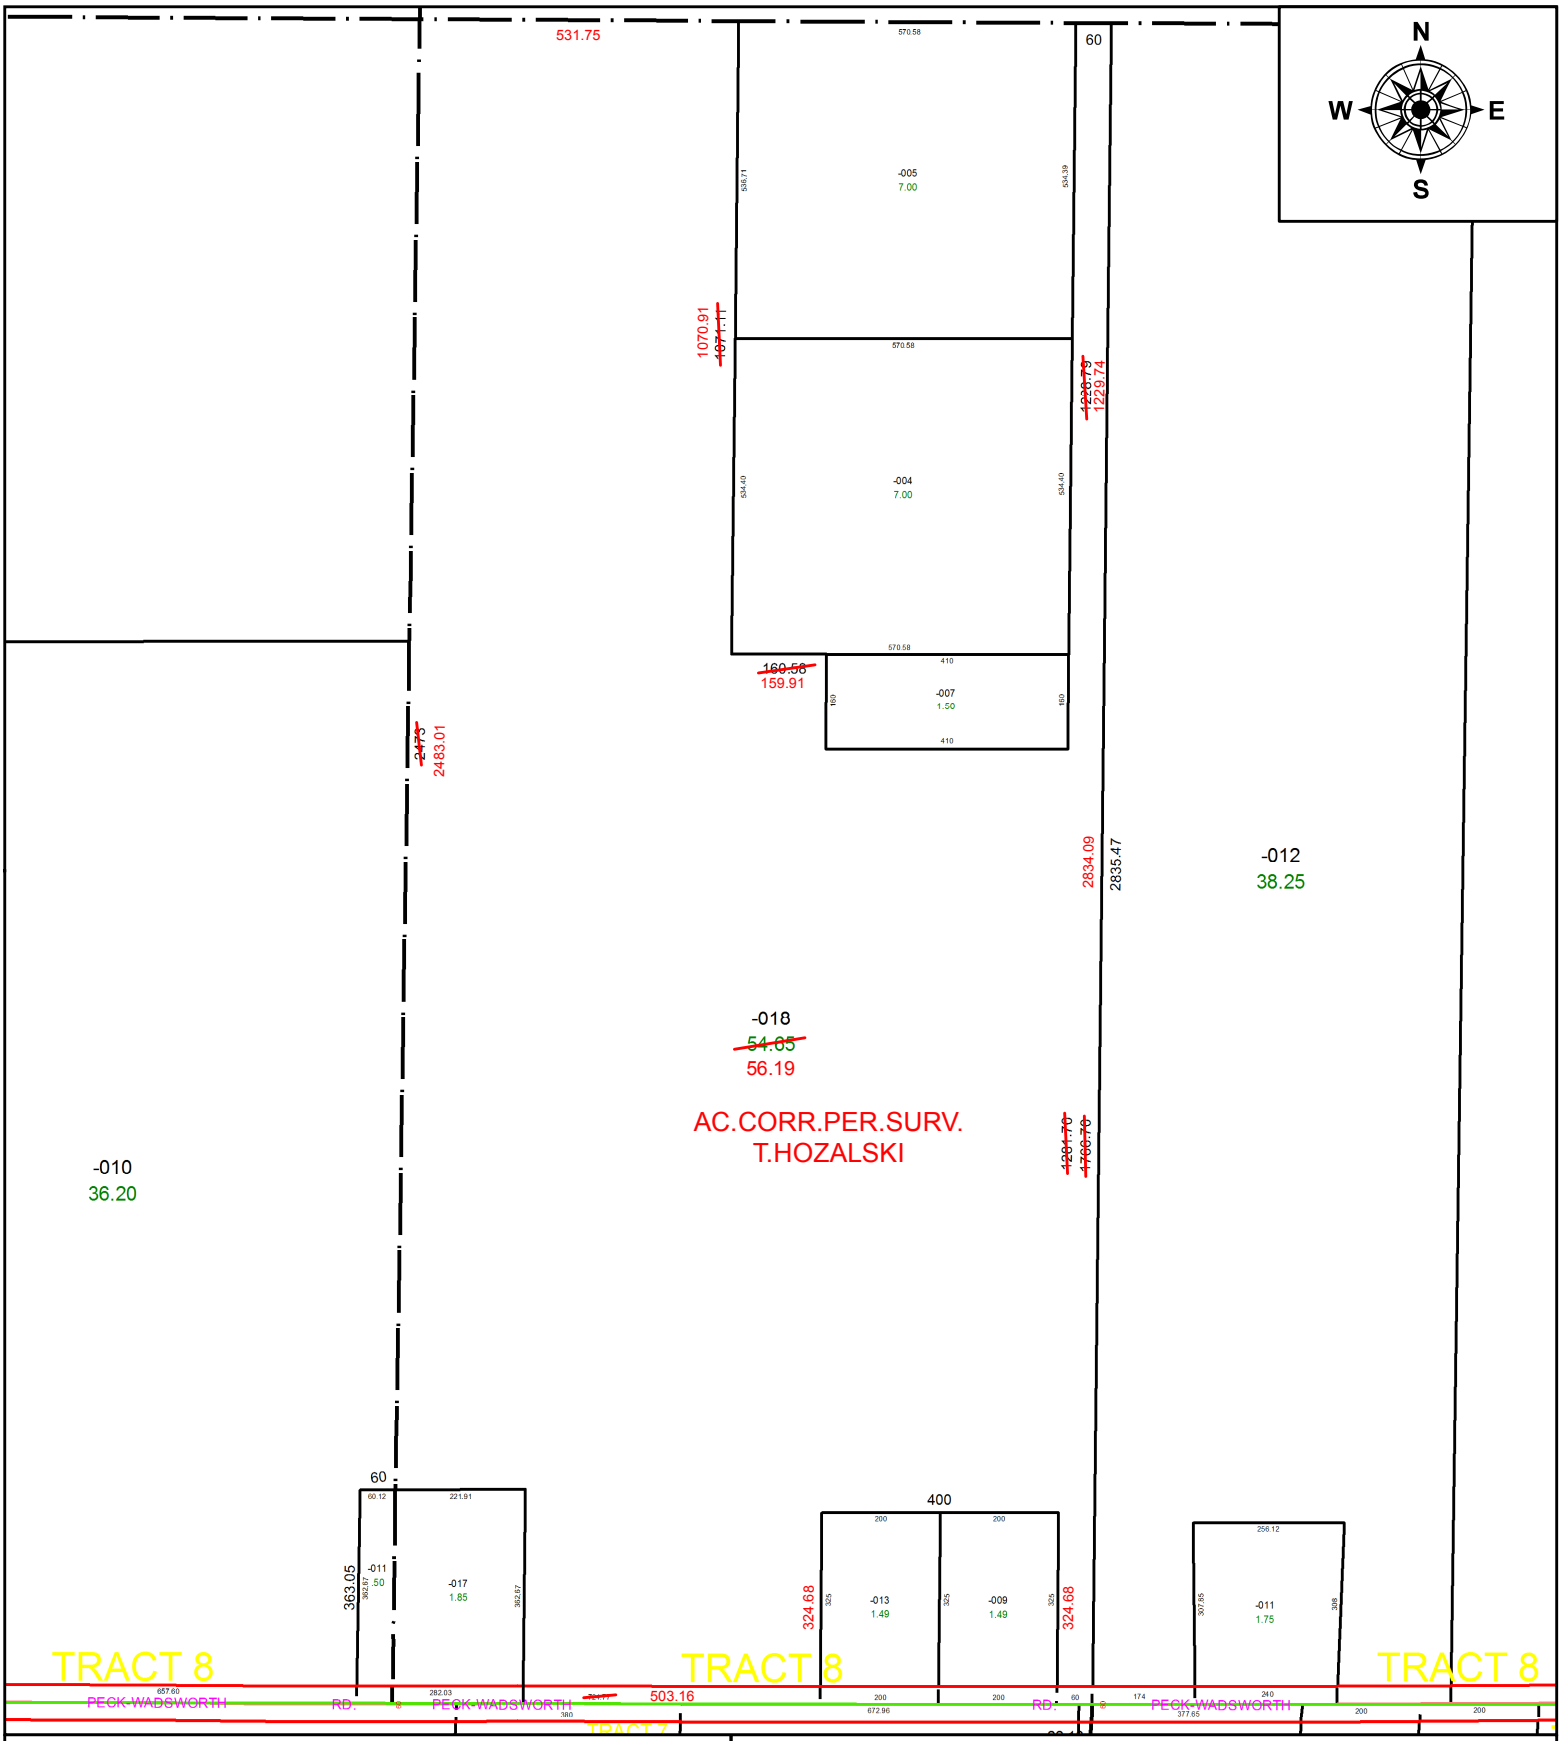


**SPLITS/DEEDS PROCESSED**

LORAIN COUNTY TAX MAP DEPARTMENT
226 MIDDLE AVE. ELYRIA, OH

**SURVEYED BY:** TIMOTHY D. HOZALSKI
**CLOSURE:** 1:1,126,471
**MAP PAGE(S):** 17-08-031
**APPOVED BY:** RRM **DATE:** 12-7-20
**SCALE:** 1" = 325 **PRIOR INSTRUMENT:** 20200788019