PARENT PARCEL: 03-00-001-000-140
CHILD PARCEL: 03-00-001-000-205 & -206
STARTING POINT: C/L OF WATERFORD AND HOAG DR

22-04450

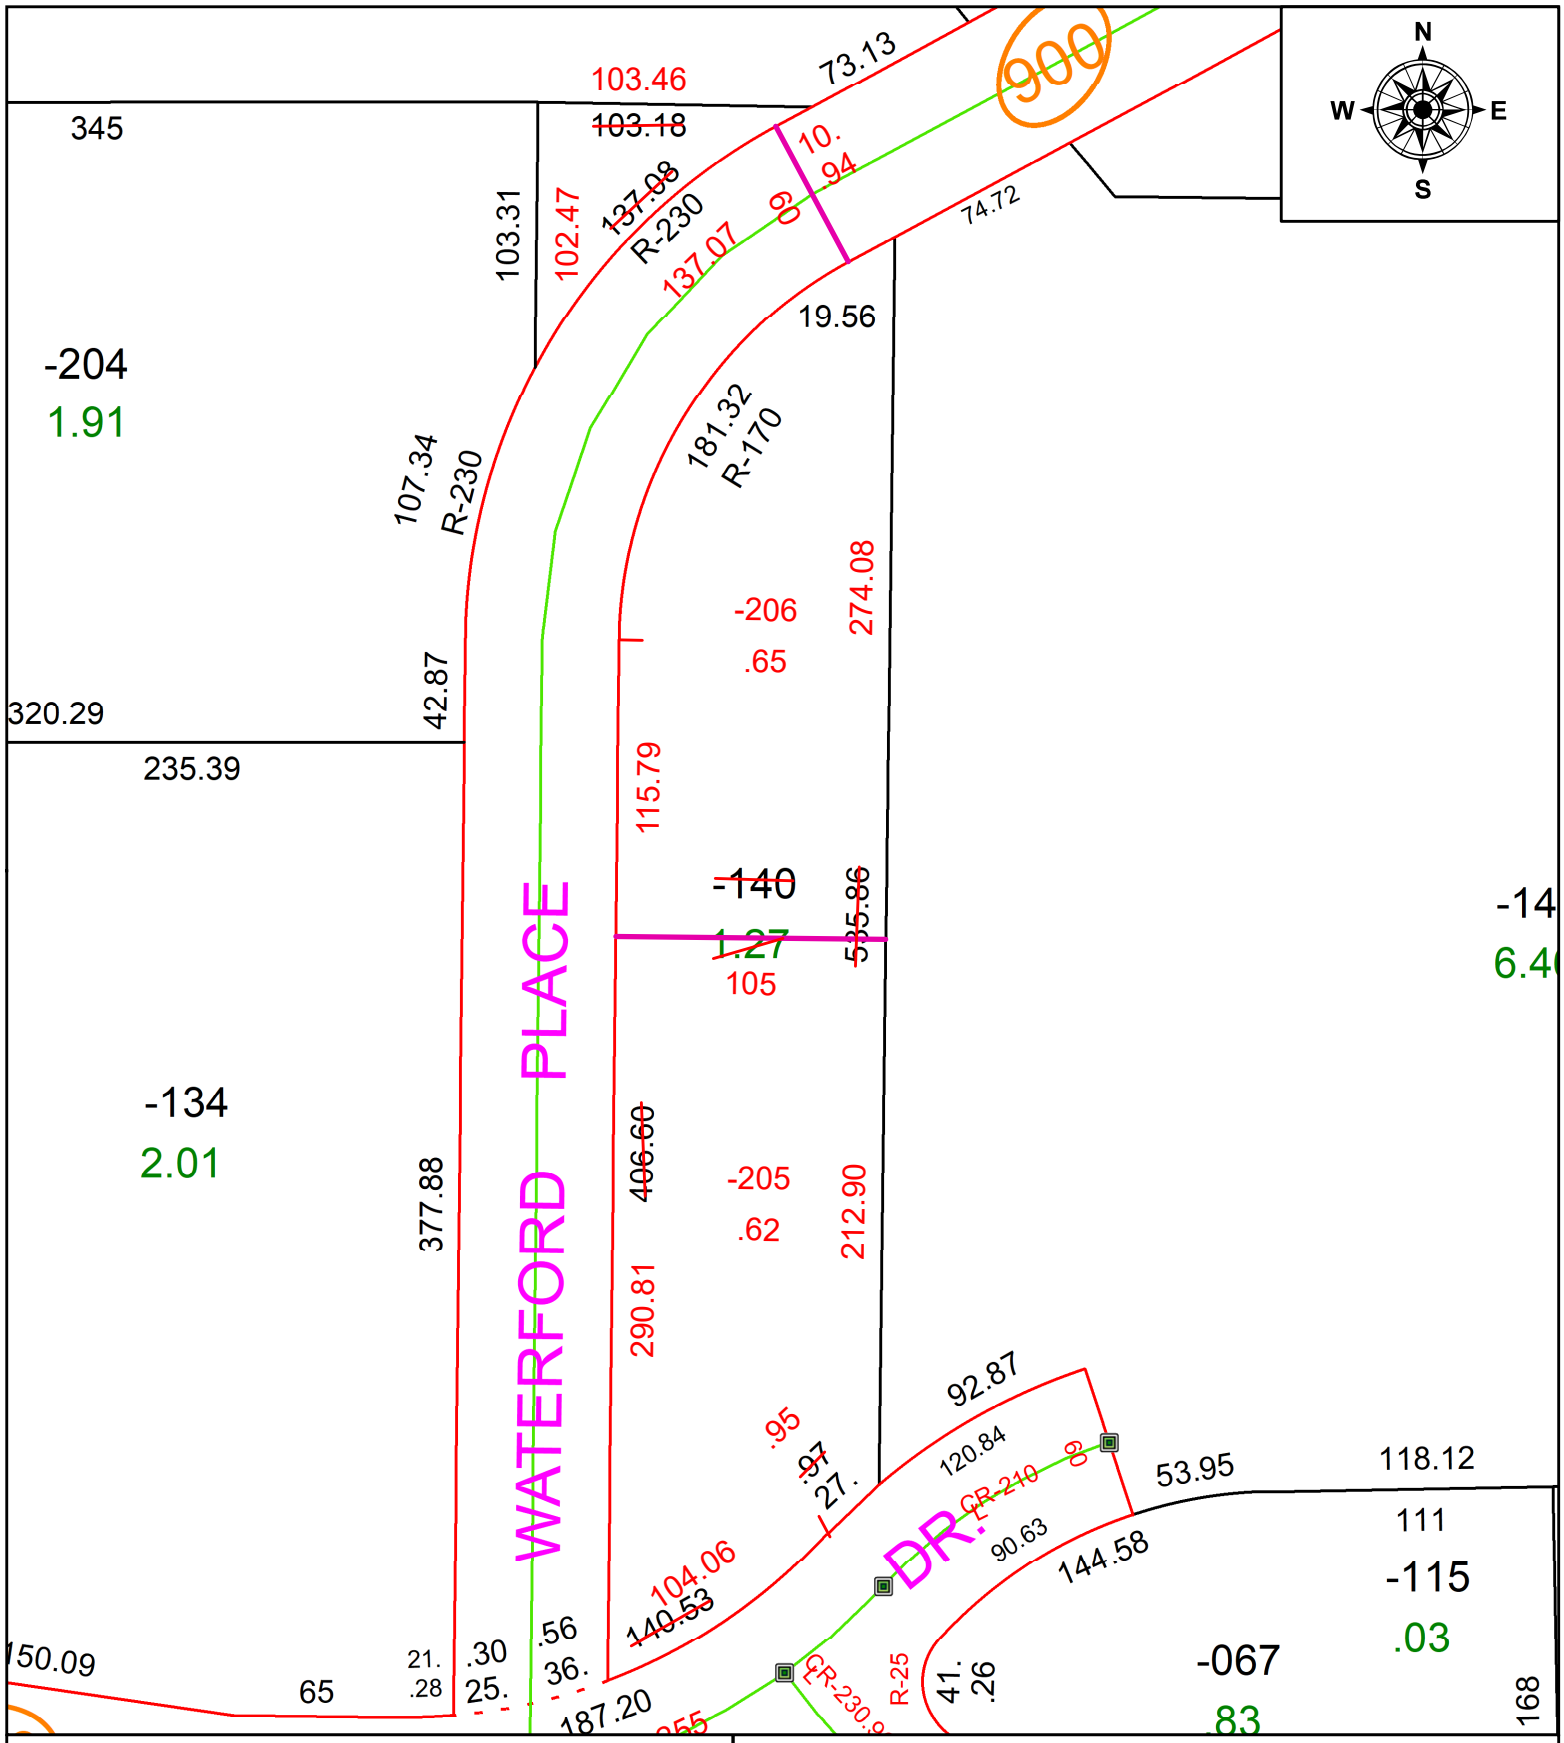

SPLITS/DEEDS PROCESSED
LORAIN COUNTY TAX MAP DEPARTMENT
226 MIDDLE AVE. ELYRIA, OH

SURVEYED BY: STAN R. LOCH
CLOSURE: 1: 159087
MAP PAGE(S): 03-00-001-A
APPOVED BY: AC **DATE:** 3/21/2022
SCALE: 1" = 75 **PRIOR INSTRUMENT:** VOL 424 PG 131