PARENT PARCEL: 04-00-011-101-006

CHILD PARCEL:

STARTING POINT: INTERSECTION OF C/L OF DETROIT RD. AND C/L OF HAYES ST.

20-04453-C

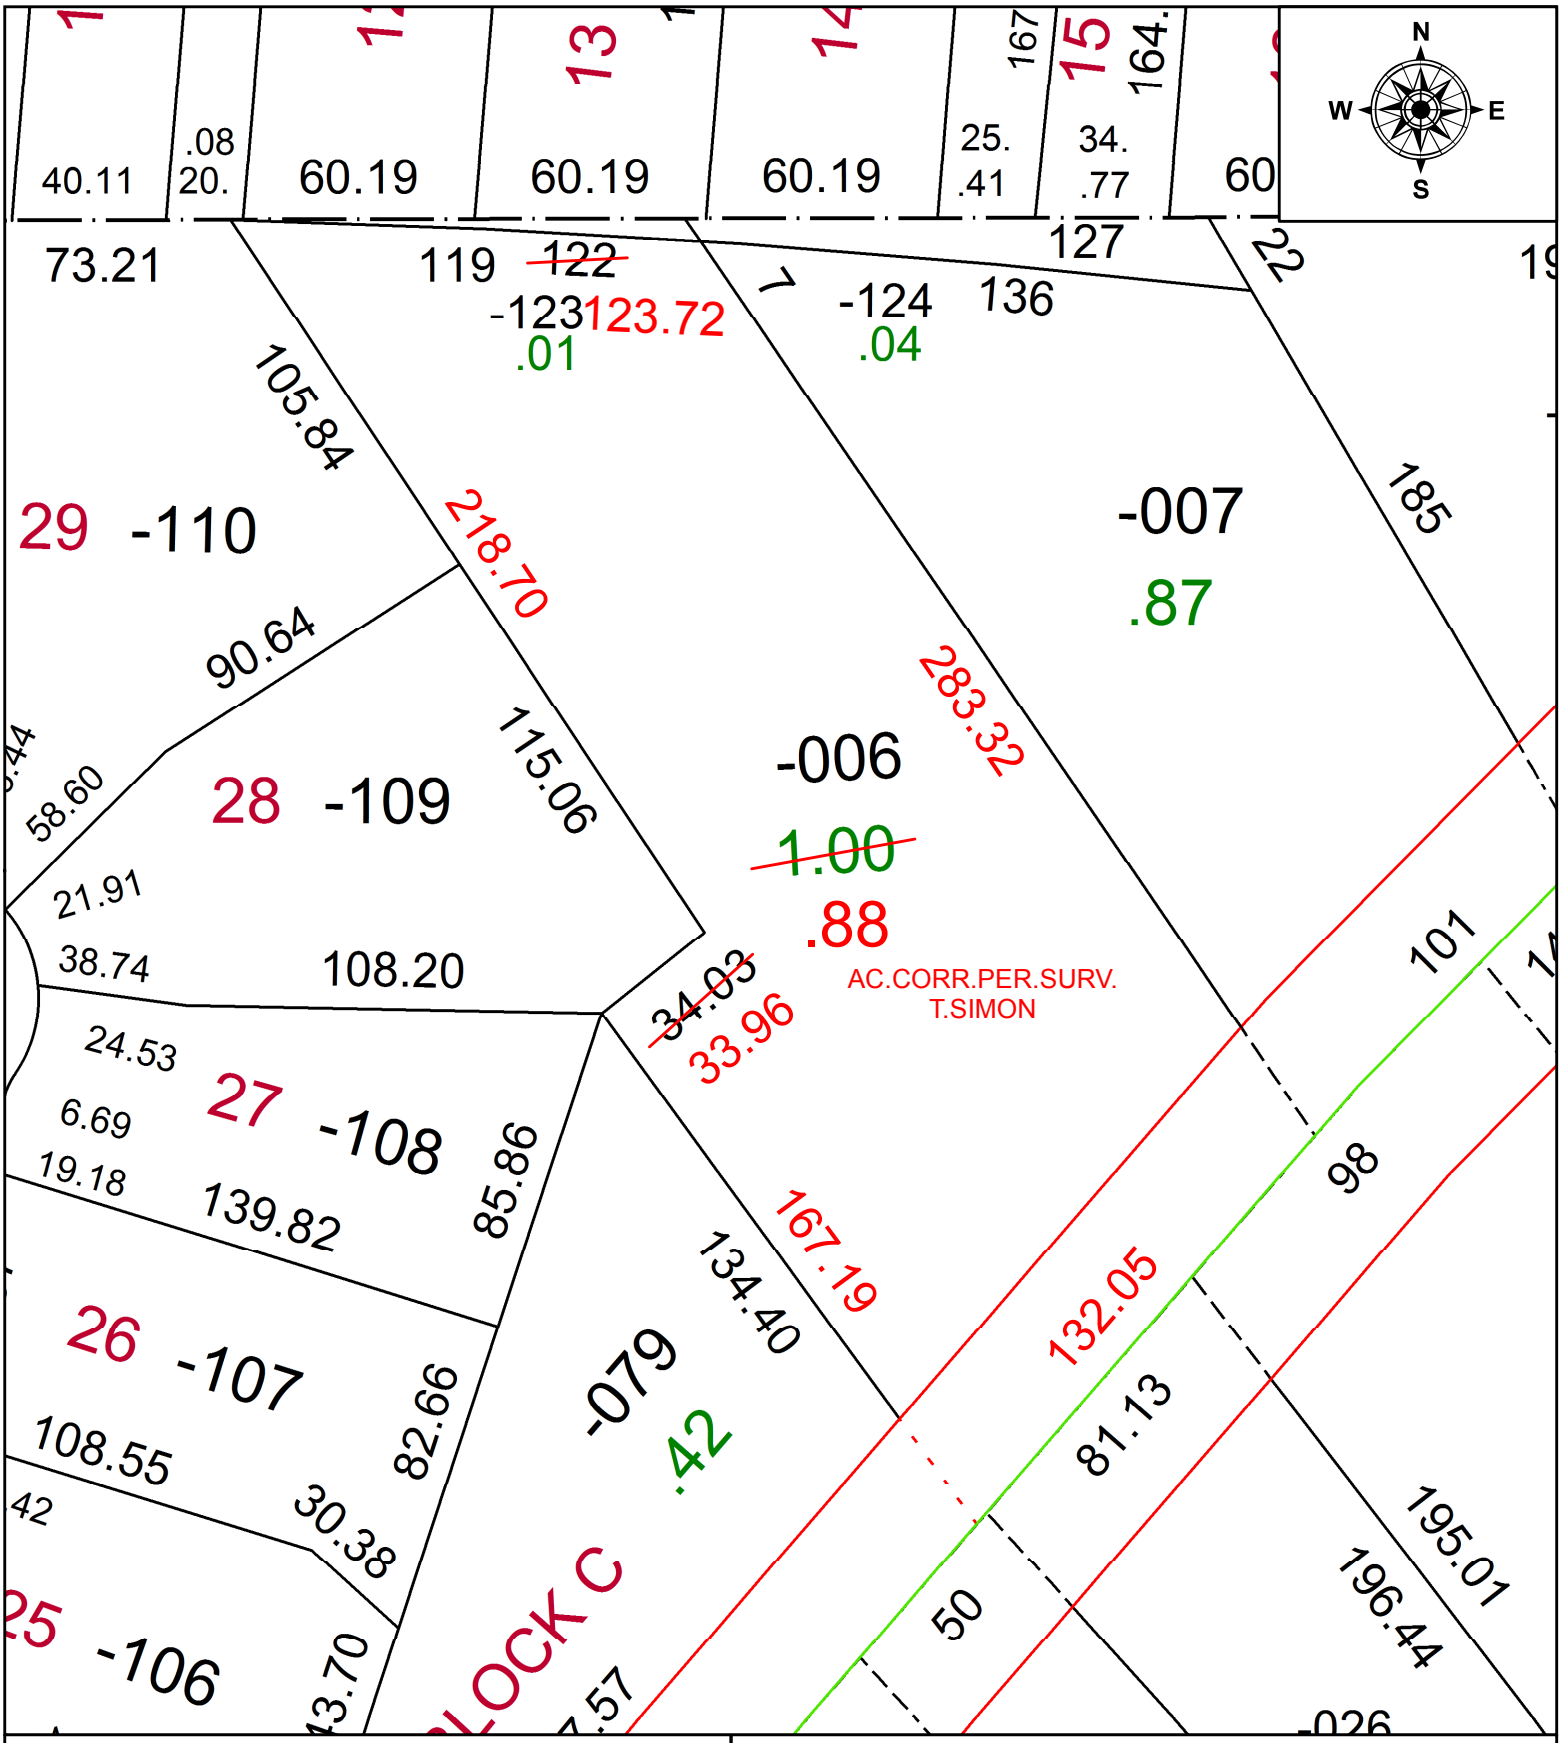

SPLITS/DEEDS PROCESSED

LORAIN COUNTY TAX MAP DEPARTMENT
226 MIDDLE AVE. ELYRIA, OH

SURVEYED BY: THOMAS A. SIMON
CLOSURE: 1:122,939
MAP PAGE(S): 4-00-011
APPOVED BY: RRM **DATE:** 12-11-20
SCALE: 1" = 50 **PRIOR INSTRUMENT:** 20200780351