PARENT PARCEL: 15-00-055-102-002
CHILD PARCEL:
STARTING POINT: NORTHWEST CORNER OF O.L.55

20-04457-C

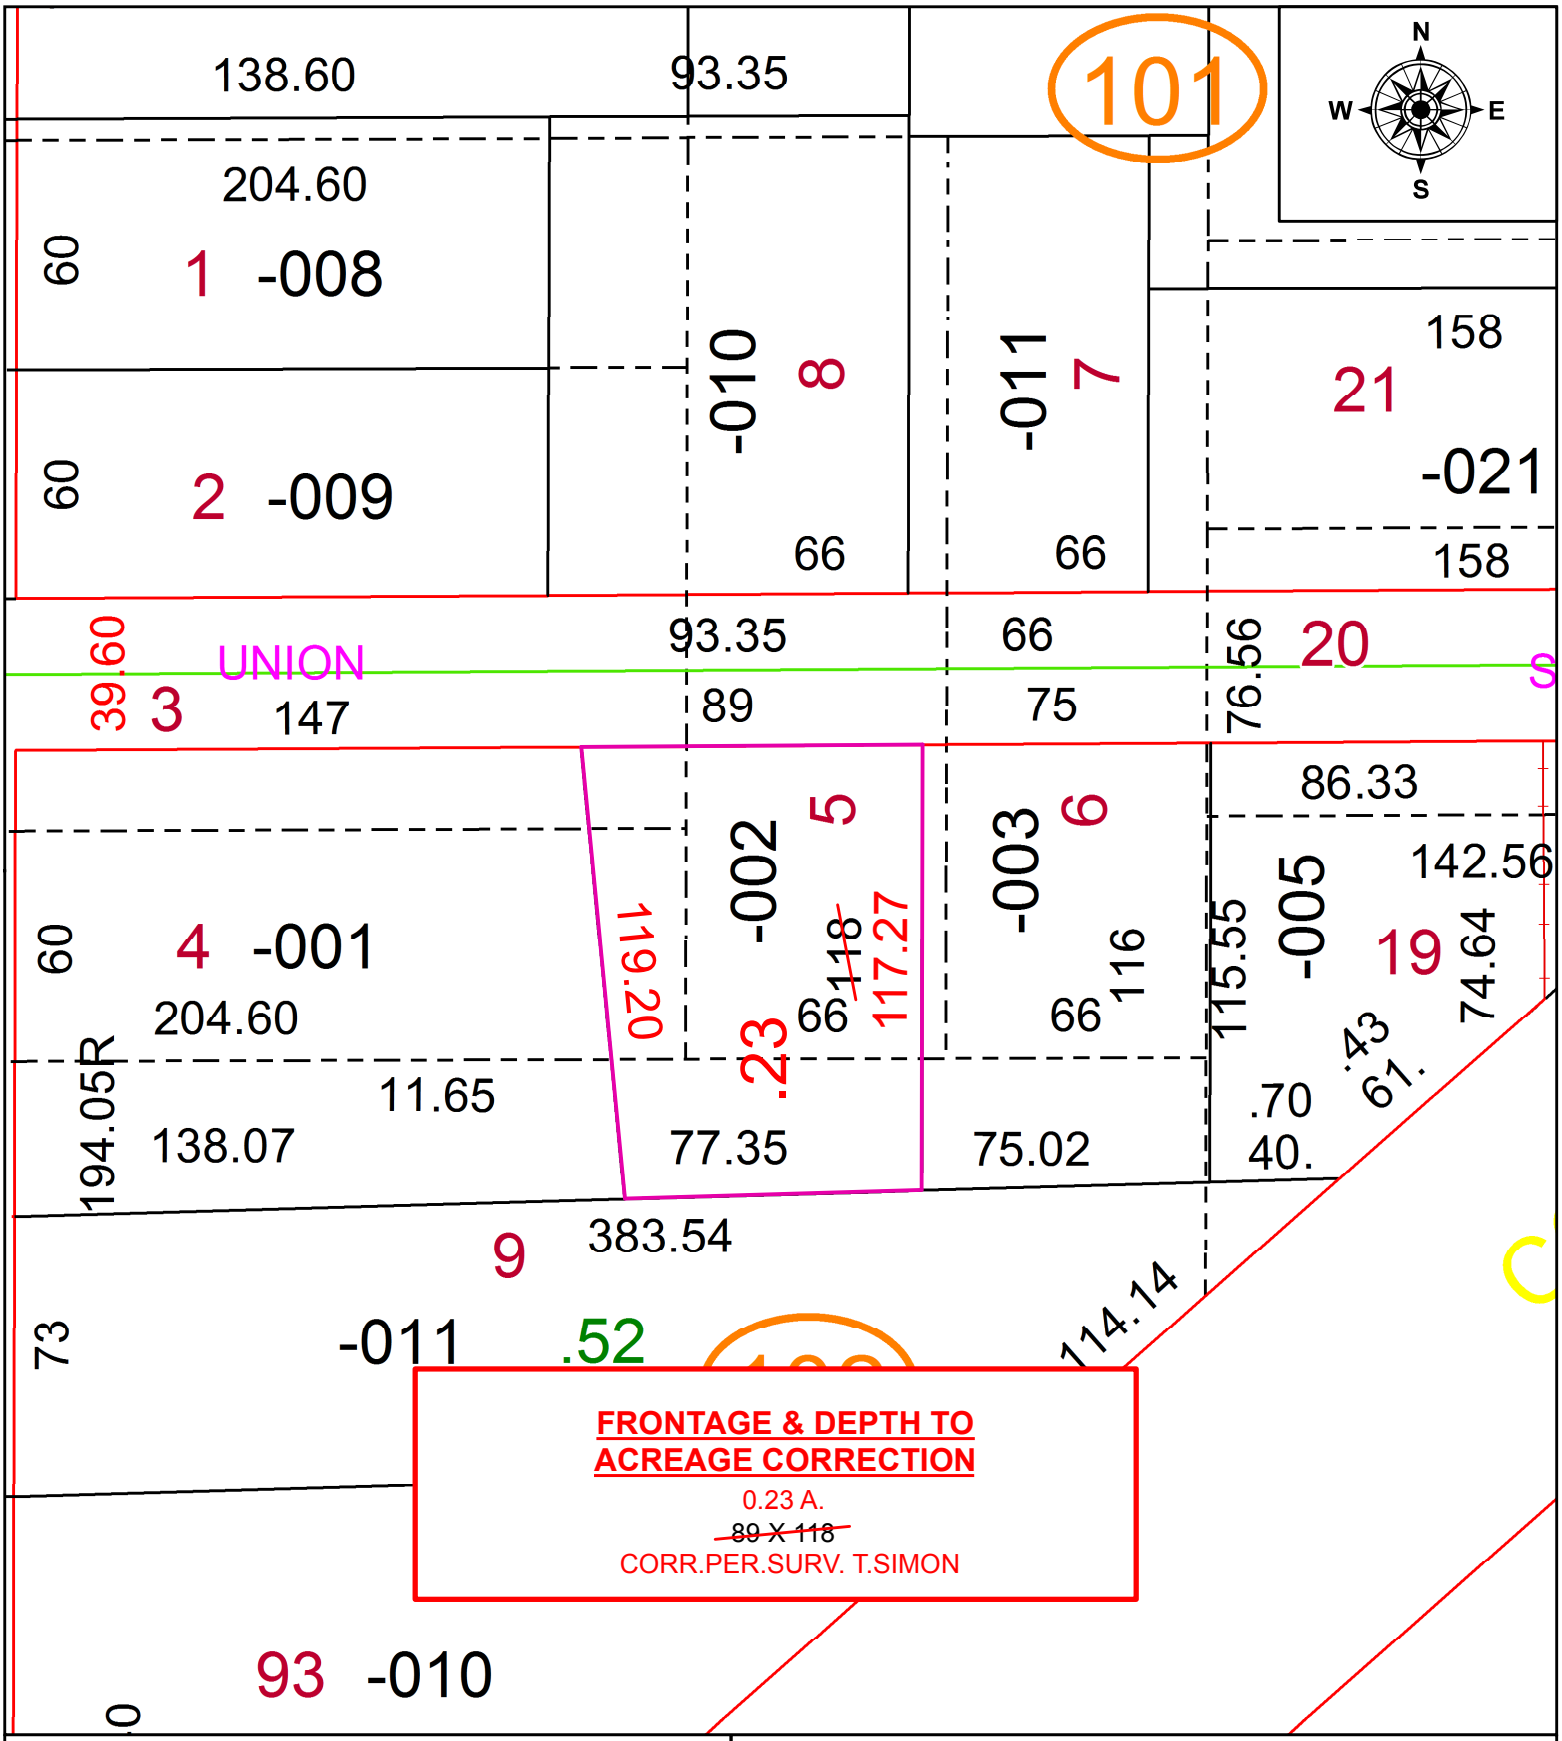

SPLITS/DEEDS PROCESSED
LORAIN COUNTY TAX MAP DEPARTMENT
226 MIDDLE AVE. ELYRIA, OH

SURVEYED BY: THOMAS A. SIMON
CLOSURE: 1: 192,612
MAP PAGE(S): 15-00-055
APPOVED BY: RRM **DATE:** 12-17-20
SCALE: 1" = 50 **PRIOR INSTRUMENT:** 20180671716