PARENT PARCEL: 04-00-030-111-017, -018, & -046

CHILD PARCEL: 04-00-030-111-068

STARTING POINT: NORTHWEST CORNER OF S/L 43 IN AVONDOVER BEACH SUBDIVISION

22-04458

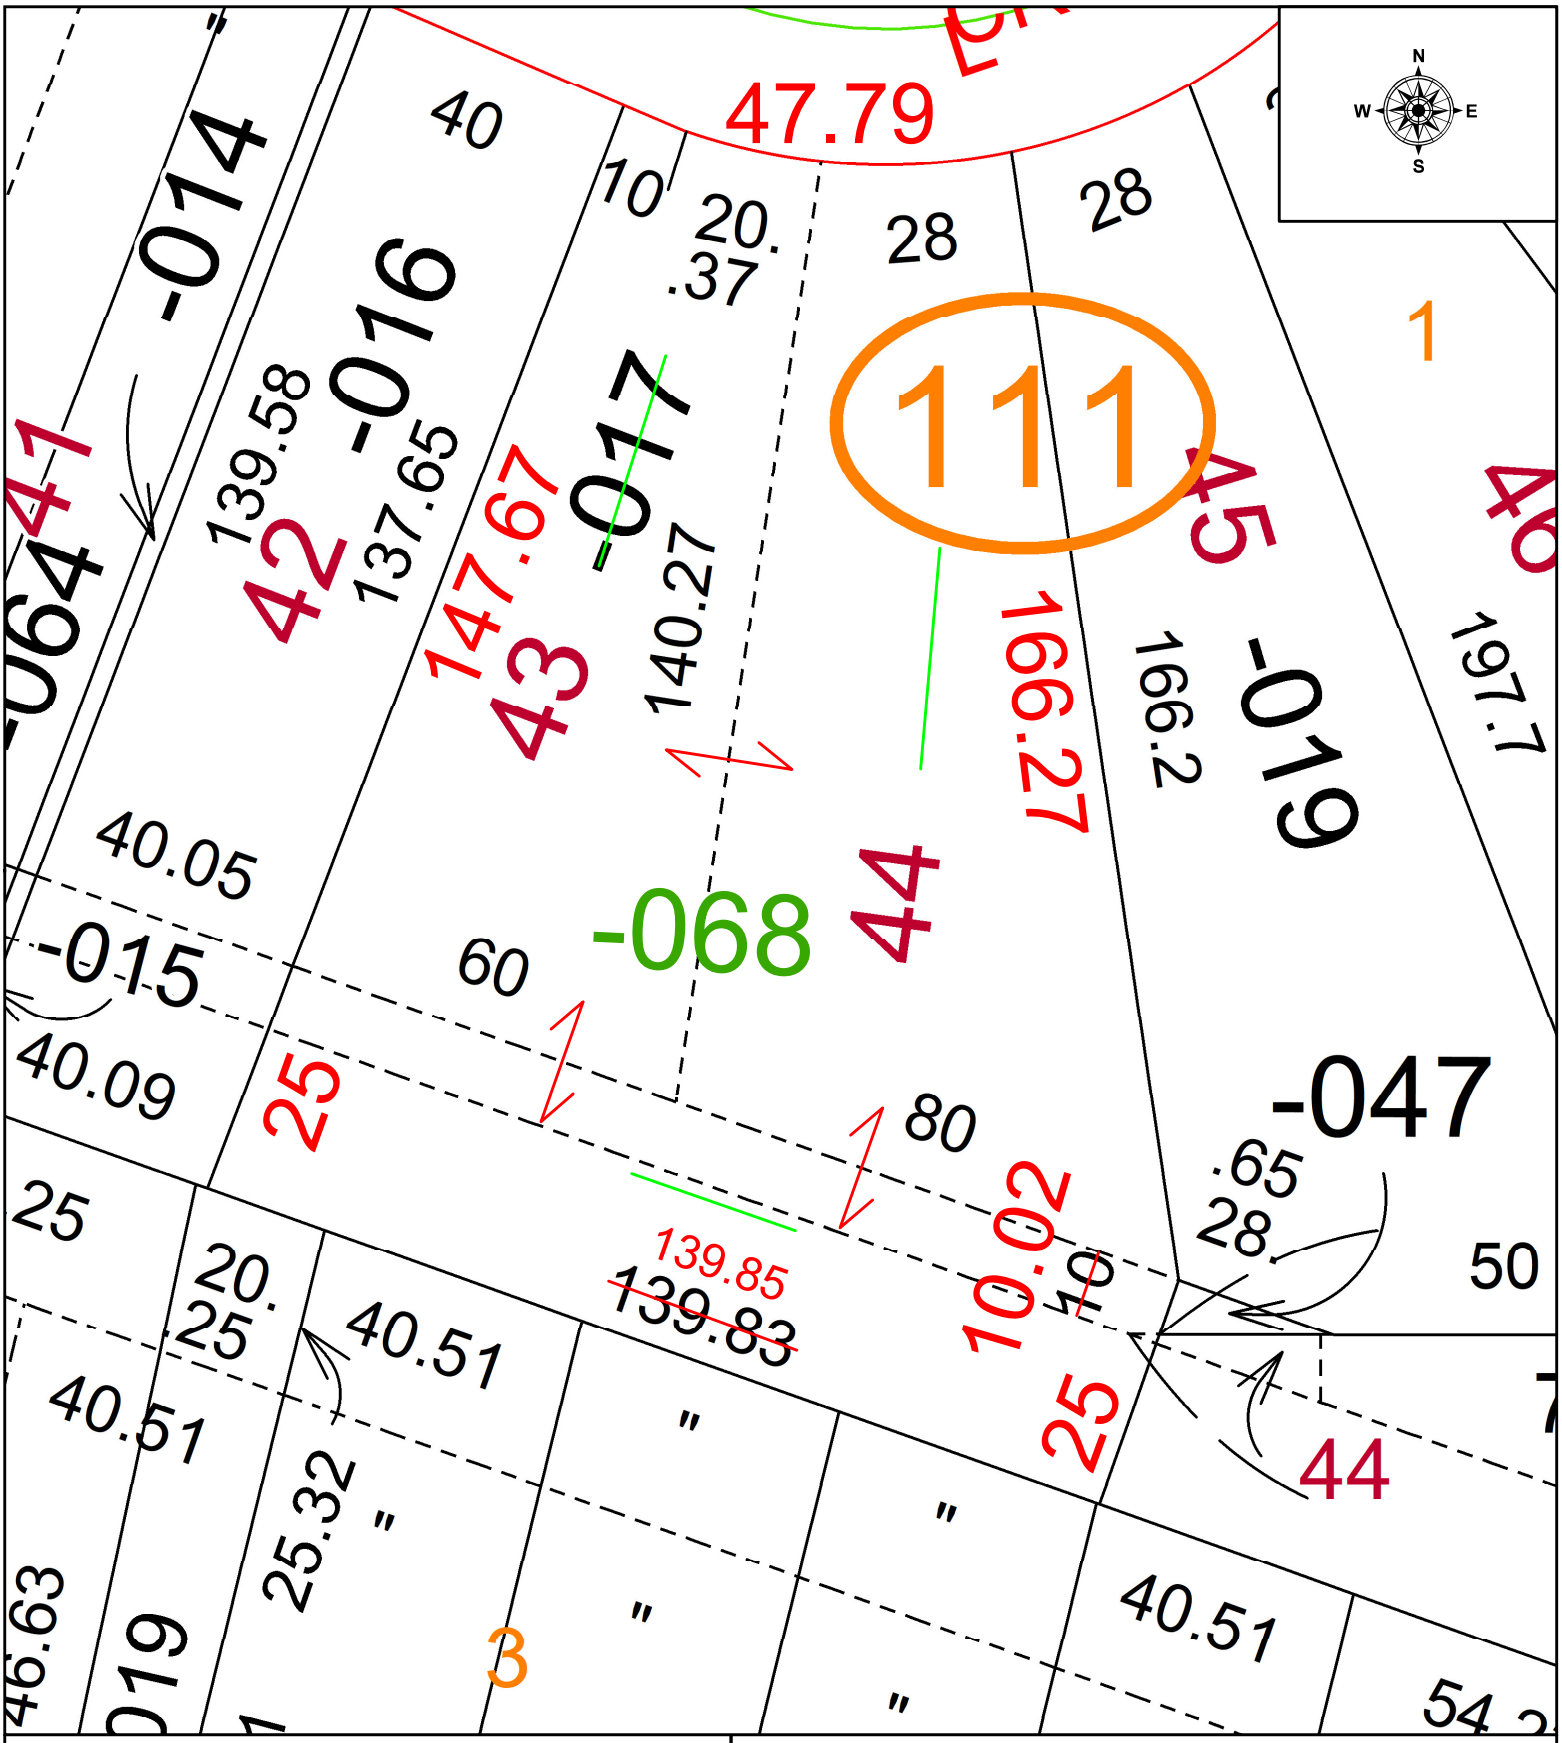

SPLITS/DEEDS PROCESSED

LORAIN COUNTY TAX MAP DEPARTMENT
226 MIDDLE AVE. ELYRIA, OH

SURVEYED BY: WILFREDO BARBOSA
CLOSURE: 1: 185615
MAP PAGE(S): 04-00-030
APPOVED BY: WRZ **DATE:** 4/6/2022
SCALE: 1" = 25 **PRIOR INSTRUMENT:** 2020-0785109