PARENT PARCEL: 02-03-005-101-021, -022
CHILD PARCEL: 02-03-005-101-064
STARTING POINT: COMBINATION PER DEED

22-04459

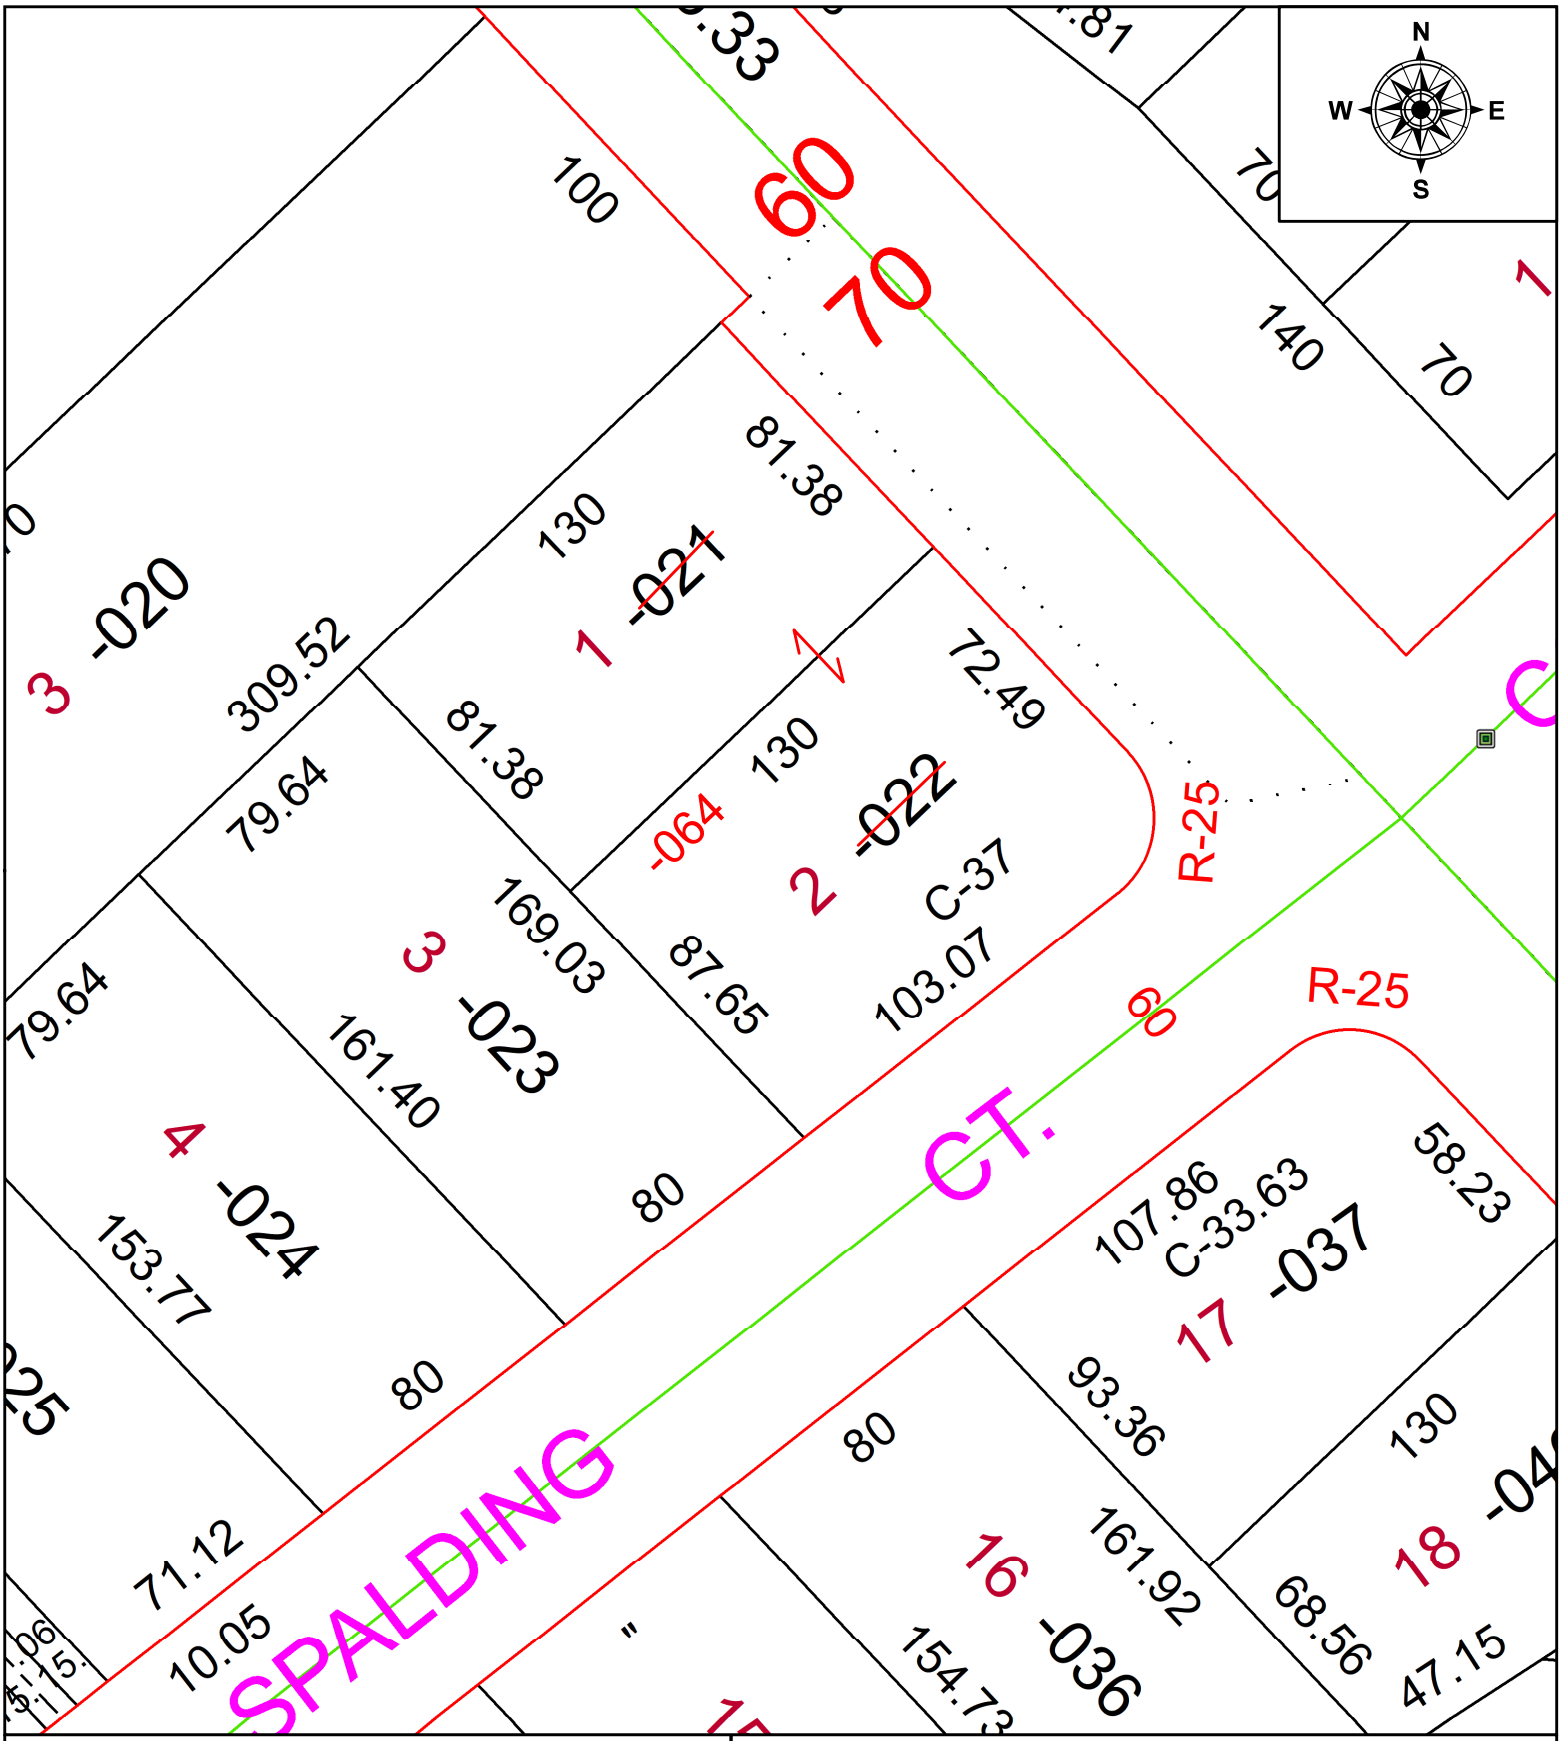

SPLITS/DEEDS PROCESSED
LORAIN COUNTY TAX MAP DEPARTMENT
226 MIDDLE AVE. ELYRIA, OH

SURVEYED BY: N/A
CLOSURE: N/A
MAP PAGE(S): 02-03-005
APPOVED BY: AC **DATE:** 4/6/2022
SCALE: 1" = 50 **PRIOR INSTRUMENT:** 2018- 0692602