PARENT PARCEL: 04-00-012-103-044
CHILD PARCEL: MAP CORRECTION ONLY
STARTING POINT: 1" I.P. MON. BOX, CL OF STONEY RIDGE RD. & SOUTH LINE OF SECTION 12

20-04464-D

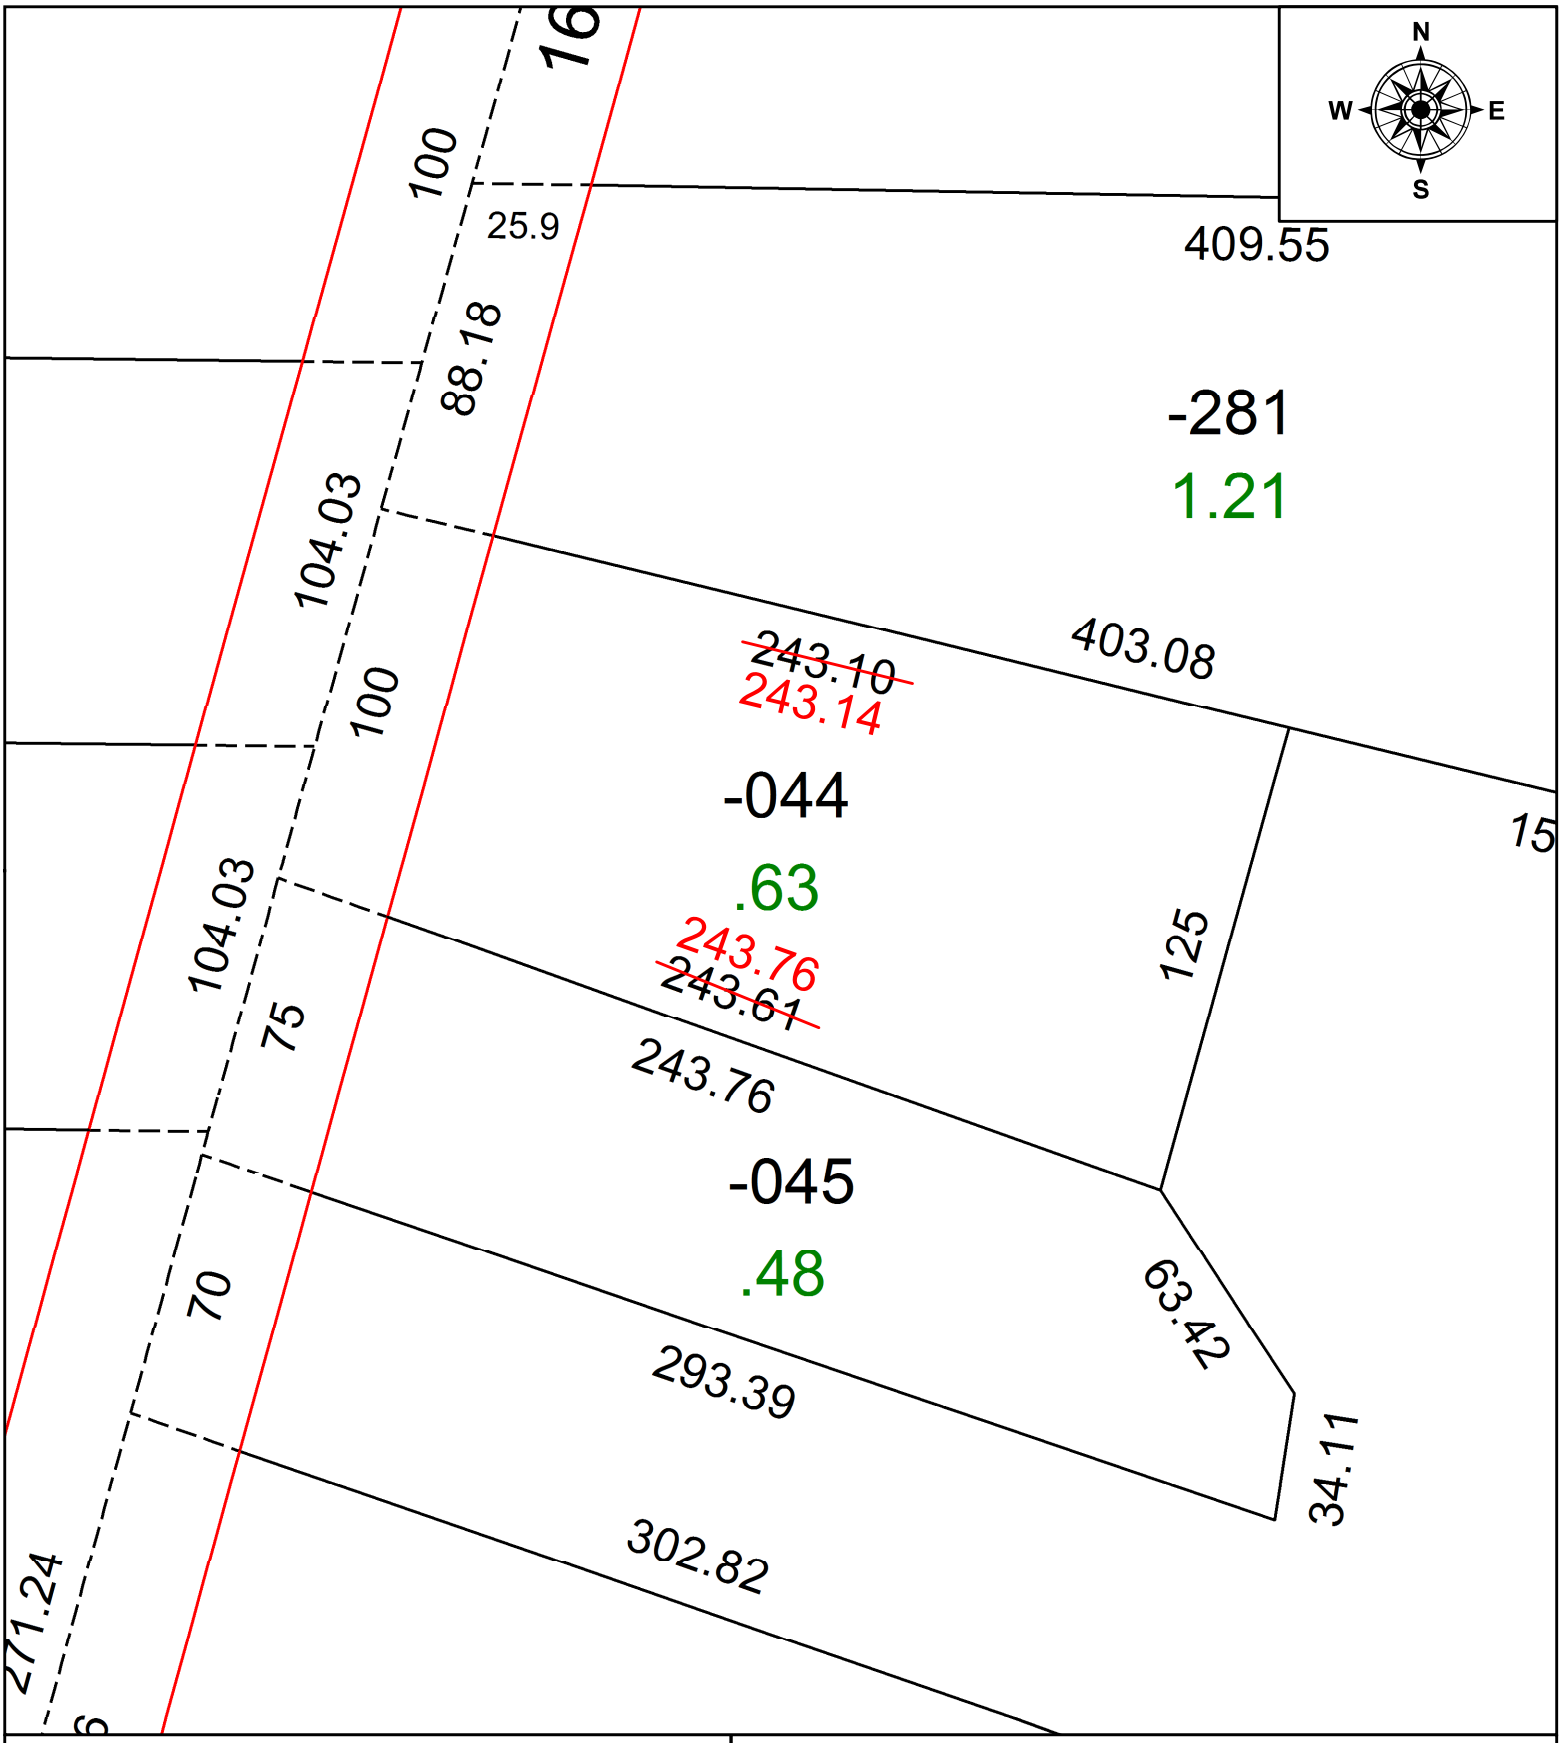

SPLITS/DEEDS PROCESSED
LORAIN COUNTY TAX MAP DEPARTMENT
226 MIDDLE AVE. ELYRIA, OH

SURVEYED BY: AMY KELLY
CLOSURE: 1:72292
MAP PAGE(S): 04-00-012
APPOVED BY: TJS **DATE:** 12/31/2020
SCALE: 1" = 50' **PRIOR INSTRUMENT:** 2004-0980874