PARENT PARCEL: 15-00-056-101-003 & -055
CHILD PARCEL: 15-00-056-101-060 THRU -062
STARTING POINT: N.E. CORNER O.L. 56

22-04464

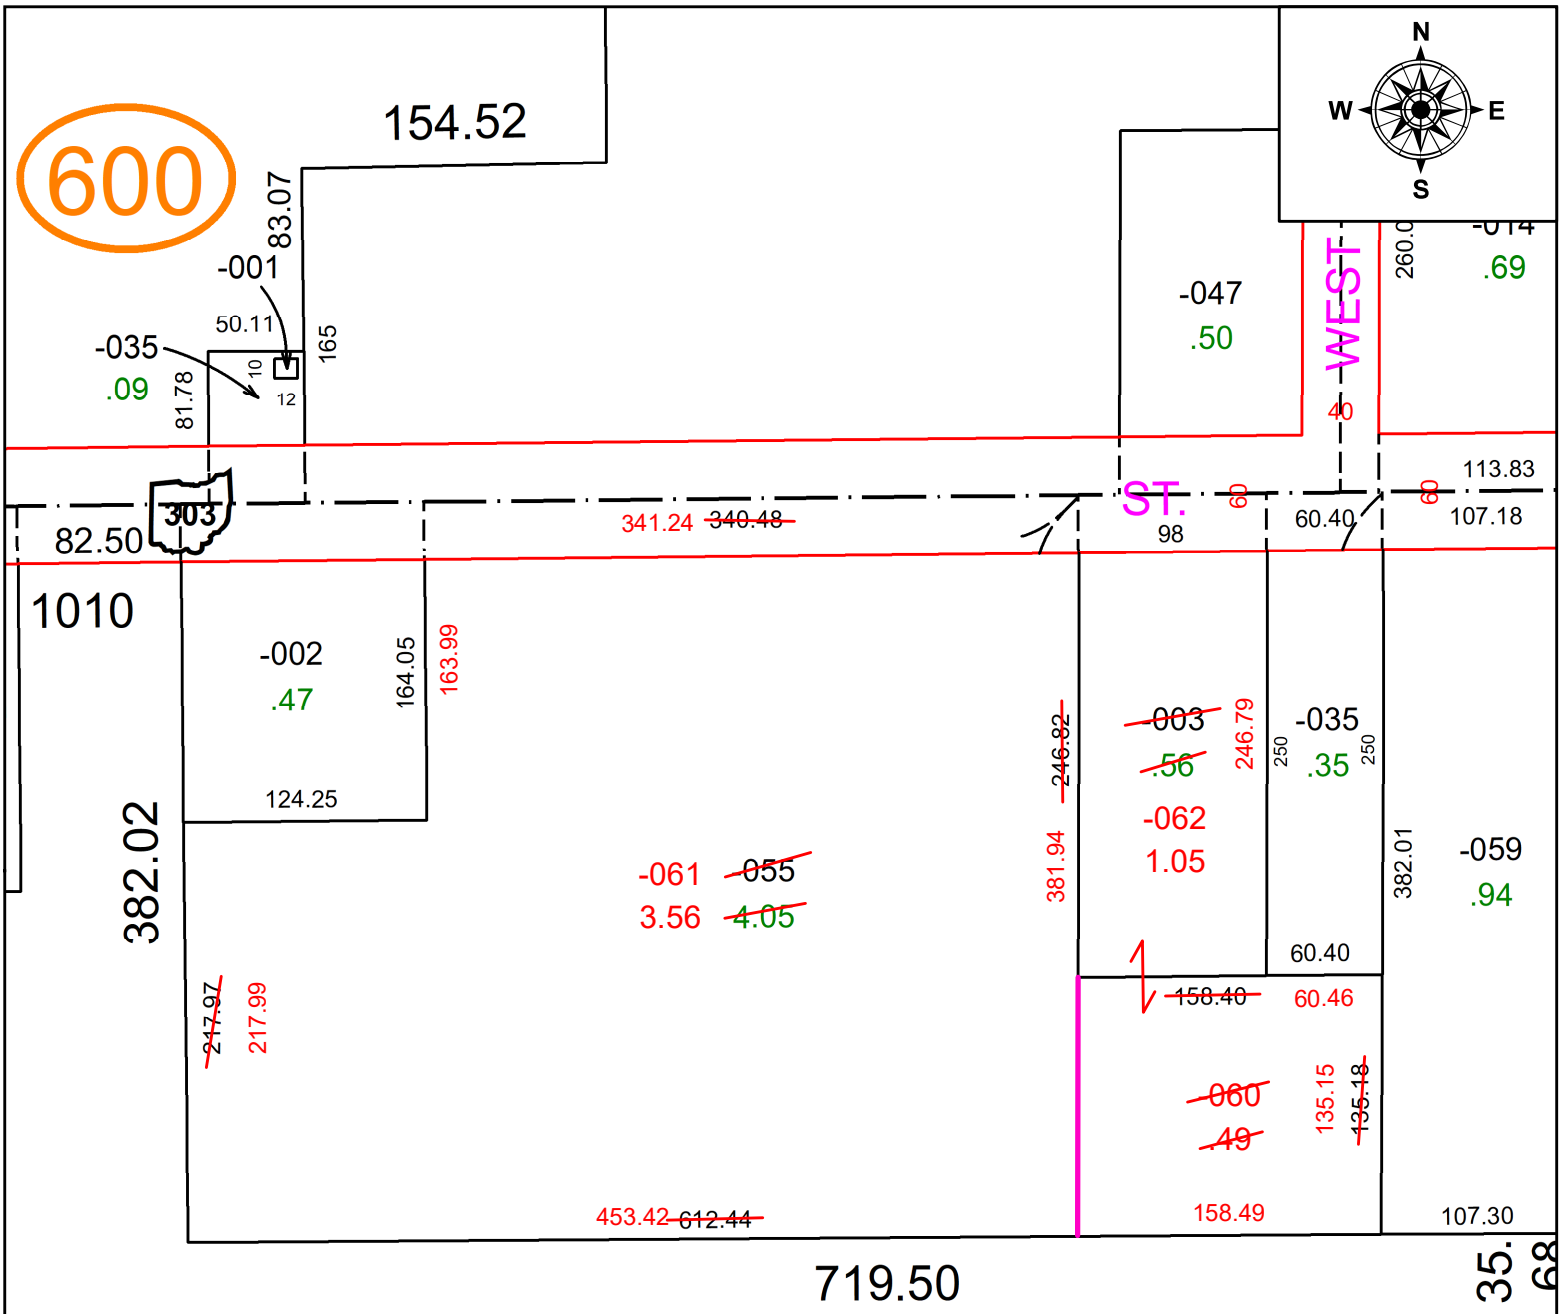

SPLITS/DEEDS PROCESSED
LORAIN COUNTY TAX MAP DEPARTMENT
226 MIDDLE AVE. ELYRIA, OH

SURVEYED BY: THOMAS SIMON
CLOSURE: 1: 391684
MAP PAGE(S): 15-00-056
APPOVED BY: DMA **DATE:** 4/18/2022
SCALE: 1" = 100' **PRIOR INSTRUMENT:** 2018-0697162