PARENT PARCEL: 05-00-021-103-039

CHILD PARCEL:

STARTING POINT: INTERSECTION OF C/L OF N. MAIN ST. AND C/L OF UNNAMED R.O.W. IN PLAT VOL. 106 PG.8

21-04467-C

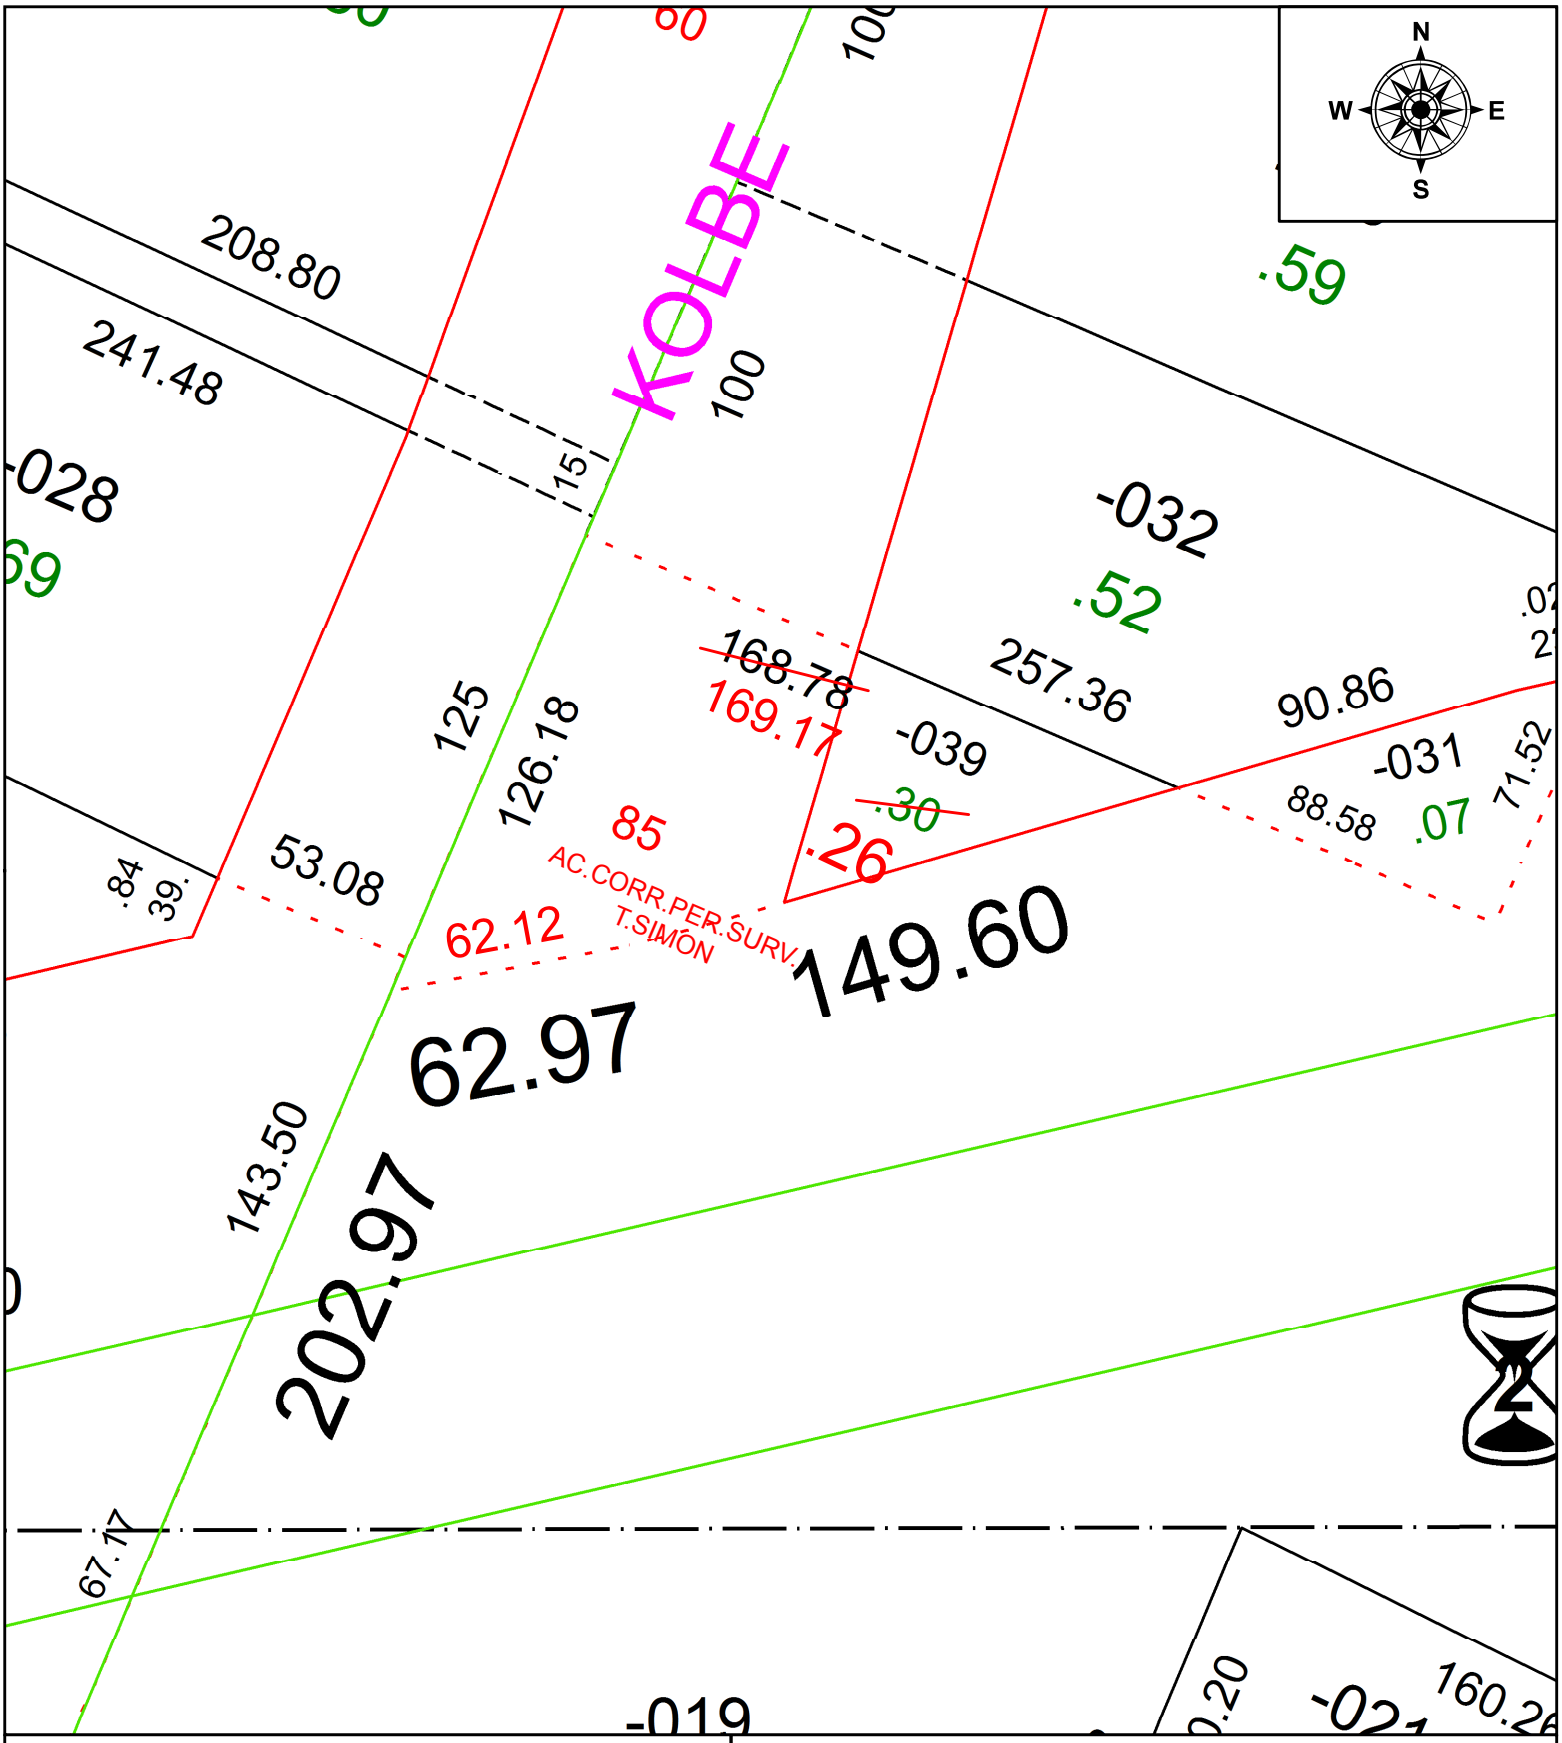

SPLITS/DEEDS PROCESSED

LORAIN COUNTY TAX MAP DEPARTMENT
226 MIDDLE AVE. ELYRIA, OH

SURVEYED BY: THOMAS A. SIMON
CLOSURE: 1: 213,237
MAP PAGE(S): 5-00-021
APPOVED BY: RRM **DATE:** 1-11-21
SCALE: 1" = 50 **PRIOR INSTRUMENT:** 20170653894