PARENT PARCEL: 07-00-023-102-013

CHILD PARCEL:

STARTING POINT: INTERSECTION OF C/L OF CHESTNUT RIDGE RD. AND C/L OF FOREST GLEN WAY

21-04468-D

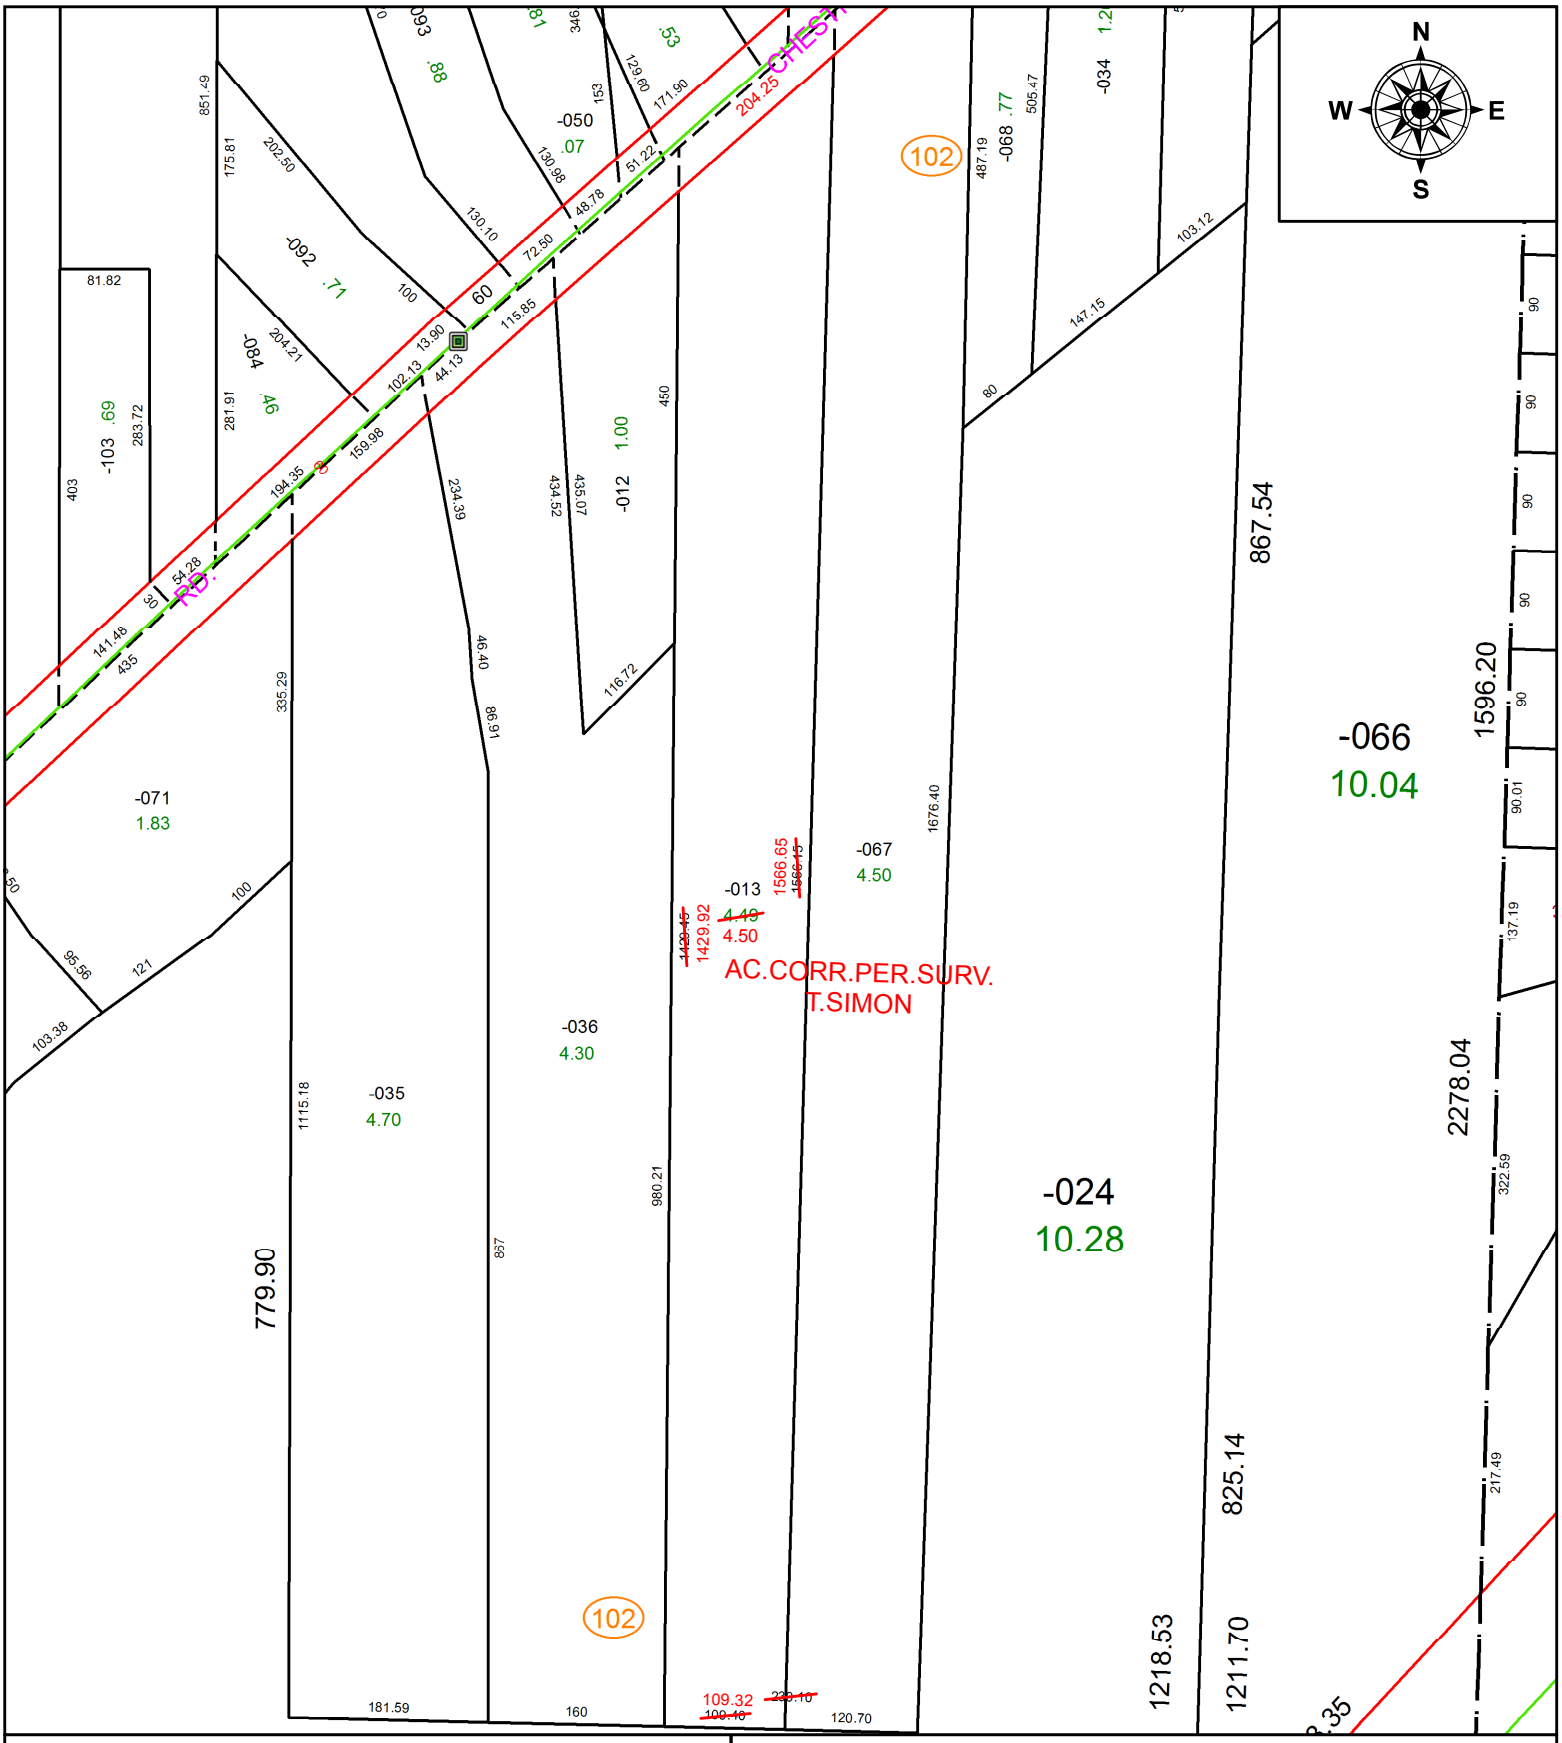

SPLITS/DEEDS PROCESSED

LORAIN COUNTY TAX MAP DEPARTMENT
226 MIDDLE AVE. ELYRIA, OH

SURVEYED BY: THOMAS A. SIMON
CLOSURE: 1: 1,032,827
MAP PAGE(S): 7-00-023
APPOVED BY: RRM **DATE:** 1-13-21
SCALE: 1" = 175 **PRIOR INSTRUMENT:** 20200786233