PARENT PARCEL: 18-00-028-106-022

CHILD PARCEL:

STARTING POINT: SOUTHWEST CORNER OF S/L 60 IN WADSWORTH ADD.

21-04470-D

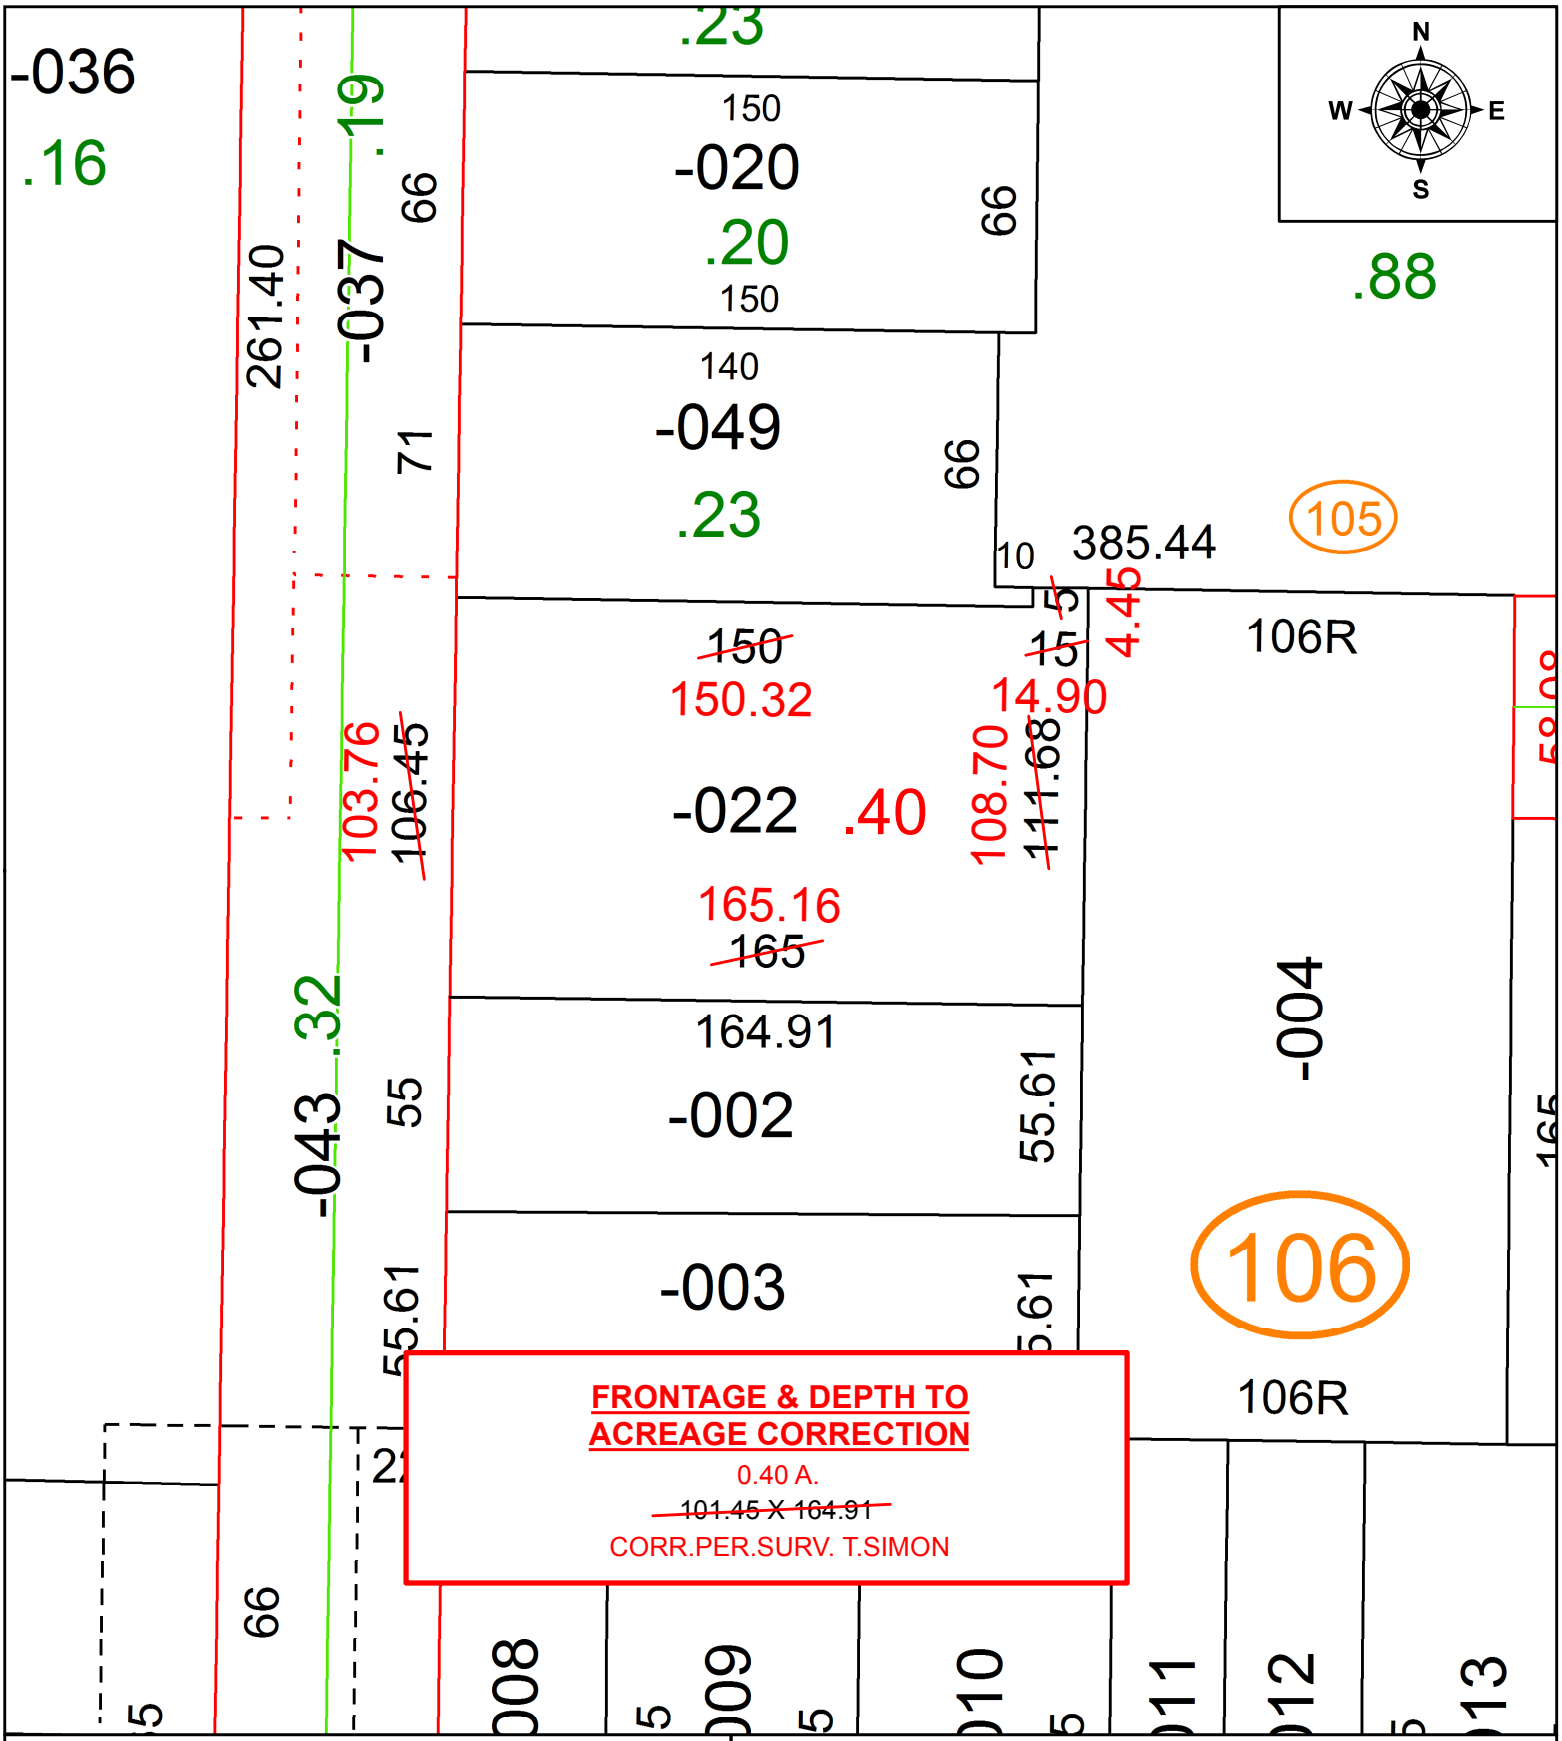

SPLITS/DEEDS PROCESSED

LORAIN COUNTY TAX MAP DEPARTMENT
226 MIDDLE AVE. ELYRIA, OH

SURVEYED BY: THOMAS A. SIMON
CLOSURE: 1:52,807
MAP PAGE(S): 18-00-028
APPOVED BY: RRM **DATE:** 1-15-21
SCALE: 1" = 50 **PRIOR INSTRUMENT:** 20120435506