PARENT PARCEL: 04-00-012-103-089

CHILD PARCEL:

STARTING POINT: INTERSECTION OF C/L OF STONEY RIDGE RD. AND SOUTH LINE OF SECTION 12

21-04471-D

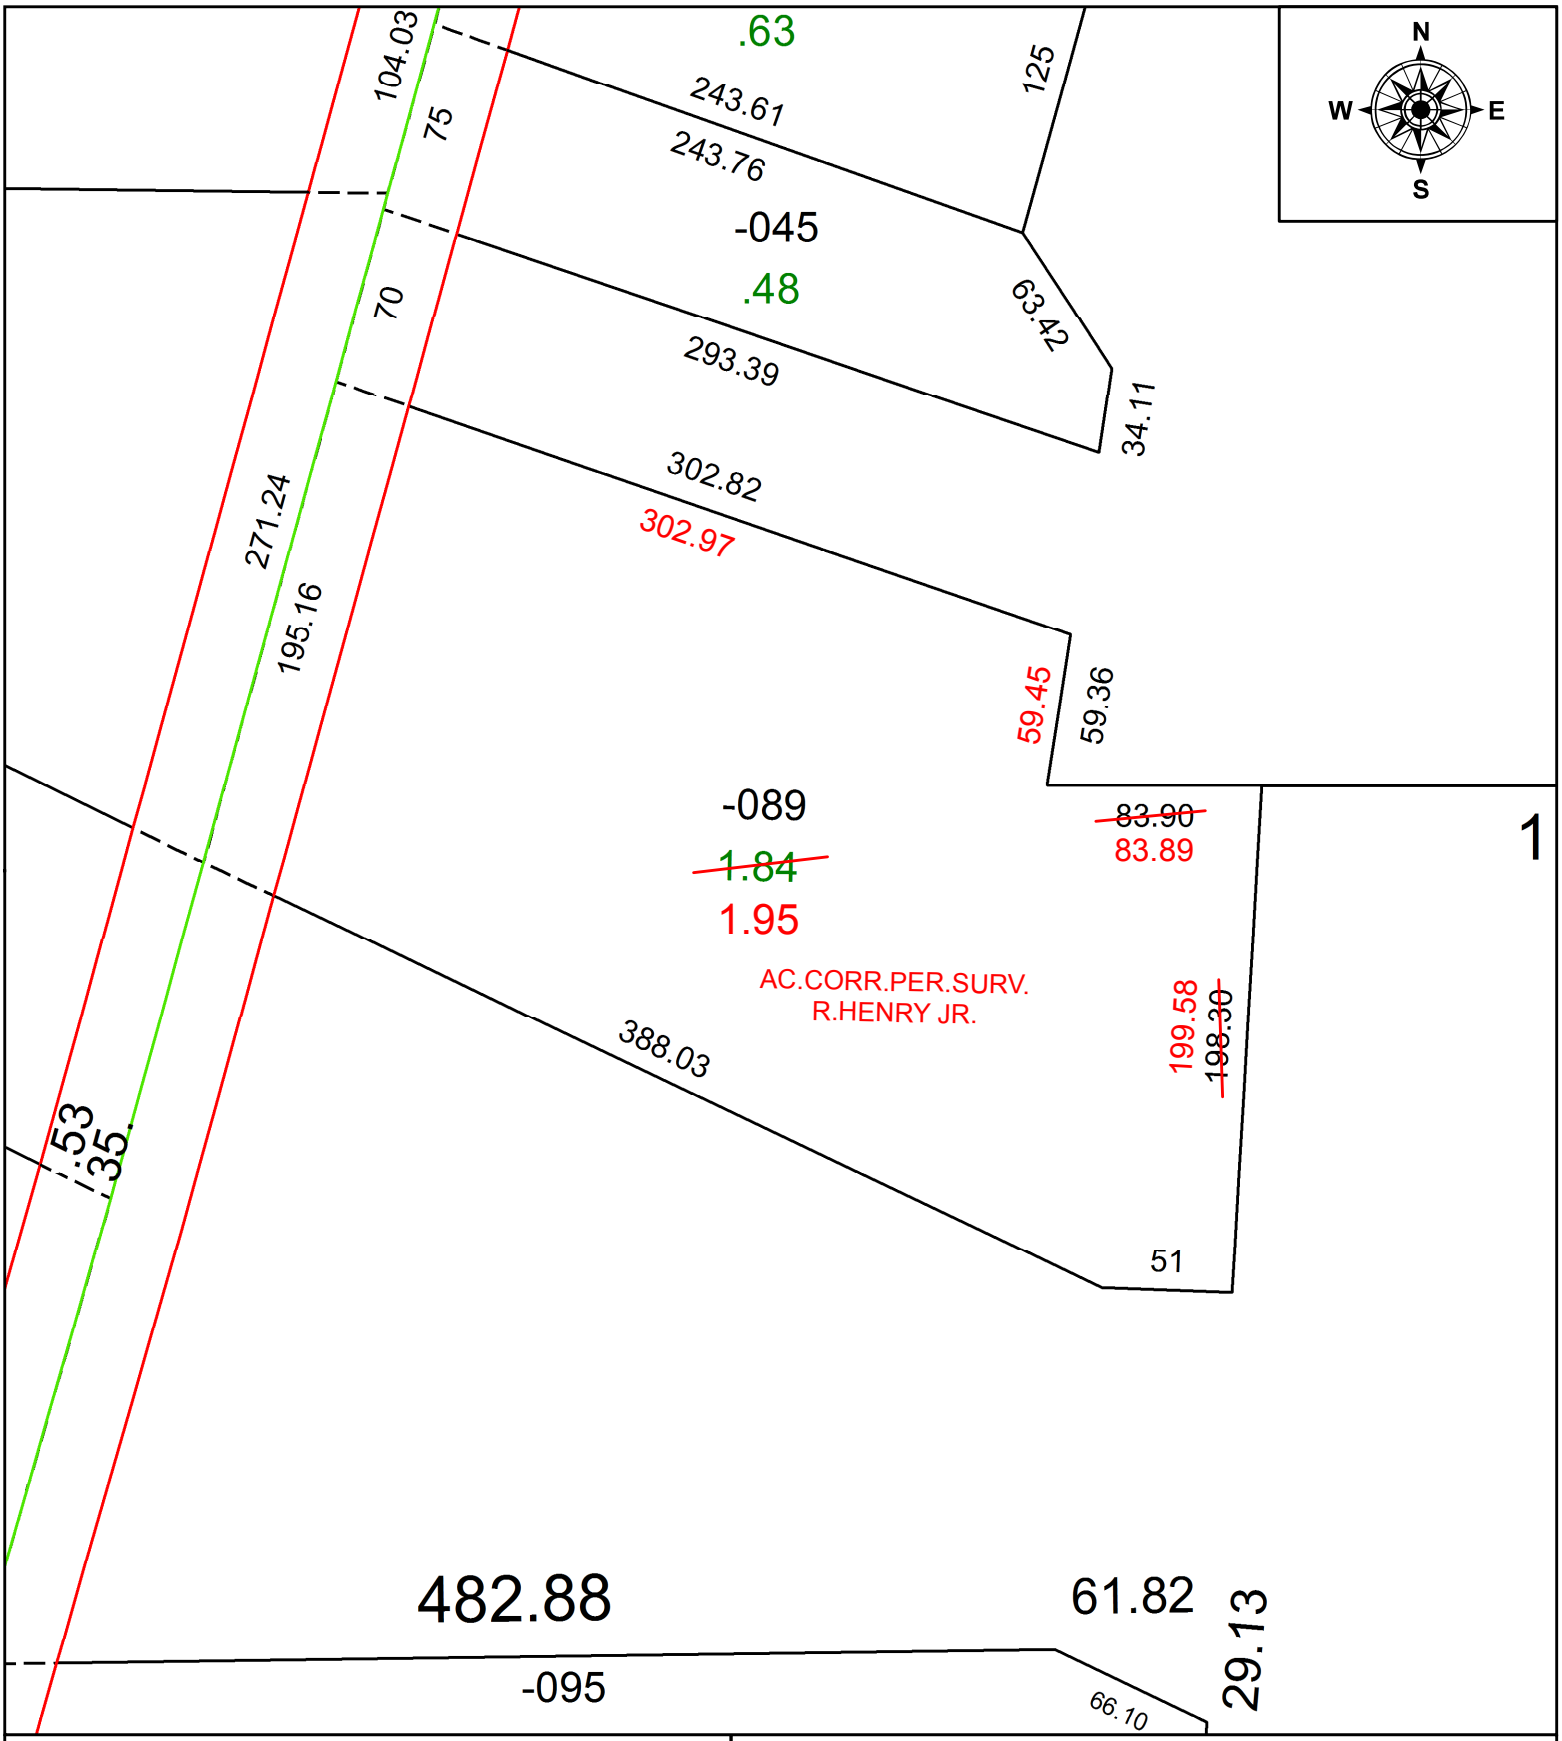

SPLITS/DEEDS PROCESSED

LORAIN COUNTY TAX MAP DEPARTMENT
226 MIDDLE AVE. ELYRIA, OH

SURVEYED BY: RAYMOND HENRY JR.
CLOSURE: 1: 174,389
MAP PAGE(S): 4-00-012
APPOVED BY: RRM **DATE:** 1-20-21
SCALE: 1" = 75 **PRIOR INSTRUMENT:** 20130489525