PARENT PARCEL: 06-21-005-101-026, -041
CHILD PARCEL: 06-21-005-101-054 THRU -056
STARTING POINT: AC CORR PER SURV BY RICHARD A. FREDRICKSON

22-04471

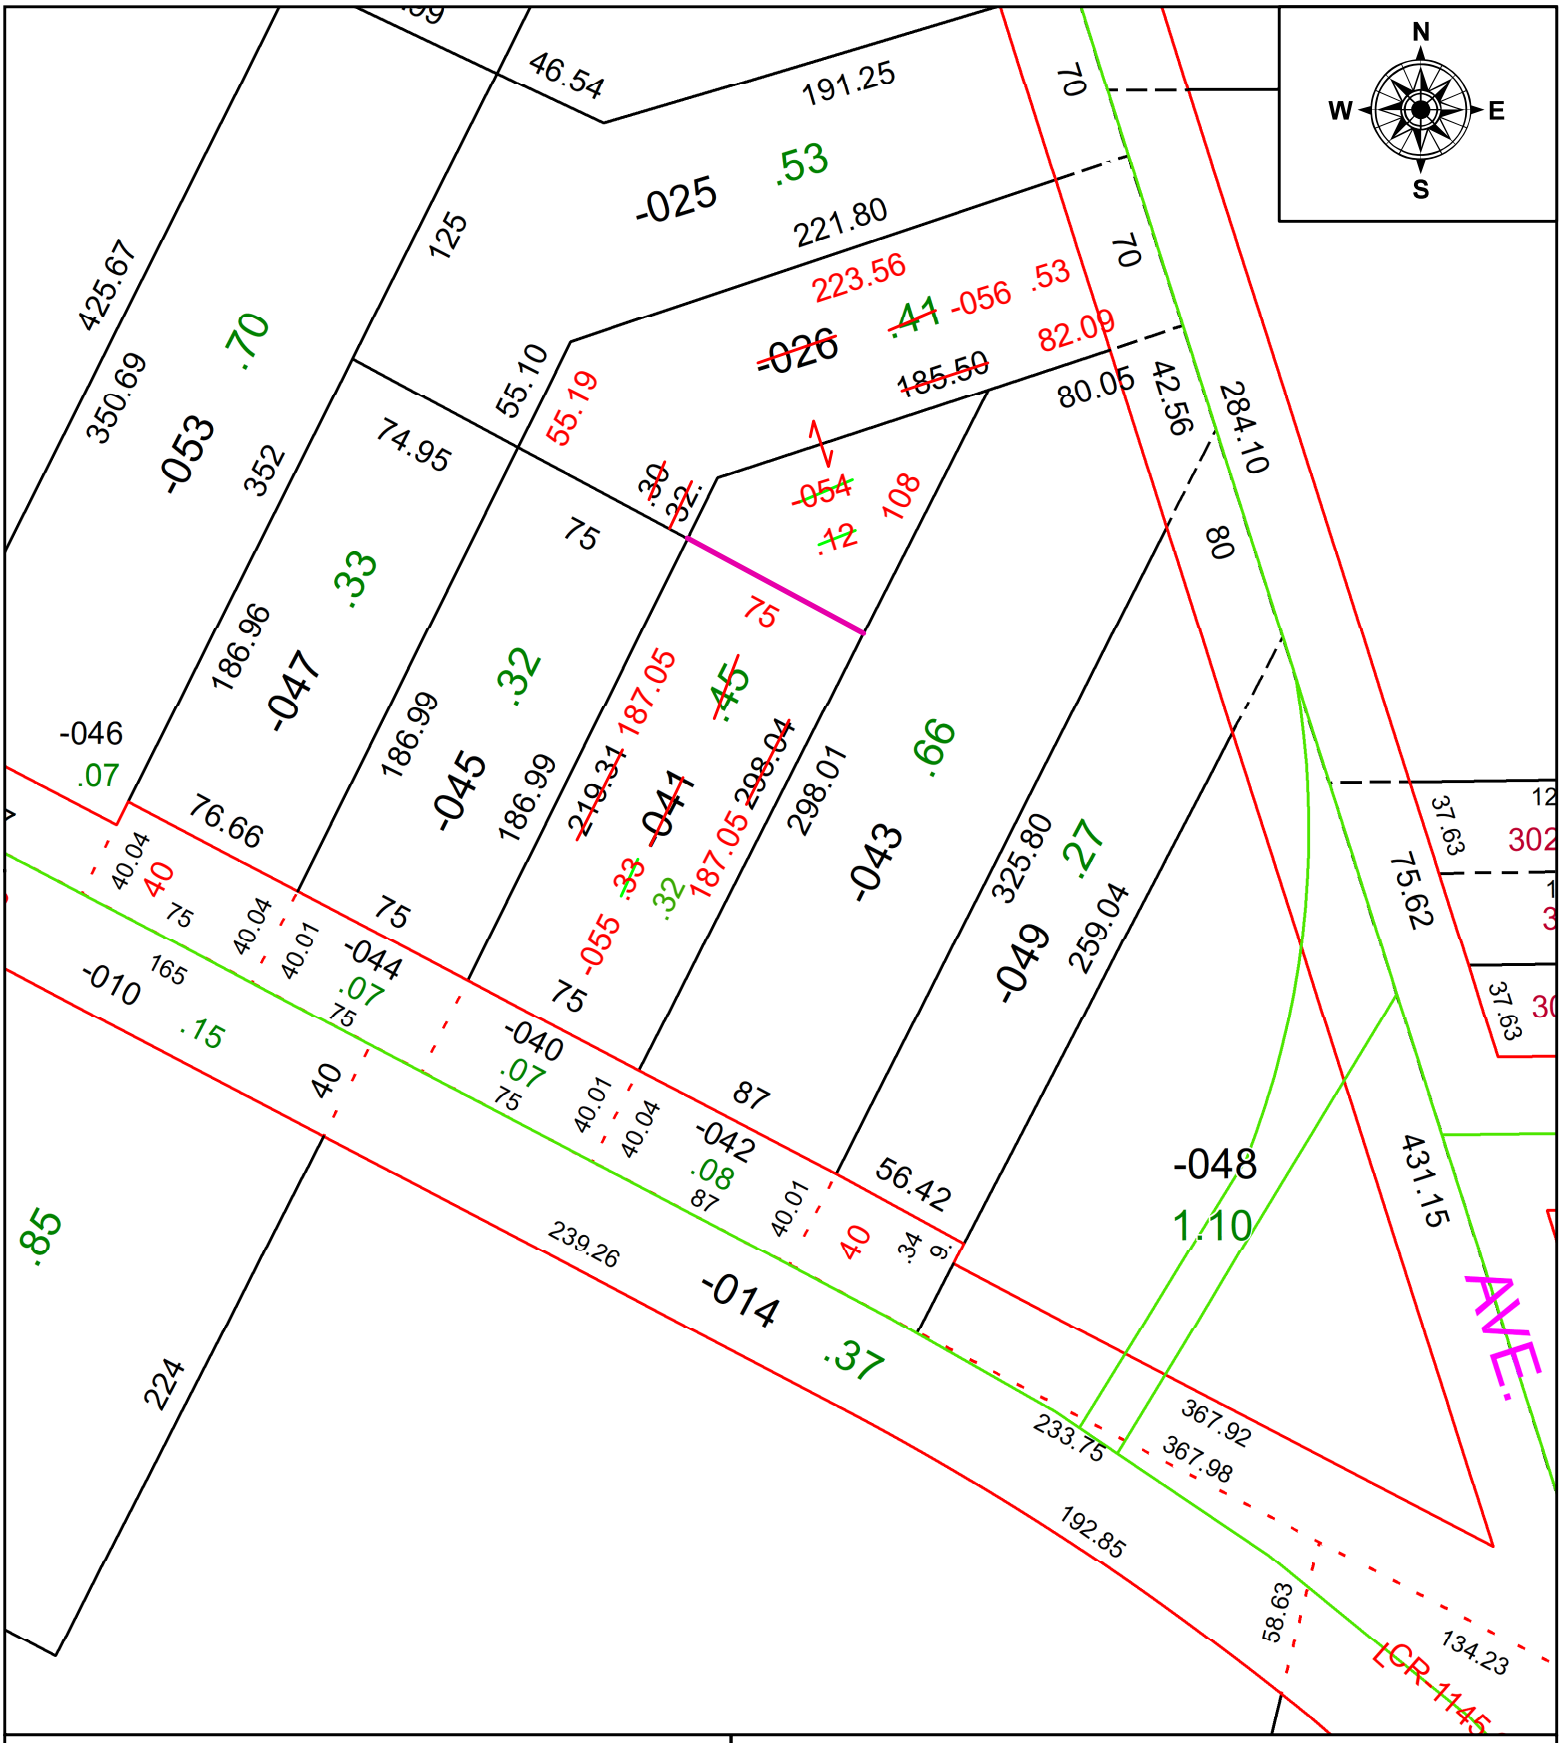

SPLITS/DEEDS PROCESSED
LORAIN COUNTY TAX MAP DEPARTMENT
226 MIDDLE AVE. ELYRIA, OH

SURVEYED BY: RICHARD A. FREDRICKSON
CLOSURE: 1: 100789
MAP PAGE(S): 06-05
APPOVED BY: AC **DATE:** 5/4/2022
SCALE: 1" = 75 **PRIOR INSTRUMENT:** 2019- 0735132