PARENT PARCEL: 21-05-015-000-001 & 21-05-016-000-001

CHILD PARCEL: 21-05-015-000-004 THRU -007, 21-05-016-000-001

STARTING POINT: MONUMENT BOX AT C/L OF GRIGGS RD & SOUTHEASTERLY CORNER OF O.L. 15

22-04475

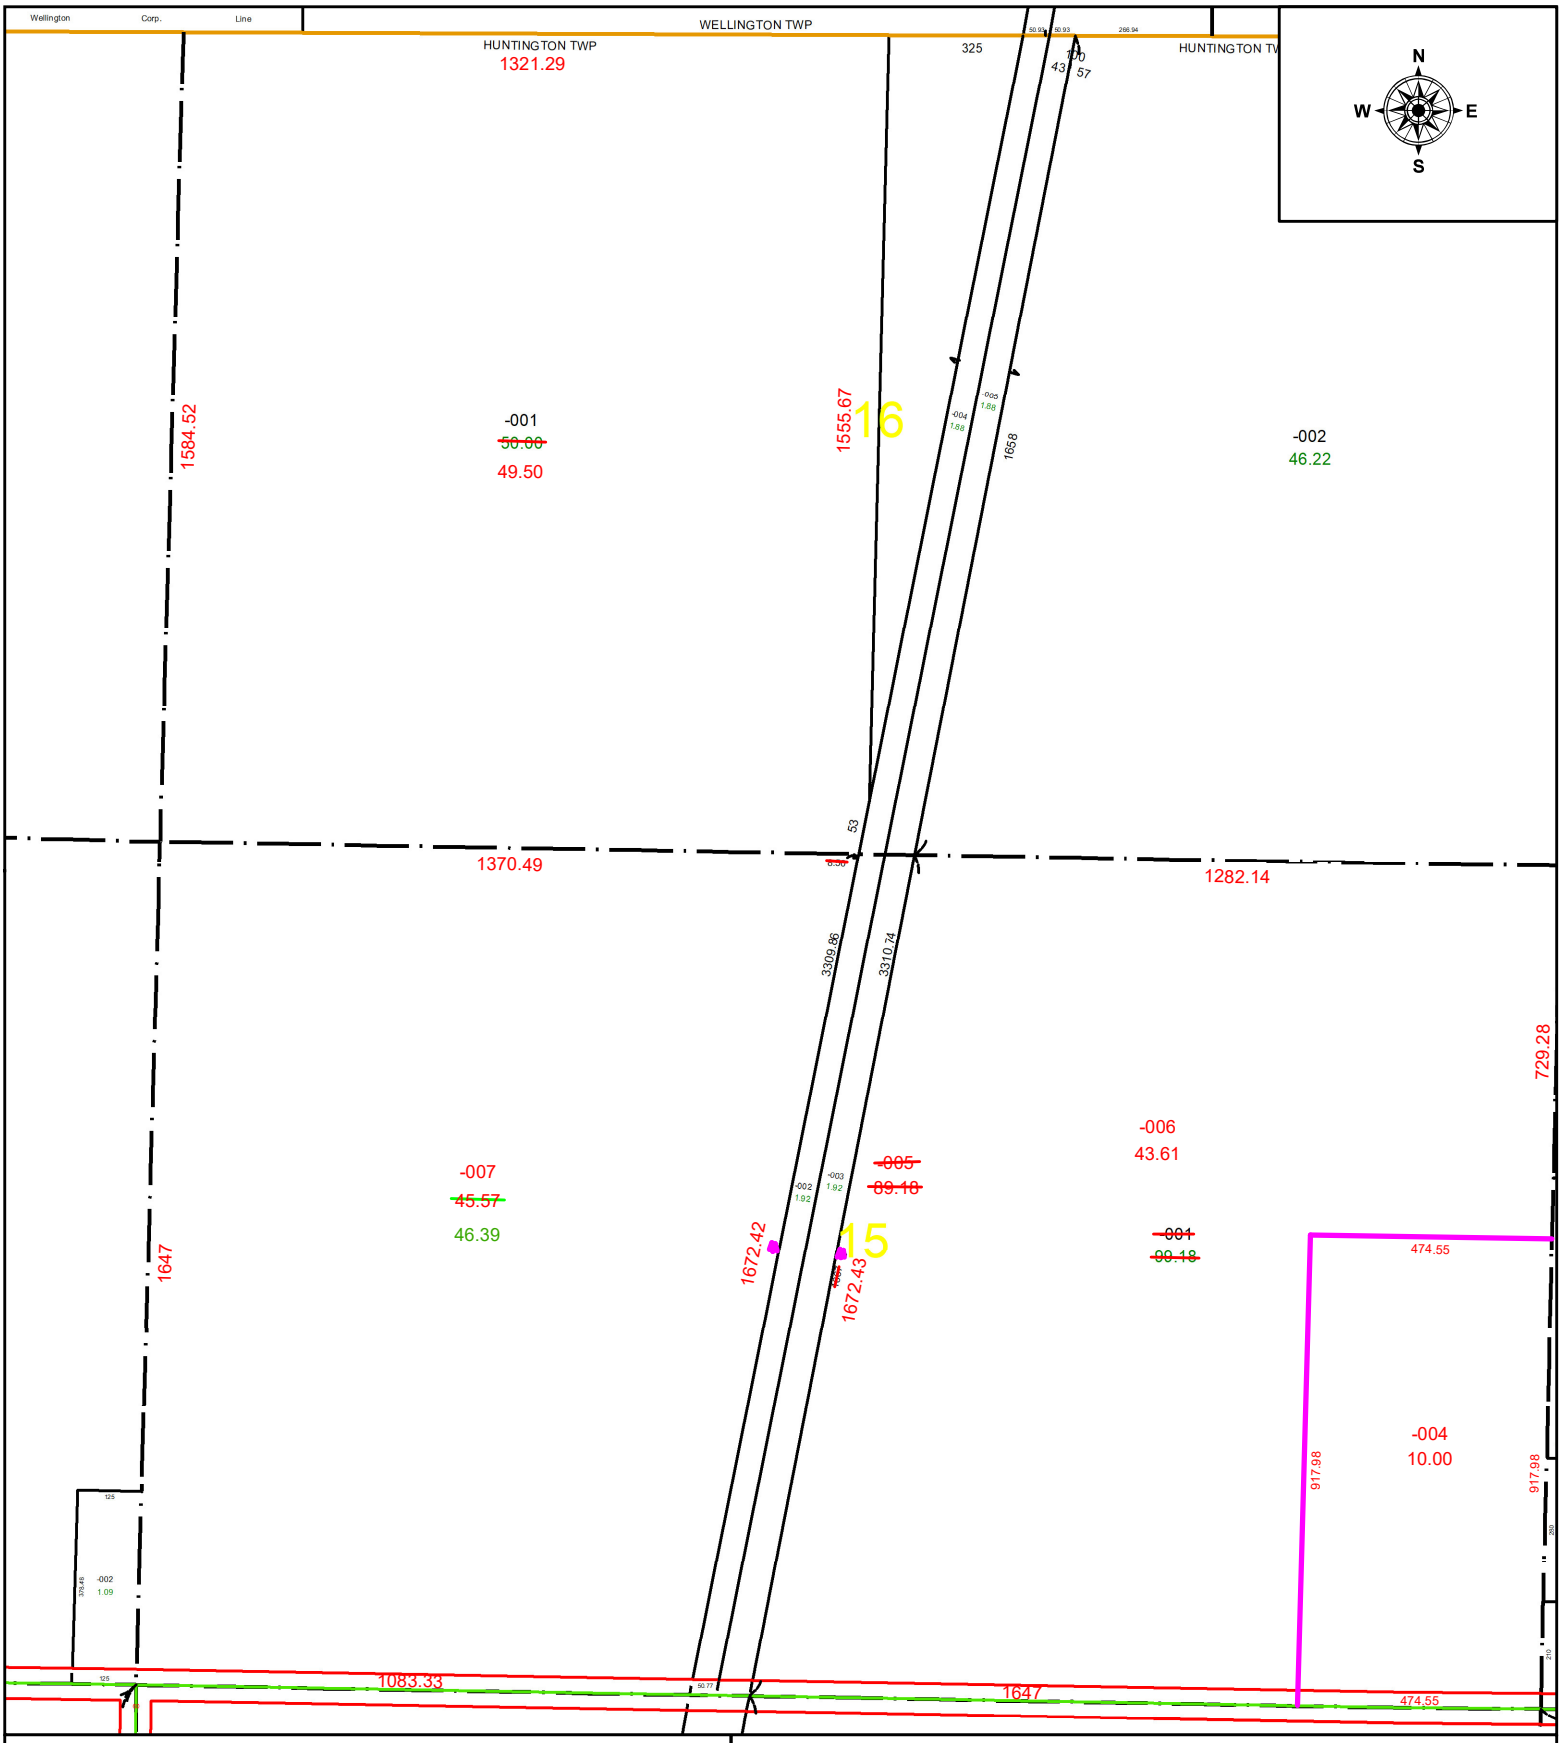

SPLITS/DEEDS PROCESSED

LORAIN COUNTY TAX MAP DEPARTMENT
226 MIDDLE AVE. ELYRIA, OH

SURVEYED BY: TIMOTHY HOZALSKI

CLOSURE: 1: -2147483648

MAP PAGE(S): 21-05-015, 21-05-016

APPOVED BY: WRZ **DATE:** 5/12/2022

SCALE: 1" = 375 **PRIOR INSTRUMENT:** 2009-0302098