PARENT PARCEL: 06-25-081-500-004

CHILD PARCEL: 06-25-067-103-020, 06-25-083-000-011, & 06-25-084-000-004

STARTING POINT: SOUTHWEST CORNER OF S/L 30 IN GEO H. ELY ADMINISTRATOR'S ADDITION

22-04477

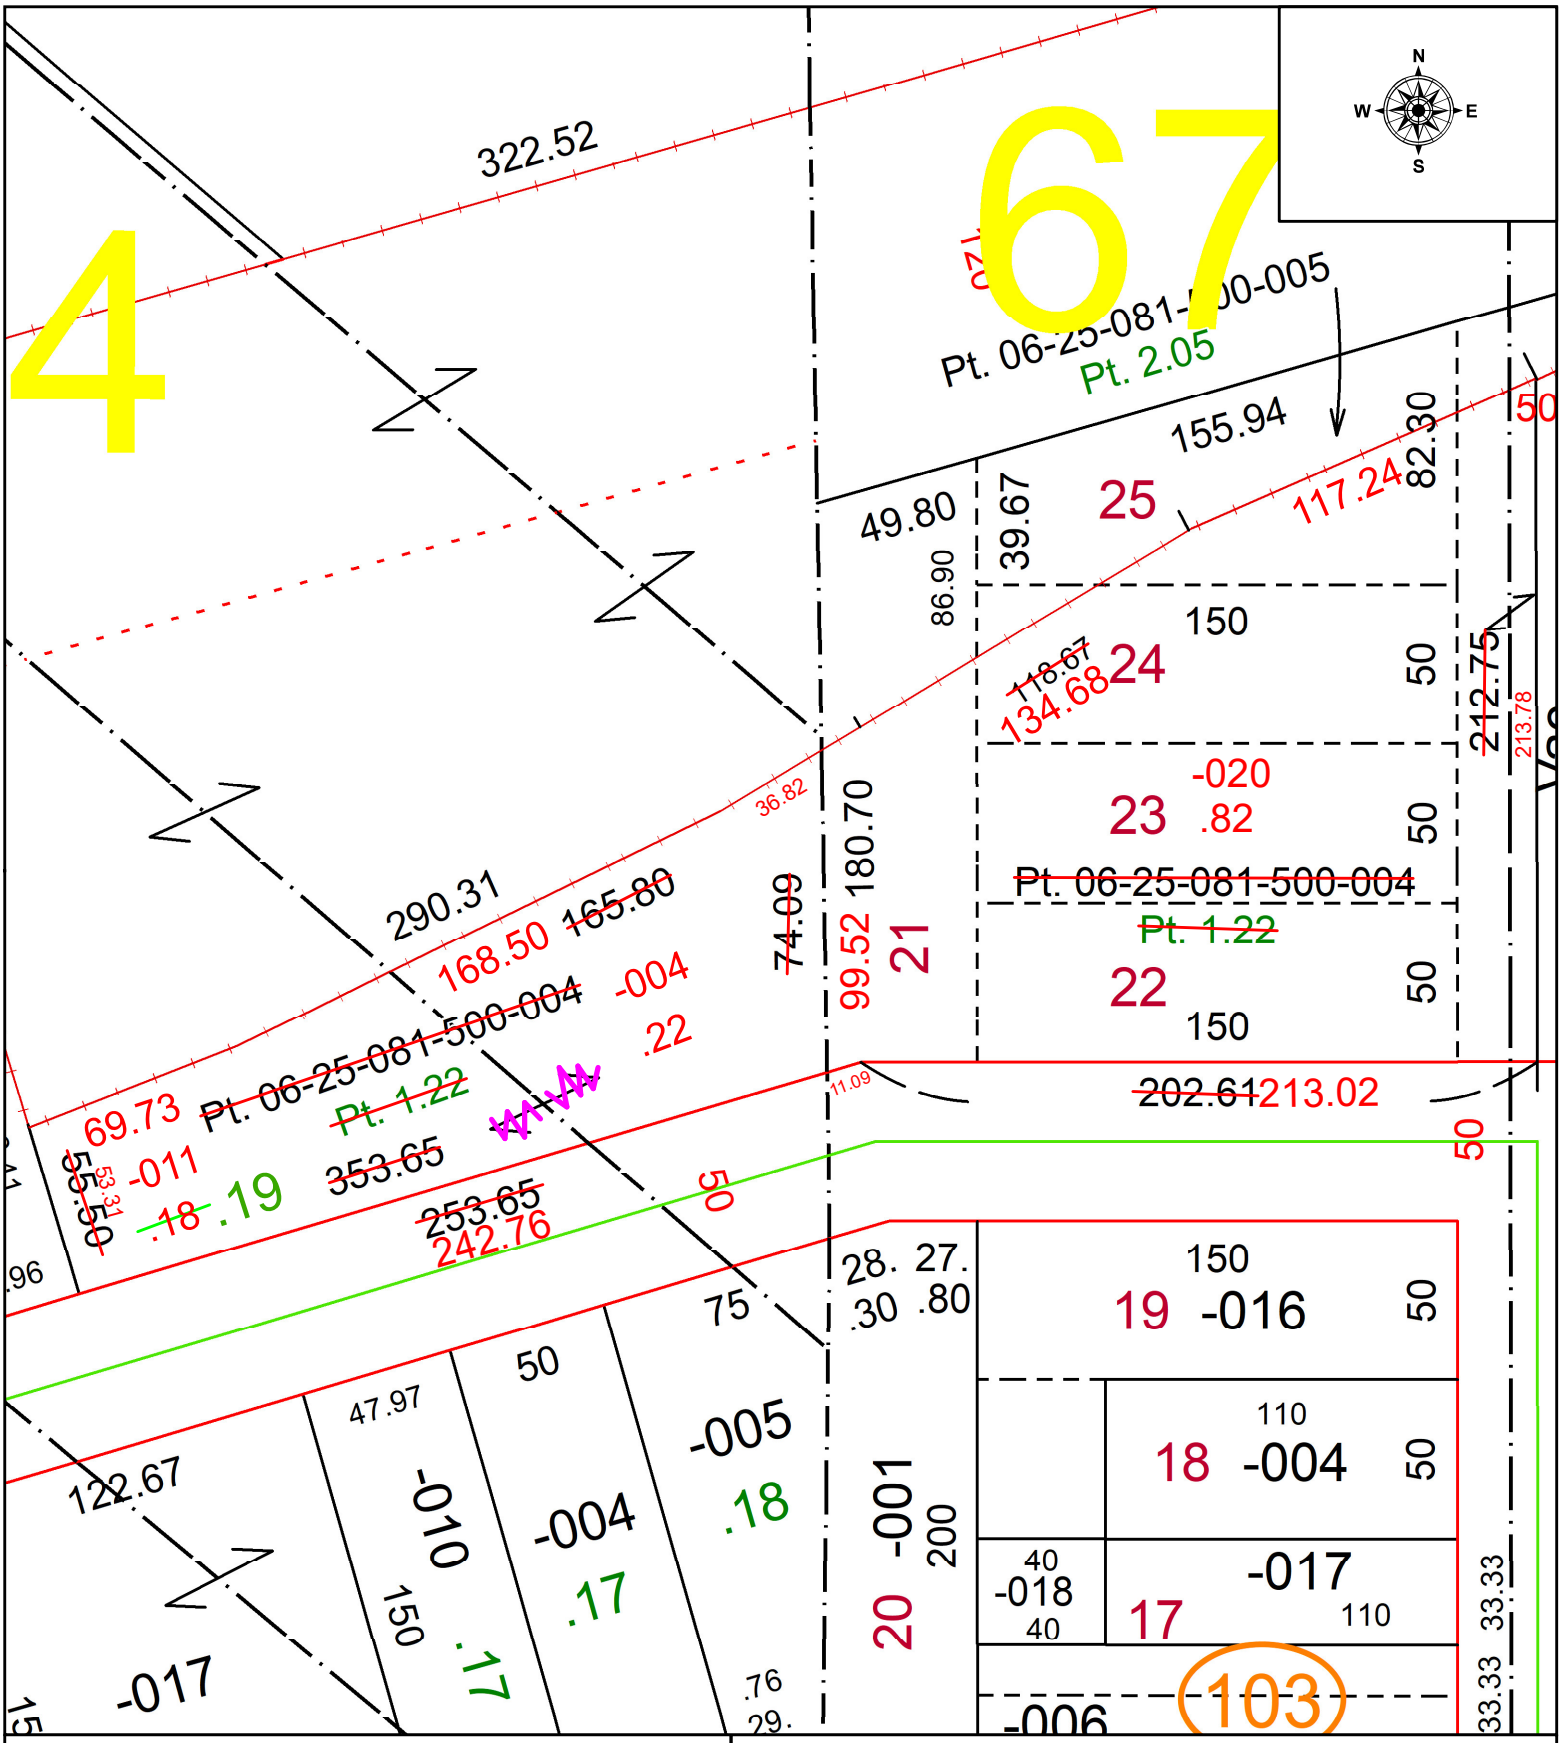

SPLITS/DEEDS PROCESSED

LORAIN COUNTY TAX MAP DEPARTMENT
226 MIDDLE AVE. ELYRIA, OH

SURVEYED BY: JOSHUA RIEDY
CLOSURE: 1: 130049
MAP PAGE(S): 06-25-067, 06-25-081, 06-25-083, 06-25-084
APPOVED BY: WRZ **DATE:** 5/17/2022
SCALE: 1" = 60 **PRIOR INSTRUMENT:** DV 909, PG. 15