PARENT PARCEL: 01-00-021-000-074, -075, -076

CHILD PARCEL: 01-00-021-000-077

STARTING POINT: SE CORNER OF O/L 21 AND N LINE OF SR 2

22-04478

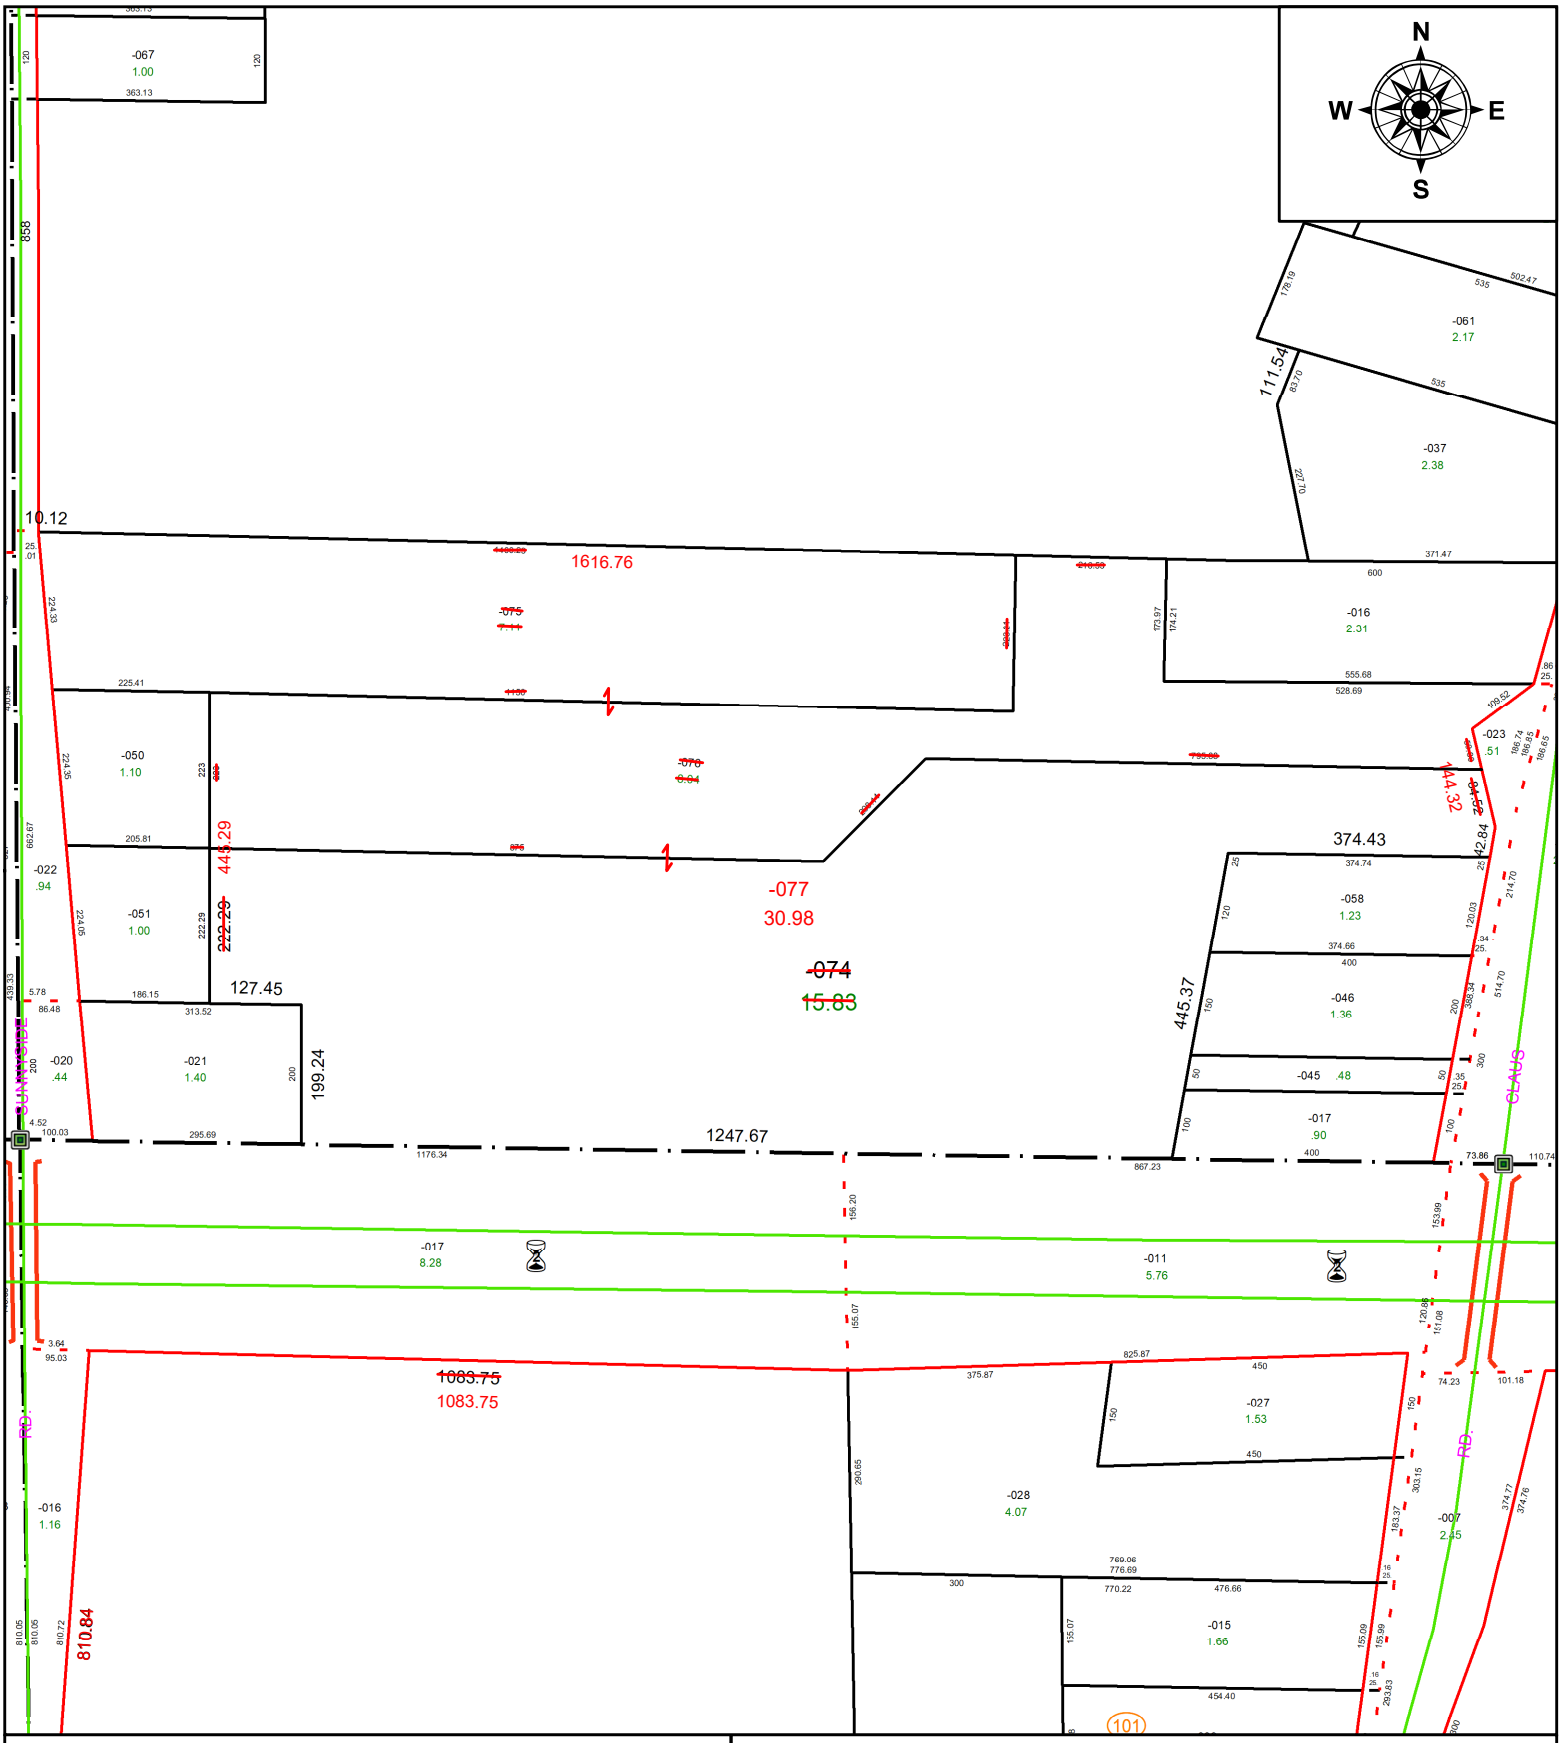

SPLITS/DEEDS PROCESSED

LORAIN COUNTY TAX MAP DEPARTMENT
226 MIDDLE AVE. ELYRIA, OH

SURVEYED BY: JOHN A. DECHANT JR.

CLOSURE: 1: 23422

MAP PAGE(S): 01-00-021-A, B

APPOVED BY: AC **DATE:** 5/16/2022

SCALE: 1" = 275 **PRIOR INSTRUMENT:** 2021- 0856436