PARENT PARCEL: 04-00-007-101-009 & -010

CHILD PARCEL: 04-00-007-101-055 THRU -057 ACREAGE CORRECTION PER JAMES SAYLER

STARTING POINT: INTERSECTION OF C/LS OF MOORE RD & LAKE RD

22-04480

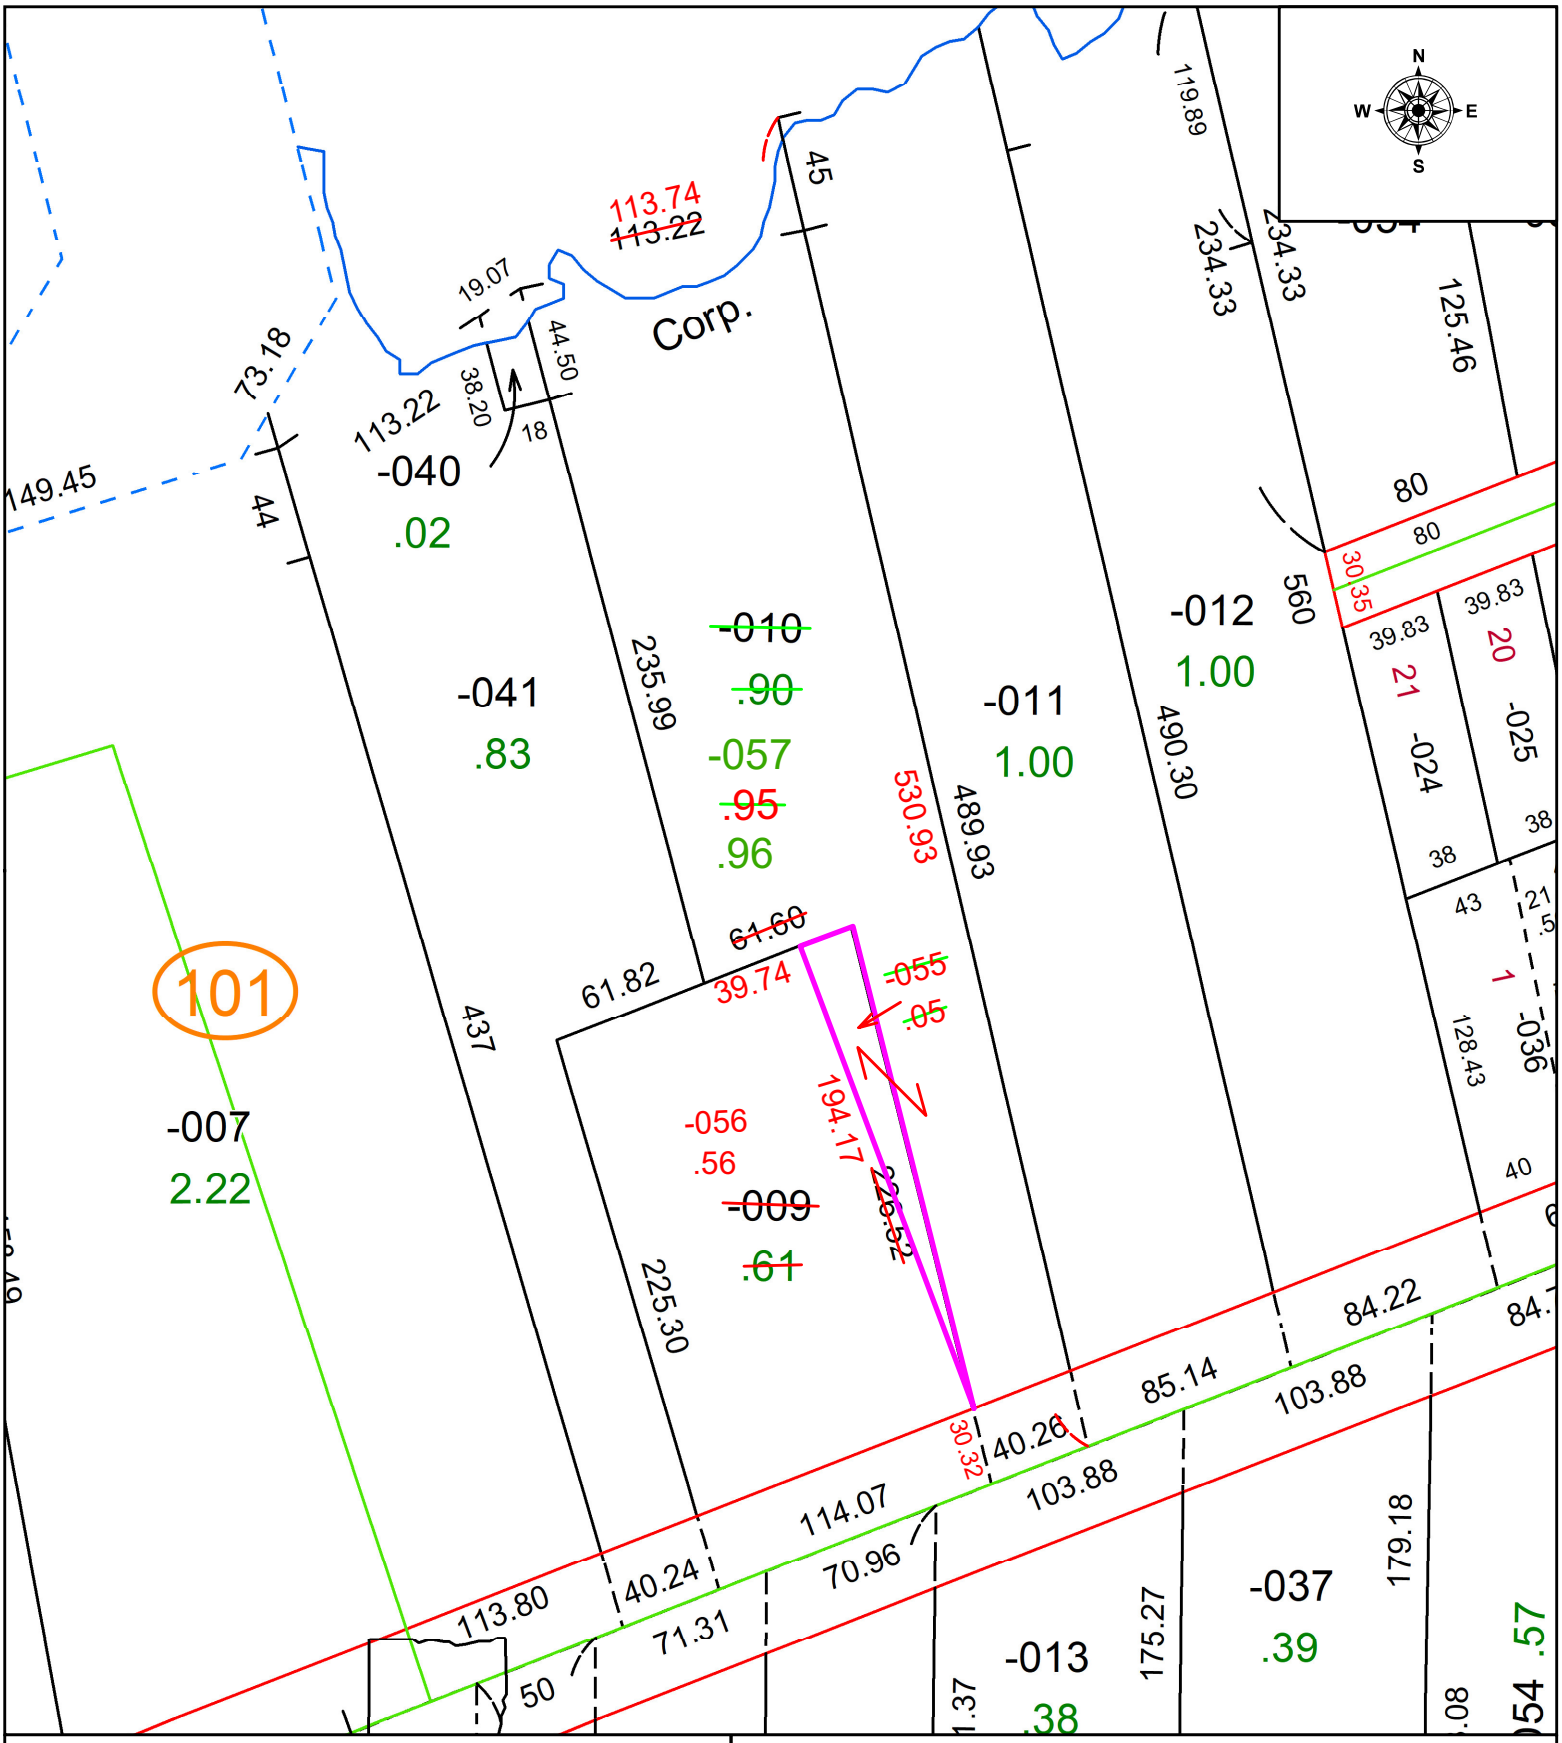

SPLITS/DEEDS PROCESSED

LORAIN COUNTY TAX MAP DEPARTMENT
226 MIDDLE AVE. ELYRIA, OH

SURVEYED BY: JAMES SAYLER
CLOSURE: 1: 137730
MAP PAGE(S): 04-00-007
APPOVED BY: WRZ **DATE:** 5/20/2022
SCALE: 1" = 75 **PRIOR INSTRUMENT:** 2022-0857245