PARENT PARCEL: 04-00-007-150-036, -037
CHILD PARCEL: 04-00-007-150-303 & -304
STARTING POINT: AC CORR PER SURV BY AMY M. KELLY

22-04481

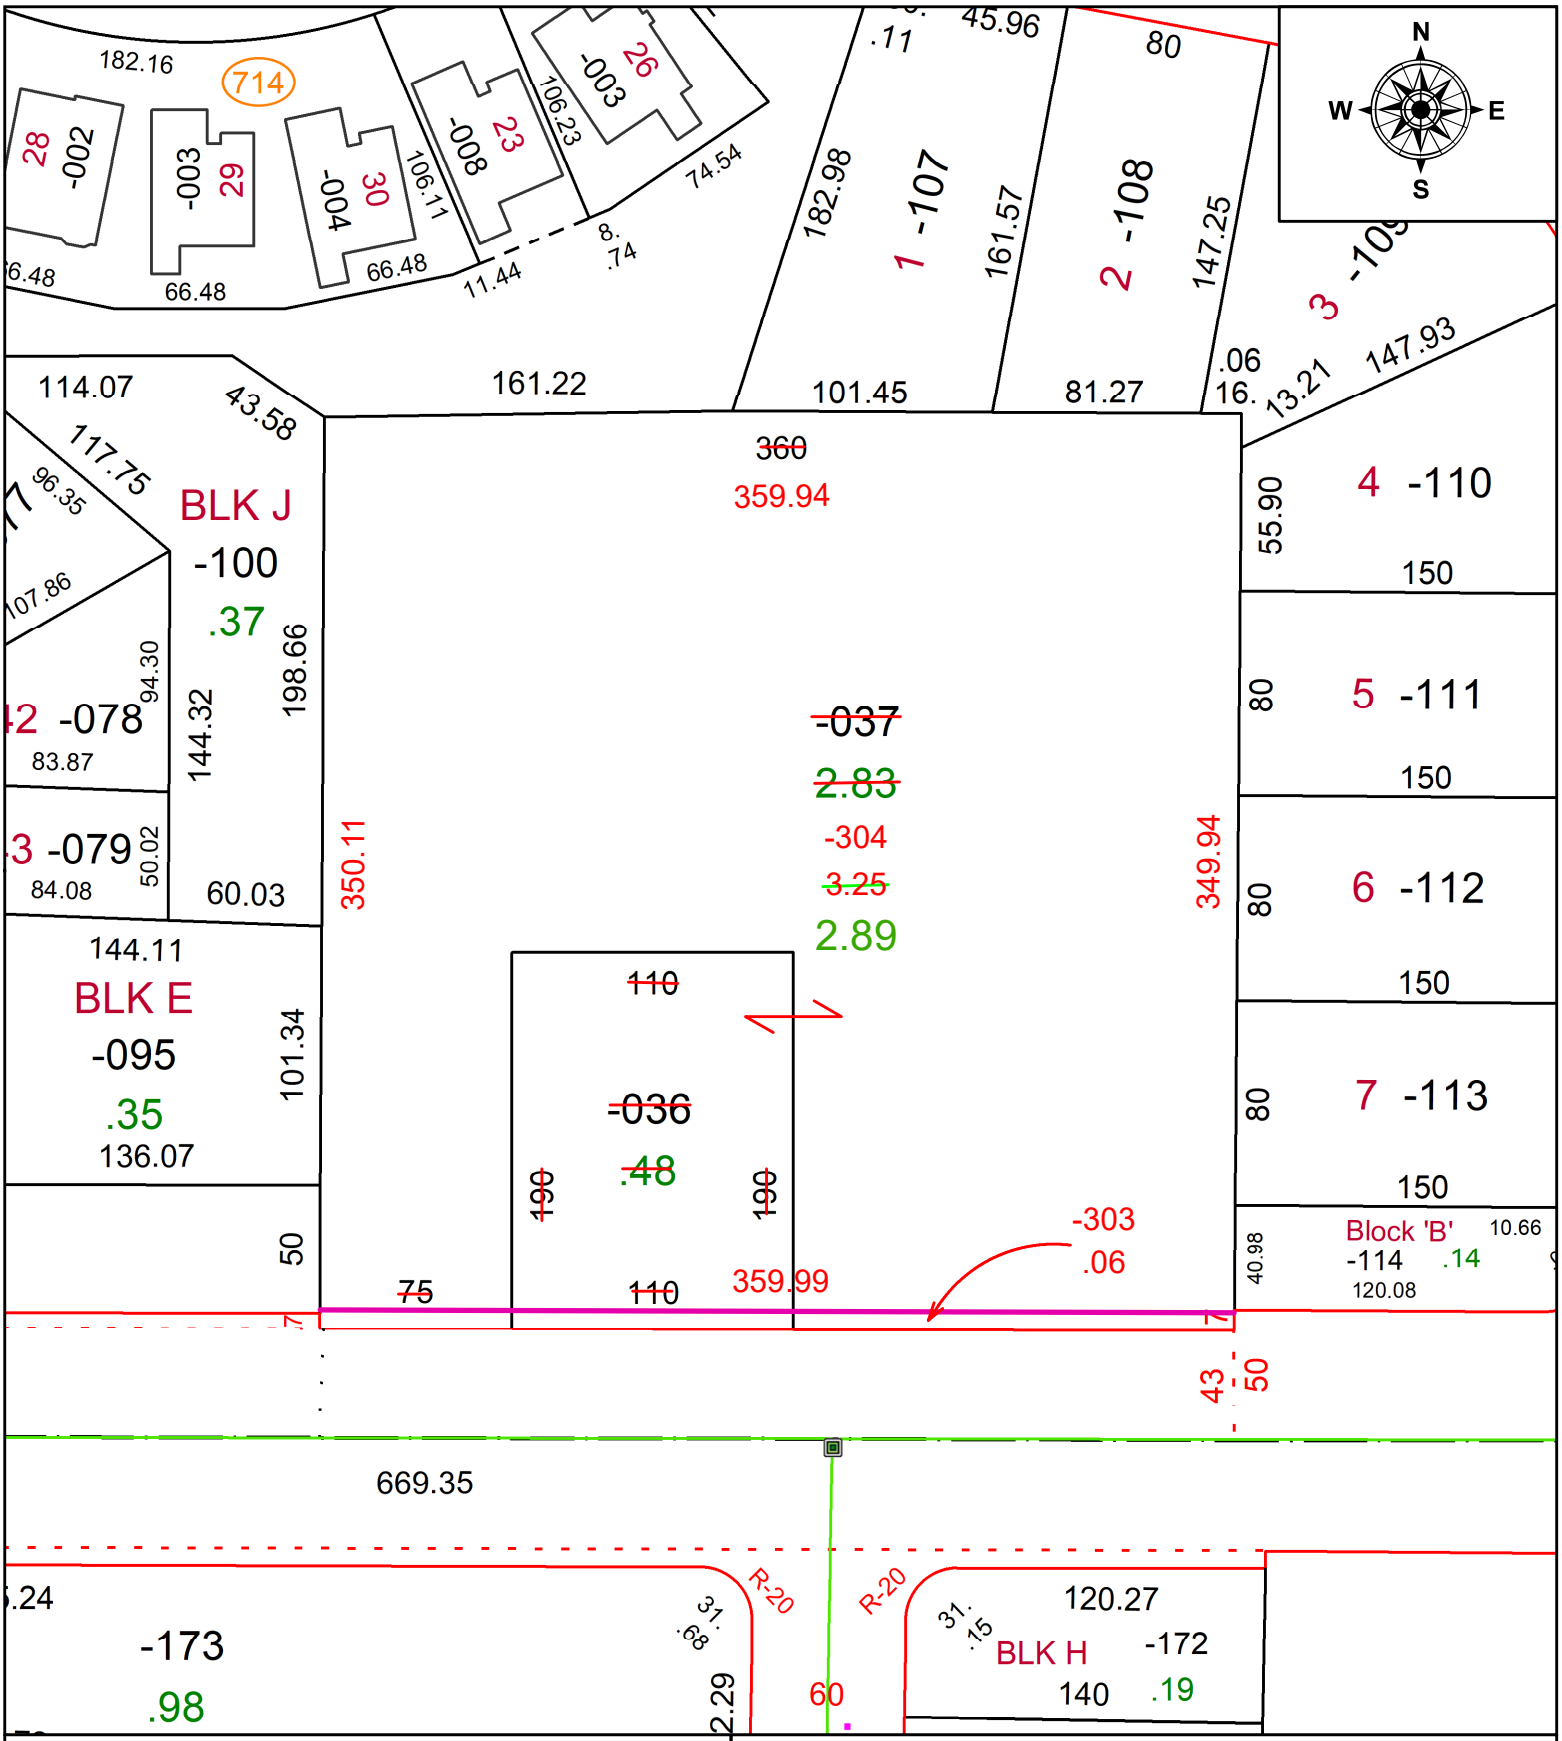

SPLITS/DEEDS PROCESSED
LORAIN COUNTY TAX MAP DEPARTMENT
226 MIDDLE AVE. ELYRIA, OH

SURVEYED BY: AMY M. KELLY
CLOSURE: 1: 865109
MAP PAGE(S): 04-00-007-G
APPOVED BY: AC **DATE:** 5/19/2022
SCALE: 1" = 75 **PRIOR INSTRUMENT:** 2017- 0636782