PARENT PARCEL: 14-00-037-000-022

CHILD PARCEL:

STARTING POINT: INTERSECTION OF C/L OF HALLAUER RD, AND SOUTH LINE OF O.L.37

21-04483-A

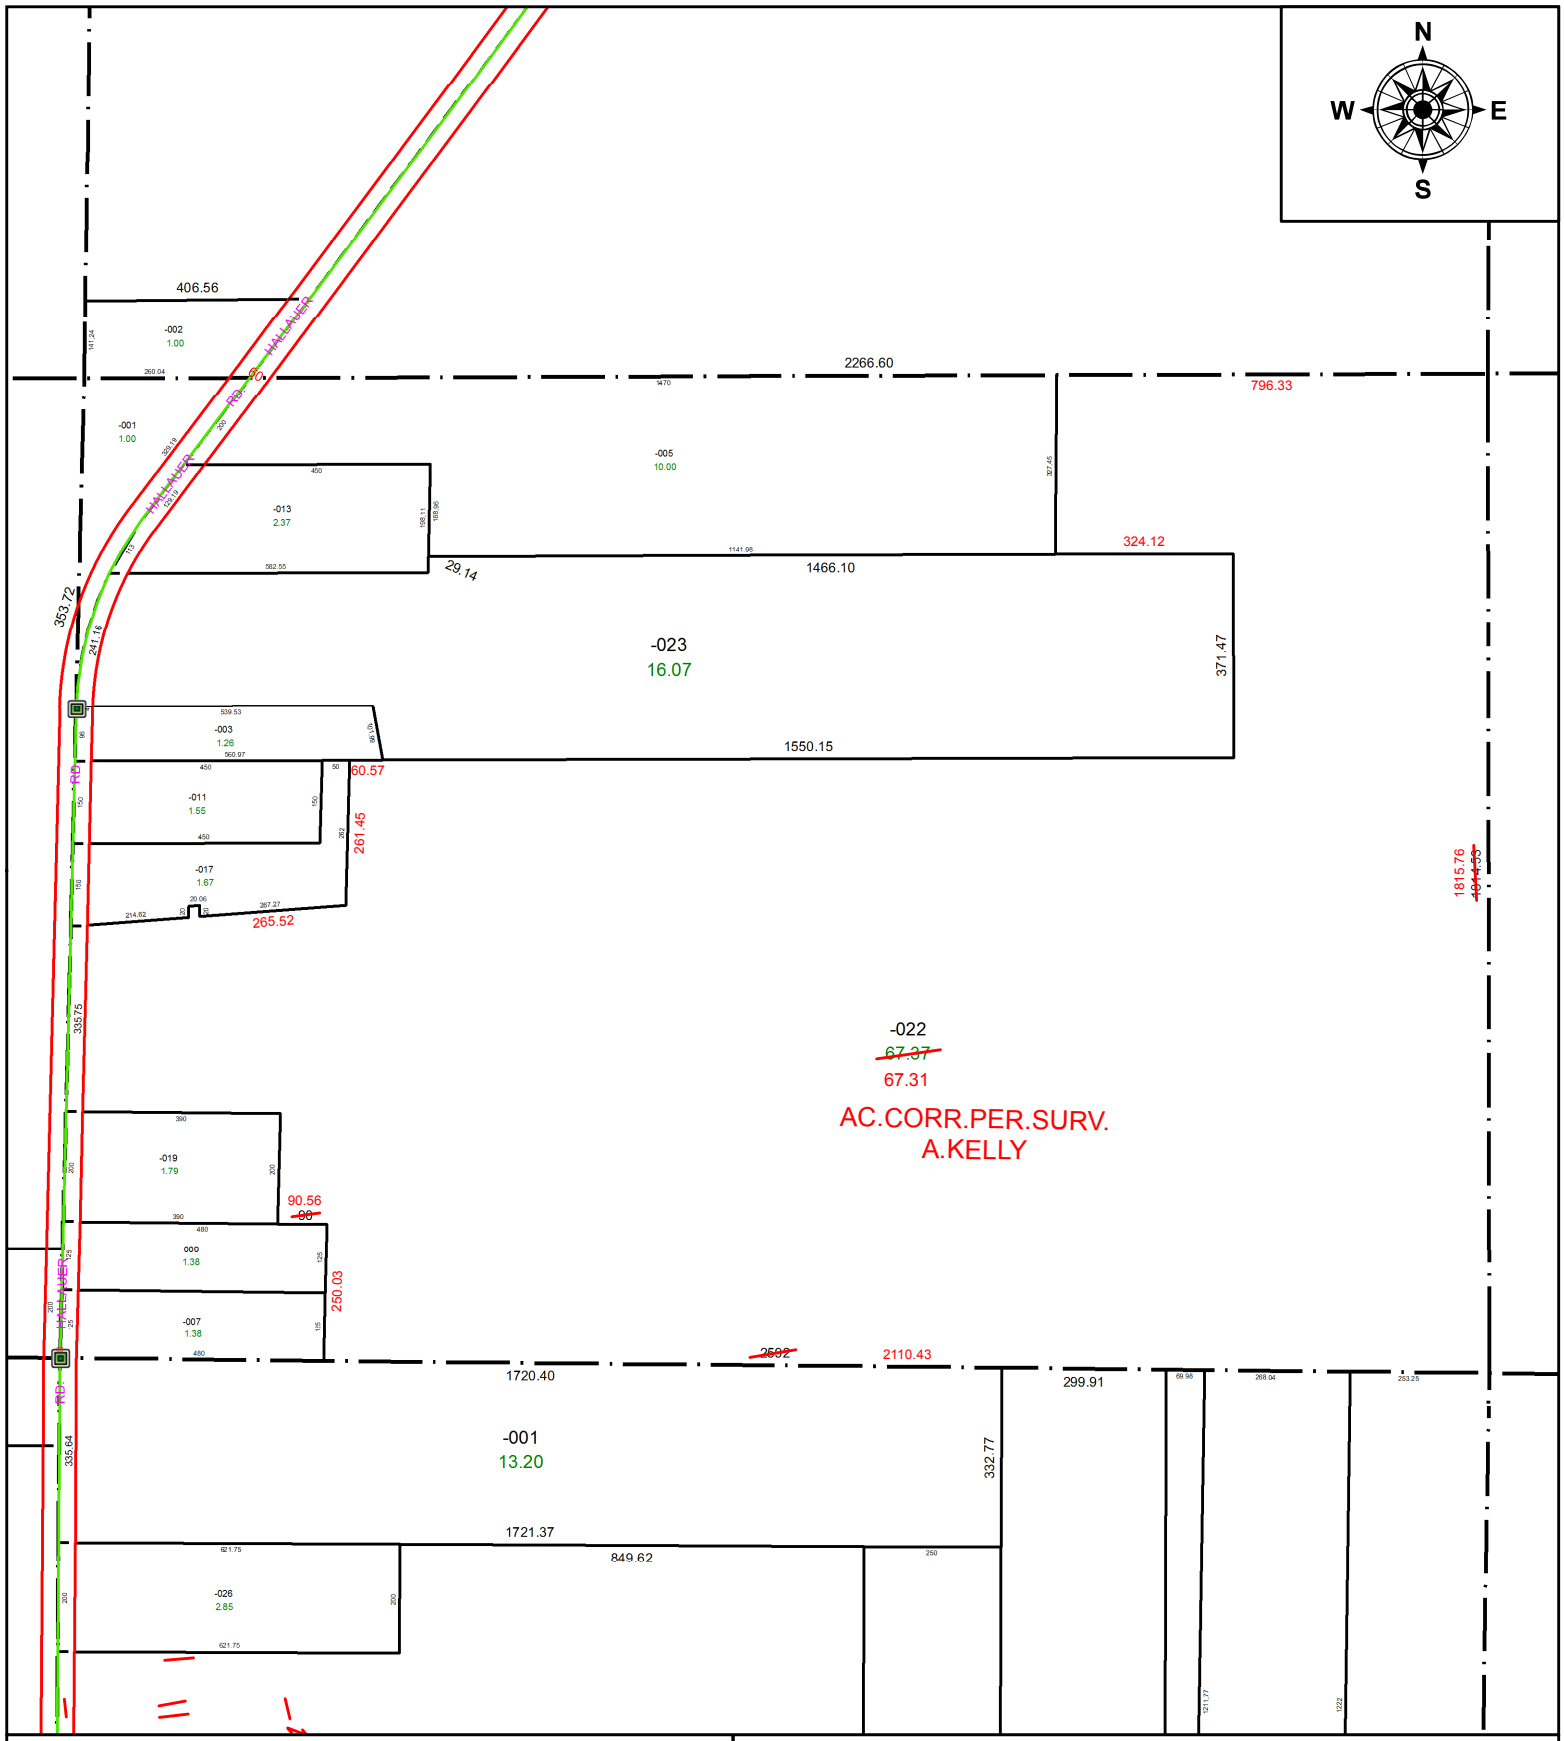

SPLITS/DEEDS PROCESSED

LORAIN COUNTY TAX MAP DEPARTMENT
226 MIDDLE AVE. ELYRIA, OH

SURVEYED BY: AMY M. KELLY
CLOSURE: 1: 2,258,524
MAP PAGE(S): 14-00-037
APPOVED BY: RRM **DATE:** 1-29-21
SCALE: 1" = 350 **PRIOR INSTRUMENT:** 20150566476