PARENT PARCEL: 07-00-039-000-078

CHILD PARCEL:

STARTING POINT: INTERSECTION OF C/L OF CENTER RIDGE RD. AND C/L OF RACE RD.

21-04484-A

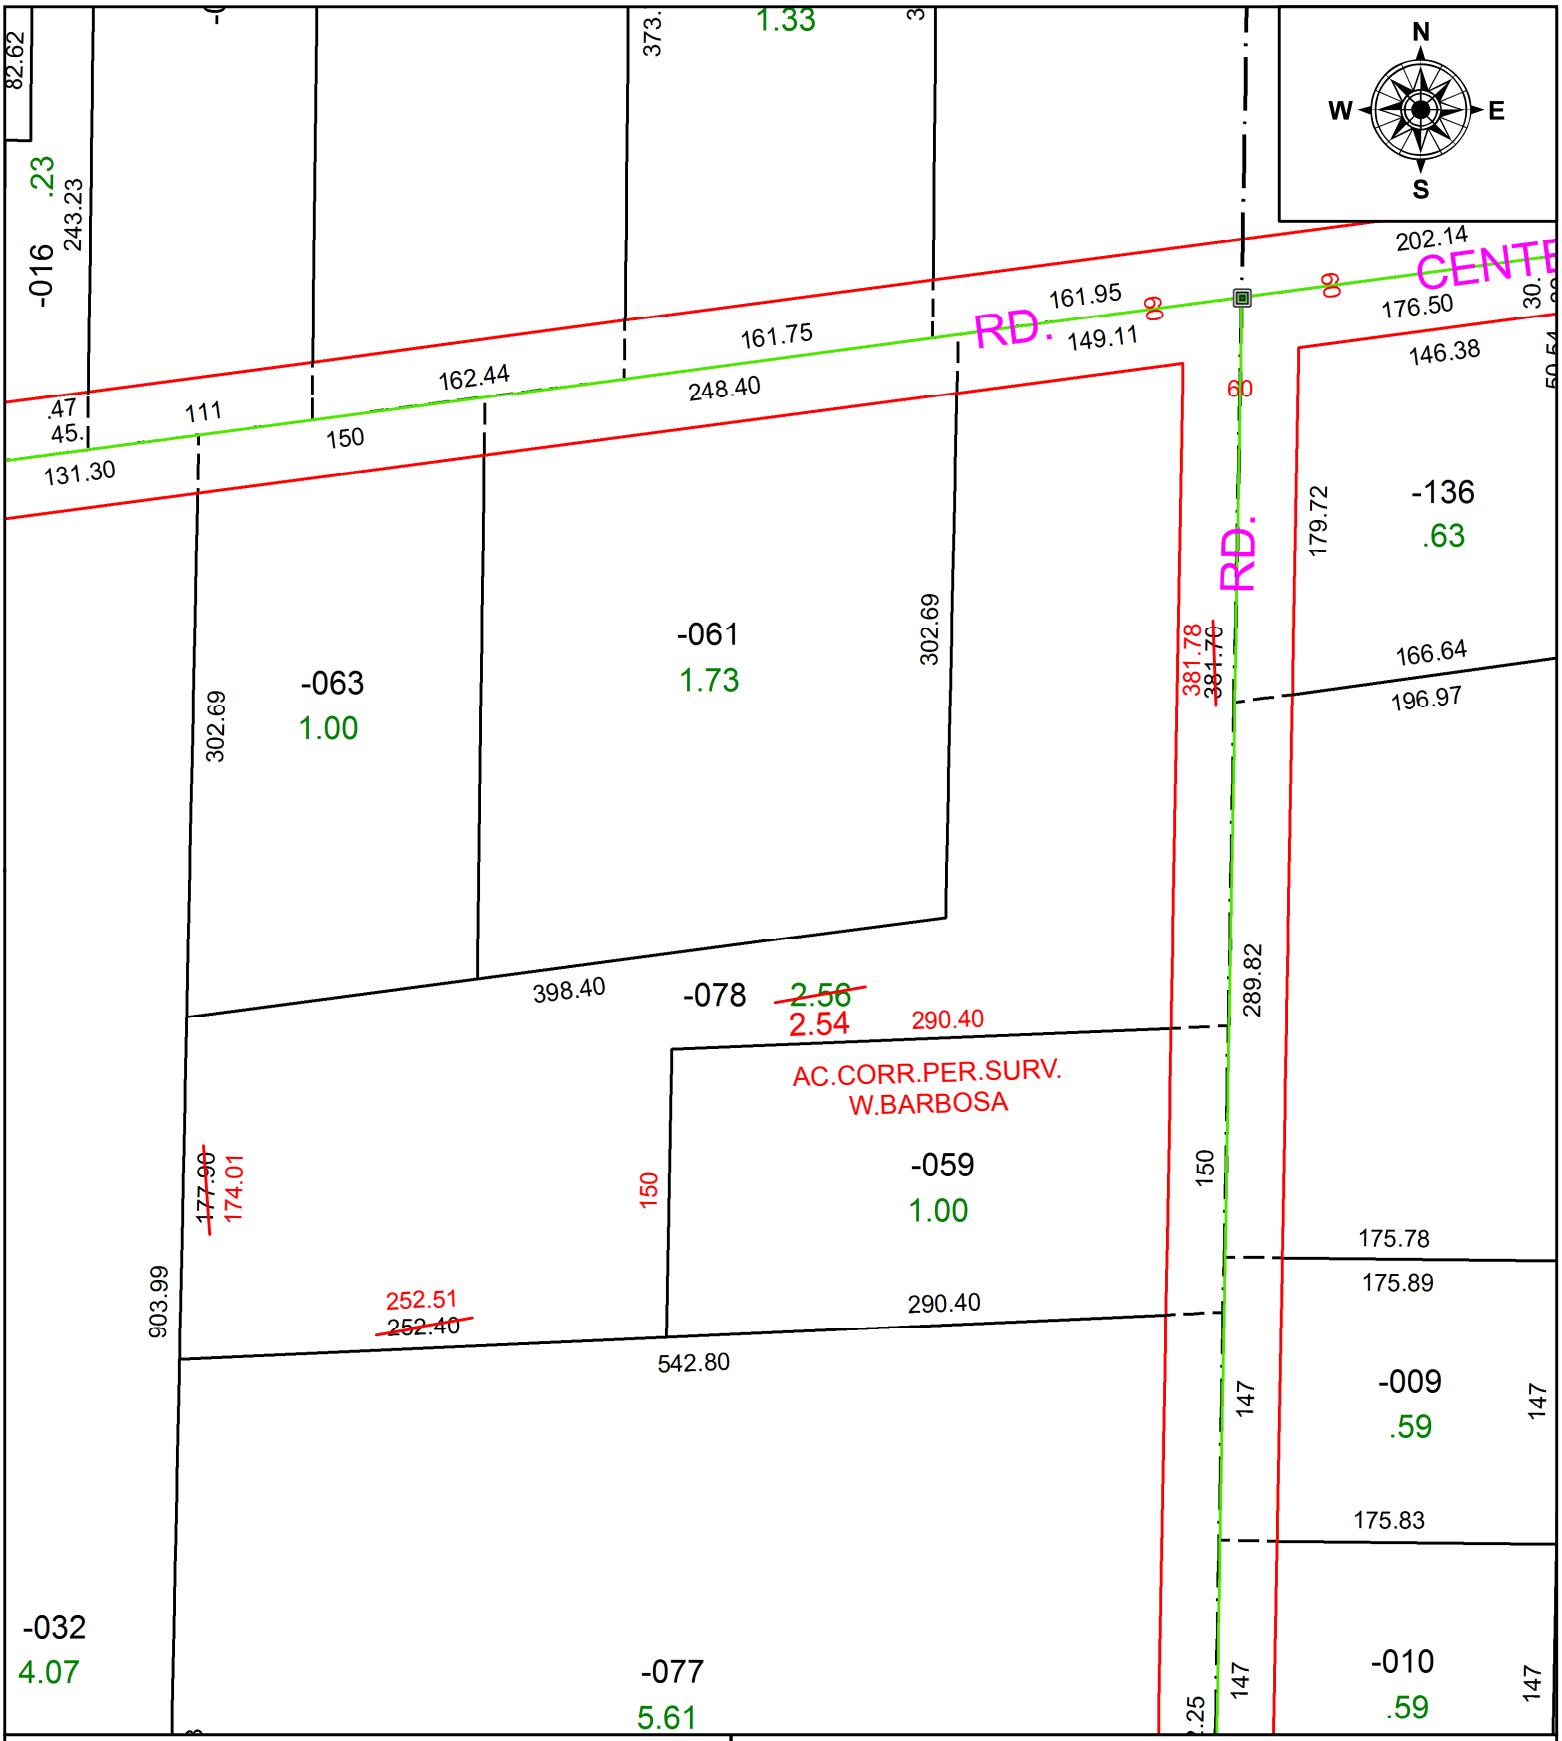

SPLITS/DEEDS PROCESSED

LORAIN COUNTY TAX MAP DEPARTMENT
226 MIDDLE AVE. ELYRIA, OH

SURVEYED BY: WILFREDO BARBOSA
CLOSURE: 1:240,371
MAP PAGE(S): 7-00-039
APPOVED BY: RRM **DATE:** 2-3-21
SCALE: 1" = 100 **PRIOR INSTRUMENT:** 20150532422